


APPLICATION FOR AMENDMENT TO A SALMON SETNET LEASE

David A. Chartier

ADL 225421

Proposed amendment for three set gillnets, 210 feet in length, located in Kachemak Bay, on the western shore of Seldovia Bay, south of Point Naskowhak, within protracted Section 30, Township 8 South, Range 14 West, Seward Meridian, Alaska.


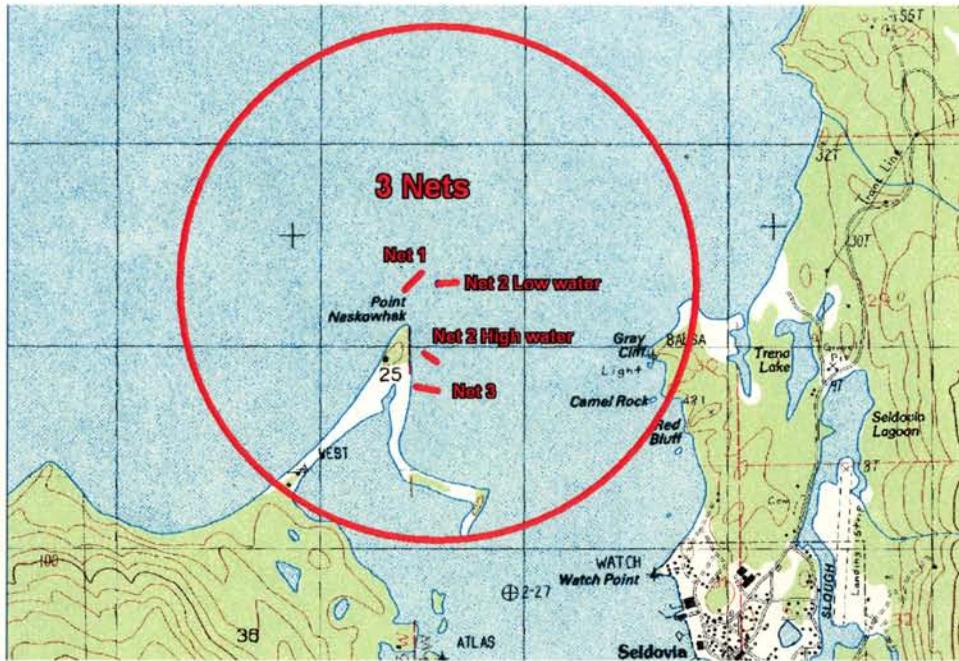


Vicinity Map



ADL 225421

AMENDMENT APPLICATION FOR SHORE FISH LEASE

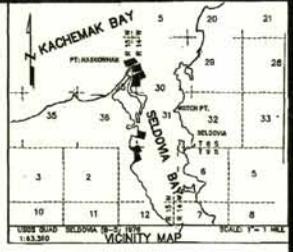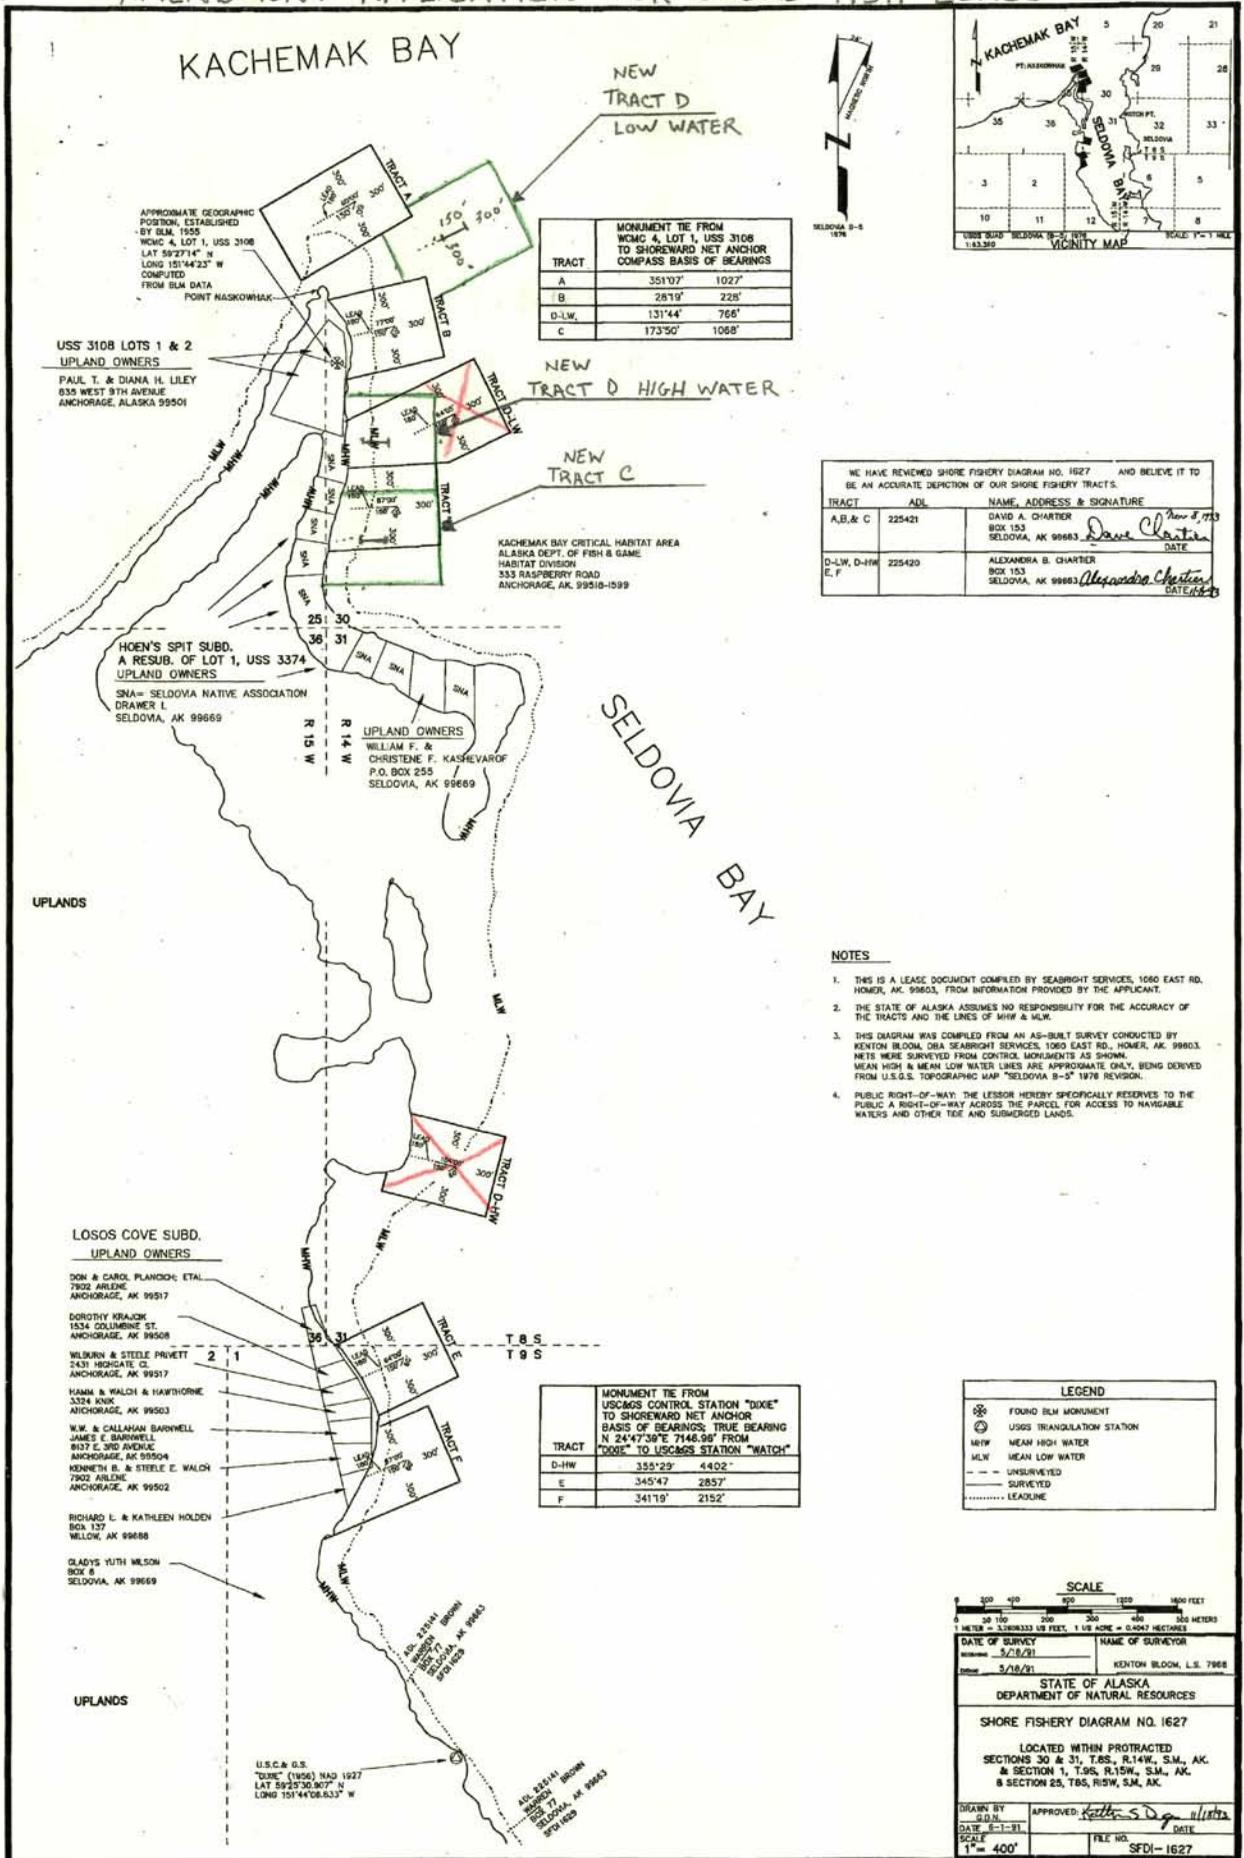

WE HAVE REVIEWED SHORE FISHERY DIAGRAM NO. 1627 AND BELIEVE IT TO BE AN ACCURATE DEPICTION OF OUR SHORE FISHERY TRACTS.

- NOTES**
- THIS IS A LEASE DOCUMENT COMPILED BY SEABRIGHT SERVICES, 1060 EAST RD. HOMER, AK. 99603, FROM INFORMATION PROVIDED BY THE APPLICANT.
 - THE STATE OF ALASKA ASSUMES NO RESPONSIBILITY FOR THE ACCURACY OF THE TRACTS AND THE LINES OF MHW & MLW.
 - THIS DIAGRAM WAS COMPILED FROM AN AS-BUILT SURVEY CONDUCTED BY KENTON BLOOM DBA SEABRIGHT SERVICES, 1060 EAST RD., HOMER, AK. 99603. NETS WERE SURVEYED FROM CONTROL MONUMENTS AS SHOWN. MEAN HIGH & MEAN LOW WATER LINES ARE APPROXIMATE ONLY, BEING DERIVED FROM U.S.G.S. TOPOGRAPHIC MAP "SELDOVIA BAY" 1:50,000.
 - PUBLIC RIGHT-OF-WAY: THE LESSOR HEREBY SPECIFICALLY RESERVES TO THE PUBLIC A RIGHT-OF-WAY ACROSS THE PARCEL FOR ACCESS TO NAVIGABLE WATERS AND OTHER TIDE AND SUBMERGED LANDS.

SFP-1627