




SELATNA REMOTE RECREATIONAL CABIN SITES

INDEX SHEET

NOTES:

1. This survey was accomplished in accordance with AS 38.05.600, GSC 728 and RRCS SI 2006-25.
2. All bearings, unless noted, are true bearings as oriented to the Basis of Bearing and distances shown are reduced to horizontal field distances.
3. The accuracy of this survey is greater than 1:5000.
4. All parcels of land owned by the State of Alaska, located within 50.00 feet of, or bisected by a surveyed or protracted section line, are subject to a 50 foot (50') easement, each side of the section line, which is reserved to the State of Alaska for public highways under AS 19.10.010.
5. The existing lessees' claim corners were recovered and used to control the location of tract boundaries.
6. The natural meanders of the line of ordinary high water (OHWL) form the true bounds of Tracts B, J and K. The approximate line of OHW, as shown, is for area computations only, with the true corners being on the extension of the sidelines and their intersection with the natural meanders.
7. There is a 100 foot building setback from the ordinary high water line of all water bodies.
8. **BASIS OF BEARING:** The basis of bearing for this plat was determined by high precision GPS survey, using Topcon/Javad Legacy, Legant E, and Odyssey receivers, differentially corrected and processed by Topcon Tools Vers. 6.04 software. A local grid was established oriented to true geodetic north at Lat:62°30'54.77070", Long:155°44'30.98767"; NAD 27 (Lat:62°30'52.44537", Long:155°44'39.43278"; NAD 83) (being Corner 1 of Tract B of this survey).
9. **COORDINATES:** The coordinates used were constrained to the National Spatial Reference System (NSRS) based on PACS MCG A, NGS PID DF3659, a primary airport control station at McGrath Airport, extended to the corner locations by static survey methods, and converted to NAD 27 using the CORPSCON utility. Coordinates of MCG A and secondary control points on the project were checked by OPUS.
10. Ties shown between lots and PACS MCG A are mean true bearings (NAD27) with ground distances.

BASIS OF COORDINATES
 PACS MCG A (NGS)
 Fd. 3.25" Brass Disk
 stamped "MCG A 2001"
 62°57'29.99853" N
 155°36'04.26842" W NAD27
 62°57'27.74495" N
 155°36'12.71646" W NAD 83
 (See Note 9)

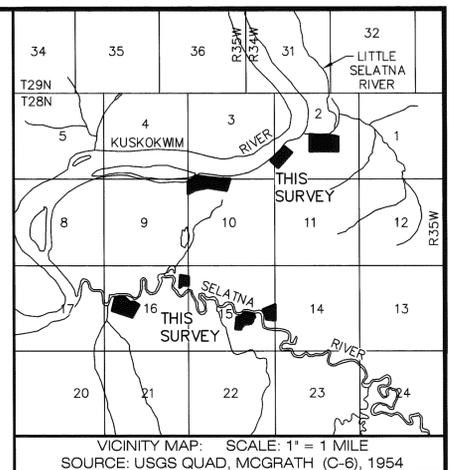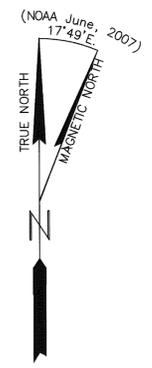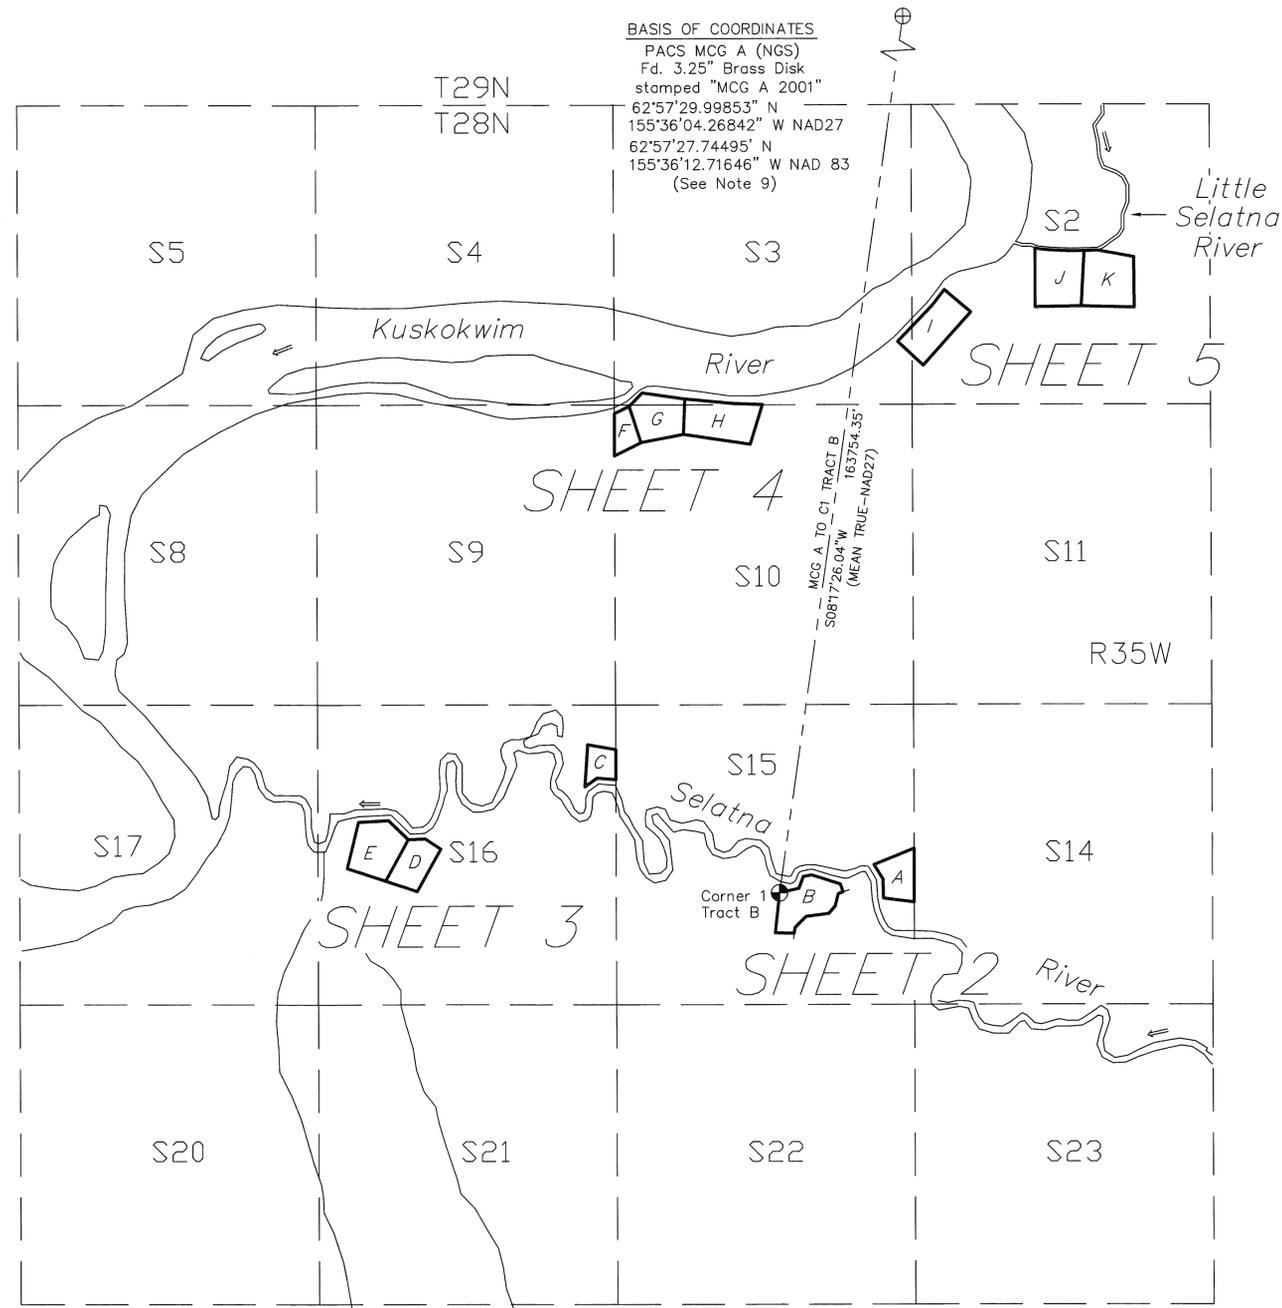

VICINITY MAP: SCALE: 1" = 1 MILE
 SOURCE: USGS QUAD, MCGRATH (C-6), 1954

CERTIFICATE OF OWNERSHIP AND DEDICATION

I, the undersigned, hereby certify that I am the Director, Division of Mining, Land, and Water, and that the State of Alaska is the owner of ASLS 2006-25 as shown hereon. I hereby approve this survey and plat for the State of Alaska, and dedicate for public or private use as noted, all easements, public utility areas, and rights-of-way as shown and described hereon.

Dated Nov 20, 2009.

Gerald Jennings
 Director, Division of Mining, Land and Water

NOTARY'S ACKNOWLEDGEMENT

Subscribed and sworn to before me this 20th day of November, 2009.

For: Gerald Jennings
Ronda Wilson
 Notary Public for Alaska
 My Commission Expires with Office



PLAT APPROVAL CERTIFICATE

This plat is approved by the Commissioner of the Department of Natural Resources, or the Commissioner's designee, in accordance with AS 40.15.

Gerald Jennings Nov 20, 2009
 Commissioner Date

By approval of this plat, the Commissioner of the Department of Natural Resources hereby accepts for public use and public purposes the real property dedicated to the public hereon, including easements, rights-of-way, alleys and roadways. The acceptance of such dedicated areas for public use and public purposes does not obligate the department, any governing body, or the public to construct, operate, maintain or manage improvements.

SURVEYORS CERTIFICATE


I hereby certify that I am properly registered and licensed to practice land surveying in the State of Alaska, that this plat represents a survey made by me or under my direct supervision, that the monuments shown hereon actually exist as described, and that all dimensions and other details are correct.

Date: 10/25/09
 Registration No.: 4469-S
 Donald E. Mullikin,
 Professional Land Surveyor




Mt. McKinley 2009-4

TYPICAL MONUMENT SET THIS SURVEY

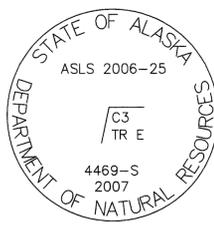

3-1/4" aluminum cap on 2" I.D. aluminum pipe, 30" long, 0.4' above ground.

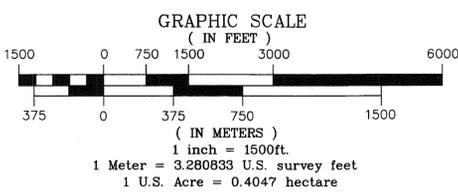

LEGEND

- ⊕ PRIMARY MONUMENT SET THIS SURVEY
- ⊕ PRIMARY MONUMENT RECOVERED
- O.H.W.L. ORDINARY HIGH WATER LINE
- SURVEYED LINE
- - - UNSURVEYED LINE
- · - · - ORDINARY HIGH WATER LINE-RIVER
- · - · - ORDINARY HIGH WATER LINE-POND OR SLOUGH
- - - EASEMENT
- - - TIE LINE
- ⇒ DIRECTION OF STREAM FLOW

DATE OF SURVEY: BEGINNING May 30, 2007 ENDING July 04, 2008	NAME OF SURVEYOR: Mullikin Surveys P.O. Box 790 Homer, AK 99603-0790
STATE OF ALASKA DEPARTMENT OF NATURAL RESOURCES, DIVISION OF MINING, LAND, AND WATER ANCHORAGE, ALASKA ALASKA STATE LAND SURVEY 2006-25	
SELATNA REMOTE RECREATIONAL CABIN SITES CREATING TRACTS A THROUGH K WITHIN UNSURVEYED SECTIONS 2, 3, 10, 15 & 16, T. 28 N., R. 35 W., SEWARD MERIDIAN, ALASKA, Mt. McKinley Recording District	
DRAWN BY: MPF DATE: 8-01-07 8-25-08	APPROVAL RECOMMENDED: <u>William S. Brown</u> for <u>11/20/09</u> STATEWIDE PLATTING SUPERVISOR, DATE
SCALE: 1" = 1500'	CHECKED: FIELD BOOKS 282A-282C DEM, JVM 300B & 301C
	FILE NO: ASLS 20060025

SELATNA REMOTE RECREATIONAL CABIN SITES

APPLICANTS CERTIFICATE

I, the undersigned, hereby certify that I am the applicant as shown hereon. I hereby approve this survey and plat.

TRACT No. "B", ADL No. 229576.

Nathan P. Collins 12-2-08
 Nathan P. Collins Date
 1111 Jackson Drive
 Anchorage, AK 99518

NOTARY'S ACKNOWLEDGEMENT



Subscribed and sworn to before me this 2 day of December, 2008.

For: Nathan Collins
[Signature]
 Notary Public for Alaska
 My Commission Expires 1/1/2012



Notes:

- There is a 100 foot building setback from the ordinary high water line of all water bodies.
- There is no applicant for Tract A, ADL 226212.

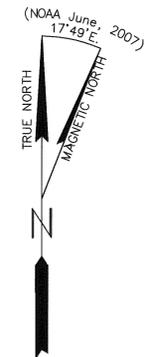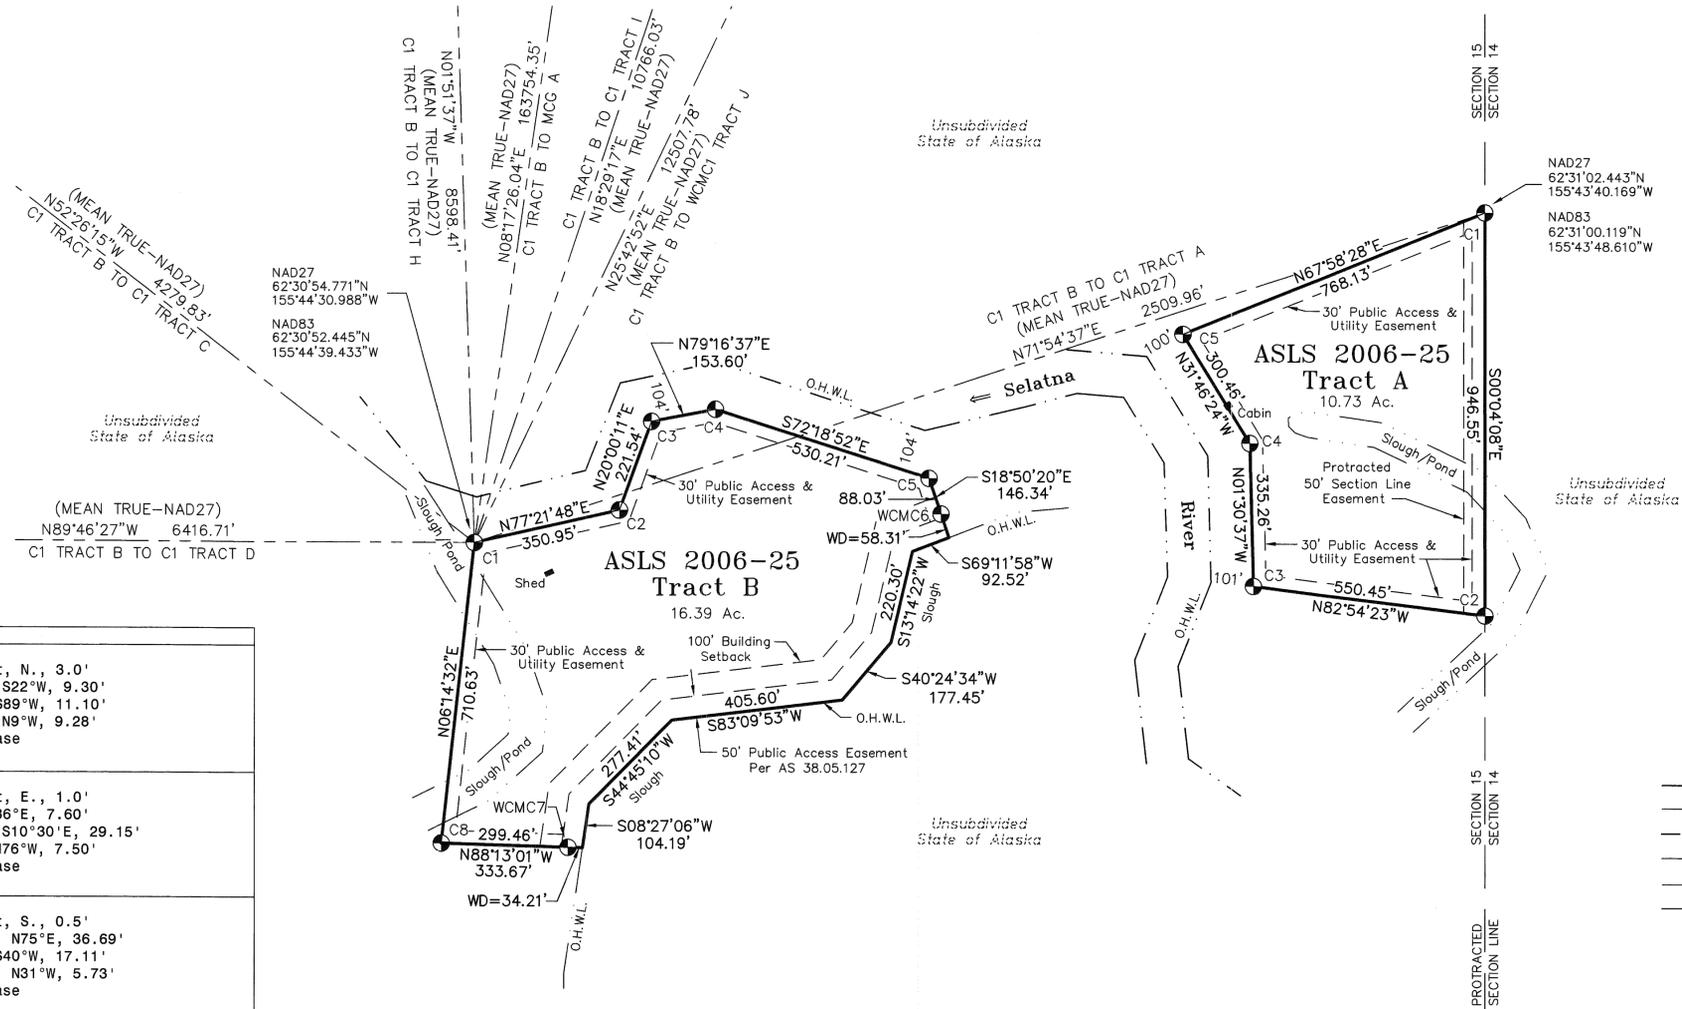

TRACT B MONUMENTATION

Cor. #	Corner Marking	Description	Accessories
1	ASLS 2006-25 C1 TR B 4469-S 2007	Set 3 1/4" alum. cap, on 2" I.D. alum. pipe.	Set: 4" Wood Post, N., 3.0' 12" Spruce, S22°W, 9.30' 6" Spruce, S89°W, 11.10' 13" Spruce, N9°W, 9.28' Magnet at base
2	ASLS 2006-25 C2 TR B 4469-S 2007	Set 3 1/4" alum. cap, on 2" I.D. alum. pipe.	Set: 4" Wood Post, E., 1.0' 7" Birch, S86°E, 7.60' 17" Spruce, S10°30'E, 29.15' 10" Birch, N76°W, 7.50' Magnet at base
3	ASLS 2006-25 C3 TR B 4469-S 2007	Set 3 1/4" alum. cap, on 2" I.D. alum. pipe, 0.5' above ground.	Set: 4" Wood Post, S., 0.5' 3.5" Willow, N75°E, 36.69' 3" Willow, S40°W, 17.11' 3.5" Willow, N31°W, 5.73' Magnet at base
4	ASLS 2006-25 C4 TR B 4469-S 2007	Set 3 1/4" alum. cap, on 2" I.D. alum. pipe, 0.5' above ground.	Set: 3" Wood Post, N., 1.0' 6" Birch, S85°E, 27.82' 9" Birch, S18°E, 21.93' 6" Spruce, S56°W, 50.40' Magnet at base
5	ASLS 2006-25 C5 TR B 4469-S 2007	Set 3 1/4" alum. cap, on 2" I.D. alum. pipe.	Set: 4" Wood Post, N., 1.0' 12" Spruce, S48°E, 40.15' 14" Birch, S6°30'W, 10.85' 12" Birch, N16°W, 5.35' Magnet at base
WCMC6	ASLS 2006-25 TR B C6 MC 4469-S 2007	Set 3 1/4" alum. cap, on 2" I.D. alum. pipe.	Set: 4" Wood Post, N., 2.0' 16" Spruce, N25°30'E, 22.60' 16" Spruce, S80°E, 21.31' 13" Birch, N45°W, 45.50' Magnet at base
WCMC7	ASLS 2006-25 TR B C7 MC 4469-S 2007	Set 3 1/4" alum. cap, on 2" I.D. alum. pipe, 0.2' above ground.	Set: 4" Wood Post, N., 2.0' 7" Spruce, N16°E, 27.55' 12" Spruce, S3°W, 32.95' 15" Spruce, N60°W, 19.69' Magnet at base
8	ASLS 2006-25 TR B C8 4469-S 2007	Set 3 1/4" alum. cap, on 2" I.D. alum. pipe, 0.6' above ground.	Set: 4" Wood Post, NW., 1.0' 7" Birch, N78°E, 23.53' 16" Spruce, S30°W, 6.98' 9" Spruce, N85°W, 33.83' Magnet at base


TRACT A MONUMENTATION

Cor. #	Corner Marking	Description	Accessories
1	ASLS 2006-25 C1 TR A 4469-S 2007	Set 3 1/4" alum. cap, on 2" I.D. alum. pipe, 0.3' above ground.	Set: 3" Wood Post, NE., 2.0' 4" Spruce, N85°E, 14.65' 3.5" Spruce, S68°E, 6.58' 3.5" Spruce, N71°W, 7.19' Magnet at base
2	ASLS 2006-25 TR A C2 4469-S 2007	Set 3 1/4" alum. cap, on 2" I.D. alum. pipe, 0.45' above ground.	Set: 4" Wood Post, E., 0.6' 5" Birch, N16°E, 19.29' 6" Birch, S74°W, 40.16' 9" Spruce, N76°W, 36.15' Magnet at base
3	ASLS 2006-25 TR A C3 4469-S 2007	Set 3 1/4" alum. cap, on 2" I.D. alum. pipe, 0.3' above ground.	Set: 4" Wood Post, E., 0.6' 10" Birch, N38°E, 21.90' 5" Spruce, S27°W, 20.82' 9" Birch, N52°W, 25.15' Magnet at base
4	ASLS 2006-25 TR A C4 4469-S 2007	Set 3 1/4" alum. cap, on 2" I.D. alum. pipe, 0.5' above ground.	Set: 4" Wood Post, N., 1.0' 4" Birch, S23°W, 18.35' 4" Birch, N73°W, 90.00' 4" Birch, N13°W, 70.55' Magnet at base
5	ASLS 2006-25 TR A C5 4469-S 2007	Set 3 1/4" alum. cap, on 2" I.D. alum. pipe, 0.6' above ground.	Set: 4" Wood Post, N., 1.0' 7" Birch, N52°E, 37.14' 6" Birch, S51°45'E, 43.97' 9" Birch, S30°30'W, 33.90' 9" Spruce, N81°W, 47.33' Magnet at base

LEGEND

- ⊙ PRIMARY MONUMENT SET THIS SURVEY
- ⊕ PRIMARY MONUMENT RECOVERED
- O.H.W.L. ORDINARY HIGH WATER LINE
- SURVEYED LINE
- - - UNSURVEYED LINE
- ORDINARY HIGH WATER LINE—RIVER
- - - ORDINARY HIGH WATER LINE—POND OR SLOUGH
- - - EASEMENT
- - - TIE LINE
- DIRECTION OF STREAM FLOW

GRAPHIC SCALE
(IN FEET)

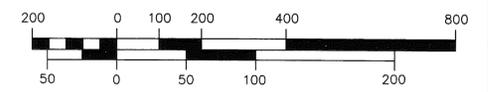

(IN METERS)

1 inch = 200ft.
 1 Meter = 3.280833 U.S. survey feet
 1 U.S. Acre = 0.4047 hectare

DATE OF SURVEY: BEGINNING May 30, 2007 ENDING July 04, 2008	NAME OF SURVEYOR: Mullikin Surveys P.O. Box 790 Homer, AK 99603-0790
STATE OF ALASKA DEPARTMENT OF NATURAL RESOURCES, DIVISION OF MINING, LAND, AND WATER ANCHORAGE, ALASKA	
ALASKA STATE LAND SURVEY 2006-25	
SELATNA REMOTE RECREATIONAL CABIN SITES CREATING TRACTS A THROUGH K WITHIN UNSURVEYED SECTIONS 2, 3, 10, 15 & 16, T. 28 N., R. 35 W., SEWARD MERIDIAN, ALASKA, Mt. McKinley Recording District	
DRAWN BY: MPF DATE: 8-01-07 8-25-08	APPROVAL RECOMMENDED: <u>William S. Brown</u> for <u>11/6/08</u> STATEWIDE PLATTING SUPERVISOR, DATE
SCALE: 1" = 200'	CHECKED: DEM, JVM FIELD BOOKS: 282A-282C 300B & 301C FILE NO: ASLS 20060025

Mt. McKinley 2009-4

SELATNA REMOTE RECREATIONAL CABIN SITES

APPLICANT'S CERTIFICATE

I, the undersigned, hereby certify that I am the applicant as shown hereon. I hereby approve this survey and plat.

TRACT No. "C", ADL No. 229605

SEE ATTACHMENT "A"
Toby R. Maloy _____ Date
913 Adams NE
Albuquerque, NM 87110

NOTARY'S ACKNOWLEDGEMENT

Subscribed and sworn to before me this ___ day of _____, 200__.

For: _____

Notary Public for
My Commission Expires _____

Notes:

- There is a 100 foot building setback from the ordinary high water line of all water bodies.

APPLICANT'S CERTIFICATE

I, the undersigned, hereby certify that I am the applicant as shown hereon. I hereby approve this survey and plat.

TRACT No. "D", ADL No. 229572

SEE ATTACHMENT "E"
Richard P. Alexie _____ Date
PO Box 3022
Bethel, AK 99559

NOTARY'S ACKNOWLEDGEMENT

Subscribed and sworn to before me this ___ day of _____, 200__.

For: _____

Notary Public for Alaska
My Commission Expires _____

APPLICANT'S CERTIFICATE

I, the undersigned, hereby certify that I am the applicant as shown hereon. I hereby approve this survey and plat.

TRACT No. "E", ADL No. 229552



SEE ATTACHMENT "E"
Louis I. Mallette IV _____ Date
PO Box 3370
Bethel, AK 99559

NOTARY'S ACKNOWLEDGEMENT

Subscribed and sworn to before me this ___ day of _____, 200__.

For: Louis I. Mallette IV



Notary Public for Alaska
My Commission Expires _____

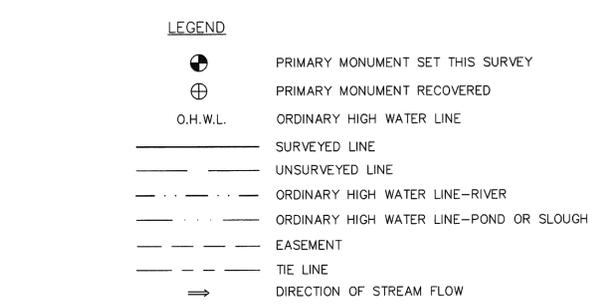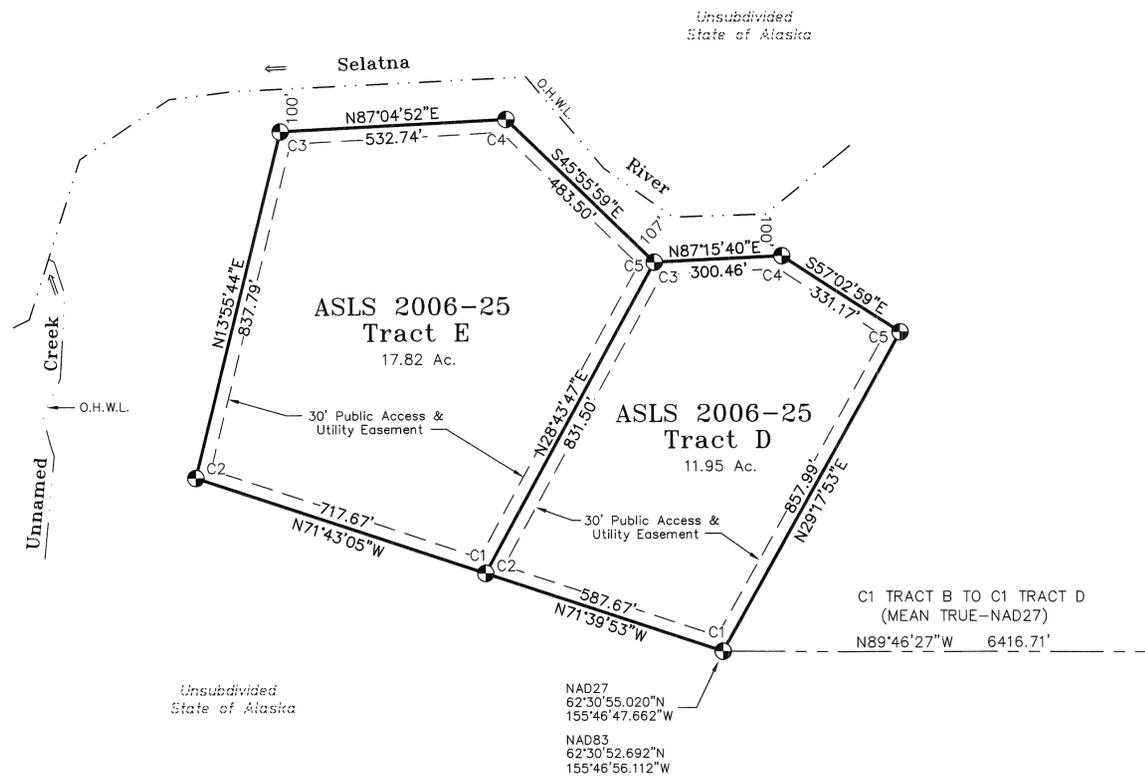

TRACT C MONUMENTATION

Cor. #	Corner Marking	Description	Accessories
1	ASLS 2006-25 C1 TR C 4469-S 2007	Set 3 1/4" alum. cap, on 2" I.D. alum. pipe, 0.2' above ground.	Set: 4" Wood Post, S., 1.0' 6" Spruce, N28°E, 75.89' 8" Birch, S33°W, 149.10' 6" Spruce, N39°W, 104.60' Magnet at base
2	ASLS 2006-25 C2 TR C 4469-S 2007	Set 3 1/4" alum. cap, on 2" I.D. alum. pipe, 0.3' above ground.	Set: 4" Wood Post, E., 1.0' 4" Spruce, N56°E, 2.88' 4" Spruce, S20°E, 20.59' 4" Spruce, N67°W, 21.85' Magnet at base
3	ASLS 2006-25 TR C C3 4469-S 2007	Set 3 1/4" alum. cap, on 2" I.D. alum. pipe.	Set: 4" Wood Post, E., 1.0' 10" Birch, N54°30'E, 12.05' 4" Birch, N48°30'W, 8.90' 12" Birch, N16°W, 20.15' Magnet at base
4	ASLS 2006-25 TR C C4 4469-S 2007	Set 3 1/4" alum. cap, on 2" I.D. alum. pipe.	Set: 4" Wood Post, S., 1.5' 8" Birch, N18°30'E, 18.41' 6" Birch, S19°30'E, 13.20' 12" Spruce, N66°W, 24.70' Magnet at base
5	ASLS 2006-25 TR C C5 4469-S 2007	Set 3 1/4" alum. cap, on 2" I.D. alum. pipe, 0.3' above ground.	Set: 4" Wood Post, W., 3.3' 6" Birch, S74°E, 14.66' 9" Birch, S52°W, 40.85' 5" Birch, N62°W, 20.35' Magnet at base

SEE SHEET 6 FOR ADDITIONAL MONUMENTS

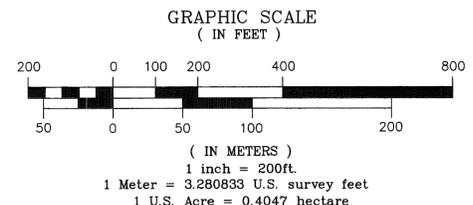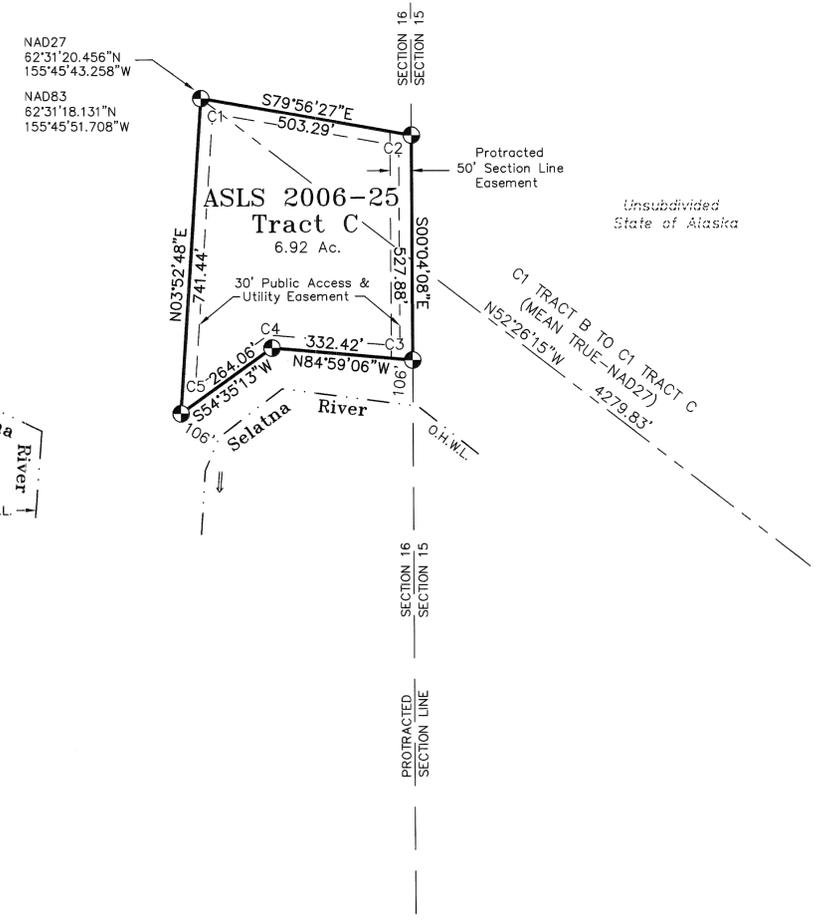

DATE OF SURVEY: BEGINNING May 30, 2007 ENDING July 04, 2008	NAME OF SURVEYOR: Mullikin Surveys P.O. Box 790 Homer, AK 99603-0790
STATE OF ALASKA DEPARTMENT OF NATURAL RESOURCES, DIVISION OF MINING, LAND, AND WATER ANCHORAGE, ALASKA	
ALASKA STATE LAND SURVEY 2006-25	
SELATNA REMOTE RECREATIONAL CABIN SITES CREATING TRACTS A THROUGH K WITHIN UNSURVEYED SECTIONS 2, 3, 10, 15 & 16, T. 28 N., R. 35 W., SEWARD MERIDIAN, ALASKA, Mt. McKinley Recording District	
DRAWN BY: MPF DATE: 8-01-07 8-25-08	APPROVAL RECOMMENDED: <u>William S. Brown</u> for 11/10/08 STATEWIDE PLATTING SUPERVISOR, DATE
SCALE: 1" = 200'	CHECKED: DEM, JVM FILE BOOKS: 282A-282C 300B & 301C FILE NO: ASLS 20060025

mt. McKinley 2009-4

SHEET 3 OF 6

Page 3 of 6

SELATNA REMOTE RECREATIONAL CABIN SITES

APPLICANT'S CERTIFICATE

I, the undersigned, hereby certify that I am the applicant as shown hereon. I hereby approve this survey and plat.

TRACT No. 'G', ADL No. 229548

Joseph D. Smith 11/3/09
 Joseph D. Smith Date
 PO Box 782
 Soldotna, AK 99669

NOTARY'S ACKNOWLEDGEMENT

Subscribed and sworn to before me this 3 day of ~~March~~ 2009.

For: *Joseph Smith*

J.P.L.C.
 Notary Public for Alaska
 My Commission Expires ~~1/1/2010~~



APPLICANT'S CERTIFICATE

I, the undersigned, hereby certify that I am the applicant as shown hereon. I hereby approve this survey and plat.

TRACT No. 'H', ADL No. 229538


Sherman Clayton Smith 10/29/09
 Sherman Clayton Smith Date
 PO Box 770
 Cooper Landing, AK 99572

NOTARY'S ACKNOWLEDGEMENT

Subscribed and sworn to before me this 23 day of ~~October~~ 2009.



For: *Sherman Smith*

Victoria Braun
 Notary Public for Alaska
 My Commission Expires ~~1/1/2010~~

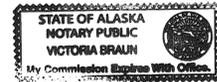

Notes:

- There is a 100 foot building setback from the ordinary high water line of all water bodies.
- There is no applicant for Tract F, ADL 229598.

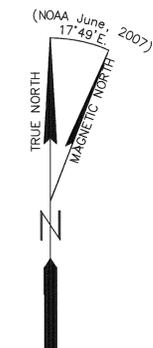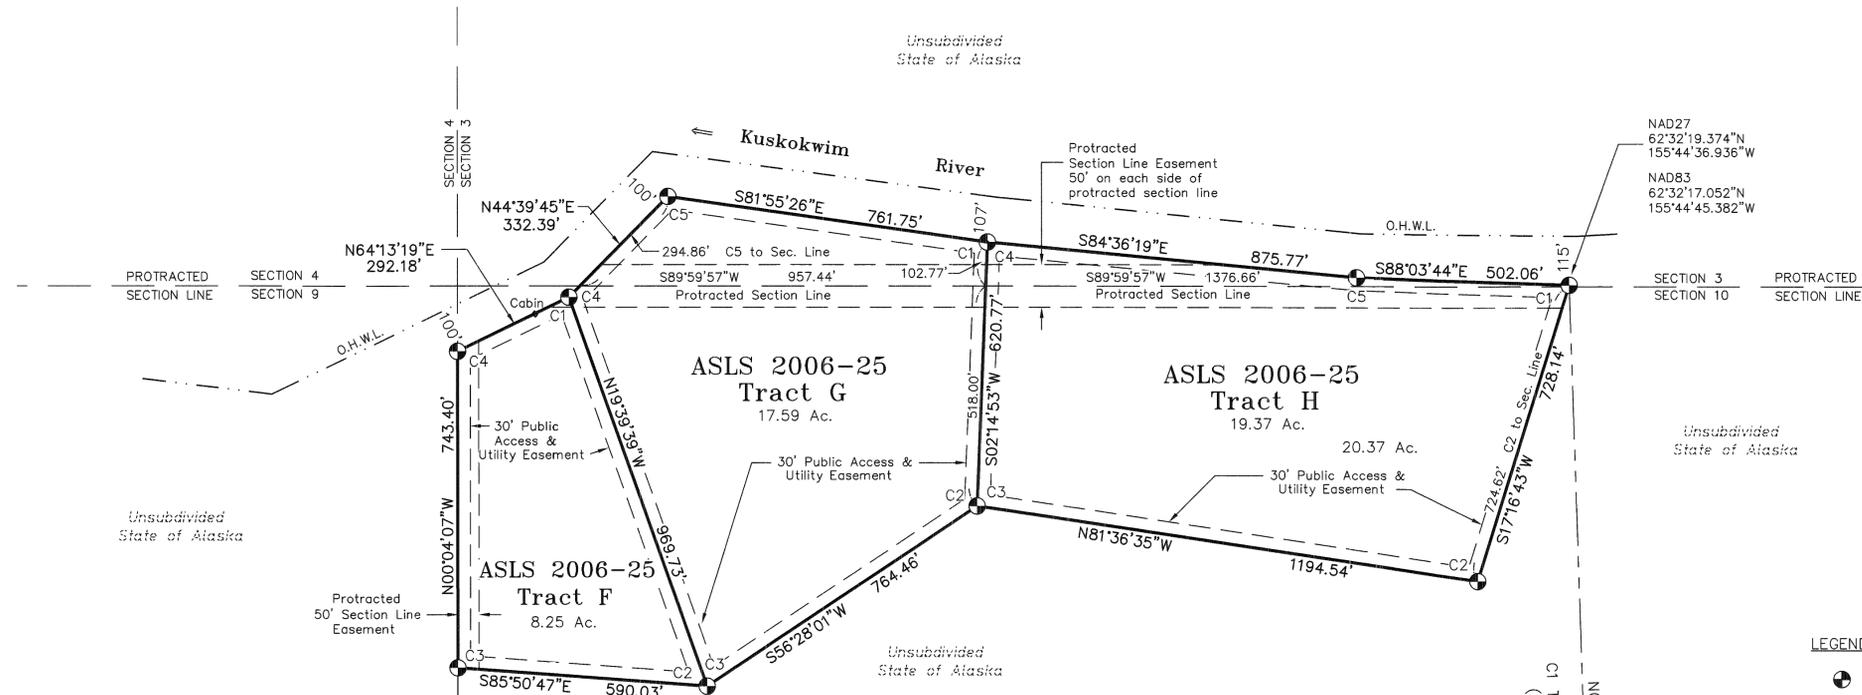

TRACT G MONUMENTATION

Cor. #	Corner Marking	Description	Accessories
1	ASLS 2006-25 C1 C4 TR G TR H 4469-S 2007	Set 3 1/4" alum. cap, on 2" I.D. alum. pipe.	Set: 4" Wood Post, E., 1.0' 11" Spruce, N86°E, 5.35' 12" Spruce, S9°30'W, 28.30' 13" Spruce, N25°W, 5.95' Magnet at base
2	ASLS 2006-25 TR G TR H C2 C3 4469-S 2007	Set 3 1/4" alum. cap, on 2" I.D. alum. pipe, 0.5' above ground.	Set: Fiberglass Post, S., 1.0' 12" Spruce, S87°E, 20.80' 6" Spruce, S64°W, 3.37' 5" Birch, N4°W, 13.63' Magnet at base
3	See Tract F, Corner 2		
4	See Tract F, Corner 1		
5	ASLS 2006-25 C5 TR G 4469-S 2007	Set 3 1/4" alum. cap, on 2" I.D. alum. pipe, 0.3' above ground.	Set: 4" Wood Post, SE., 0.5' 8" Spruce, N76°E, 29.72' 4" Spruce, S21°E, 29.65' 5.5" Cottonwood, S78°W, 22.30' Magnet at base

TRACT F MONUMENTATION

Cor. #	Corner Marking	Description	Accessories
1	ASLS 2006-25 C1 C4 TR F 4469-S 2008	Set 3 1/4" alum. cap, on 2" I.D. alum. pipe, 0.1' above ground.	Set: 4" Wood Post, NE., 1.0' 4" Cottonwood, N89°E, 12.94' 24" Spruce, S46°W, 25.53' 9" Cottonwood, N10°30'W, 43.33' Magnet at base
2	ASLS 2006-25 TR F TR G C2 C3 4469-S 2009	Set 3 1/4" alum. cap, on 2" I.D. alum. pipe.	Set: 4" Wood Post, N., 1.0' 9" Birch, N51°E, 24.63' 5" Spruce, S29°W, 22.24' 6" Spruce, N62°30'W, 23.88' Magnet at base
3	ASLS 2006-25 TR F C3 4469-S 2007	Set 3 1/4" alum. cap, on 2" I.D. alum. pipe, 0.3' above ground.	Set: 4" Wood Post, E., 0.5' 5" Cottonwood, N13°E, 14.58' 3.5" Birch, N73°E, 23.79' 5" Spruce, S9°E, 9.22' Magnet at base
4	ASLS 2006-25 C4 TR F 4469-S 2008	Set 3 1/4" alum. cap, on 2" I.D. alum. pipe, 0.3' above ground.	Set: Fiberglass Post, N., 0.8' 8" Birch, S37°30'E, 25.23' 11" Cottonwood, S48°30'W, 18.14' 7" Birch, N13°W, 35.25' Magnet at base

TRACT H MONUMENTATION

Cor. #	Corner Marking	Description	Accessories
1	ASLS 2006-25 C1 TR H 4469-S 2007	Set 3 1/4" alum. cap, on 2" I.D. alum. pipe.	Set: 4" Wood Post, W., 1.0' 11" Spruce, S9°30'E, 5.05' 11" Spruce, S53°W, 35.33' 8" Spruce, N76°30'W, 36.25' Magnet at base
2	ASLS 2006-25 TR H C2 4469-S 2007	Set 3 1/4" alum. cap, on 2" I.D. alum. pipe, 0.2' above ground.	Set: Fiberglass Post, S., 1.0' 6" Birch, N60°E, 3.79' 5" Birch, S30°W, 10.68' 4" Birch, S81°W, 11.39' Magnet at base
3	See Tract G, Corner 2		
4	See Tract G, Corner 1		
5	ASLS 2006-25 C5 TR H 4469-S 2007	Set 3 1/4" alum. cap, on 2" I.D. alum. pipe, 0.4' above ground.	Set: 4" Wood Post, E., 0.5' 5" Birch, S12°E, 32.33' 9" Spruce, S75°W, 12.68' 11" Spruce, N36°W, 17.33' Magnet at base

LEGEND

- ⊙ PRIMARY MONUMENT SET THIS SURVEY
- ⊕ PRIMARY MONUMENT RECOVERED
- O.H.W.L. ORDINARY HIGH WATER LINE
- SURVEYED LINE
- - - UNSURVEYED LINE
- · - · - ORDINARY HIGH WATER LINE—RIVER
- · - · - ORDINARY HIGH WATER LINE—POND OR SLOUGH
- - - EASEMENT
- - - TIE LINE
- ⇒ DIRECTION OF STREAM FLOW

GRAPHIC SCALE
(IN FEET)

(IN METERS)
1 inch = 200ft.
1 Meter = 3.280833 U.S. survey feet
1 U.S. Acre = 0.4047 hectare

DATE OF SURVEY: BEGINNING May 30, 2007 ENDING July 04, 2008	NAME OF SURVEYOR: Mullikin Surveys P.O. Box 790 Homer, AK 99603-0790
STATE OF ALASKA DEPARTMENT OF NATURAL RESOURCES, DIVISION OF MINING, LAND, AND WATER ANCHORAGE, ALASKA	
ALASKA STATE LAND SURVEY 2006-25	
SELATNA REMOTE RECREATIONAL CABIN SITES CREATING TRACTS A THROUGH K WITHIN UNSURVEYED SECTIONS 2, 3, 10, 15 & 16, T. 28 N., R. 35 W., SEWARD MERIDIAN, ALASKA, Mt. McKinley Recording District	
DRAWN BY: MPF/TAL DATE: 8-01-07	APPROVAL RECOMMENDED: <i>William S. Braun</i> for 11/6/09 STATEWIDE PLATTING SUPERVISOR, DATE
SCALE: 1" = 200'	CHECKED: DEM, JVM FIELD BOOKS: 282A-282C 300B & 301C FILE NO.: ASLS 20060025

Mt. McKinley 2009-4

SELATNA REMOTE RECREATIONAL CABIN SITES

APPLICANT'S CERTIFICATE

I, the undersigned, hereby certify that I am the applicant as shown hereon. I hereby approve this survey and plat.

TRACT No. "I", ADL No. 229567

SEE ATTACHMENT "D"
 Louis Mallette Sr. _____ Date
 PO Box 13
 Lower Kalskag, AK 99626

NOTARY'S ACKNOWLEDGEMENT

Subscribed and sworn to before me this ___ day of _____, 200__.

For: _____

Notary Public for Alaska
 My Commission Expires _____

APPLICANT'S CERTIFICATE

I, the undersigned, hereby certify that I am the applicant as shown hereon. I hereby approve this survey and plat.

TRACT No. "J", ADL No. 229756

SEE ATTACHMENT "B"
 Paul Edward Claus _____ Date
 PO Box 109
 Chitina, AK 99566

NOTARY'S ACKNOWLEDGEMENT

Subscribed and sworn to before me this ___ day of _____, 200__.

For: _____

Notary Public for Alaska
 My Commission Expires _____

APPLICANT'S CERTIFICATE

I, the undersigned, hereby certify that I am the applicant as shown hereon. I hereby approve this survey and plat.

TRACT No. "K", ADL No. 229755

SEE ATTACHMENT "C"
 Donna E. Claus _____ Date
 PO Box 109
 Chitina, AK 99566

NOTARY'S ACKNOWLEDGEMENT



Subscribed and sworn to before me this ___ day of _____, 200__.

For: _____


Notary Public for Alaska
 My Commission Expires _____

Notes:

1. There is a 100 foot building setback from the ordinary high water line of all water bodies.

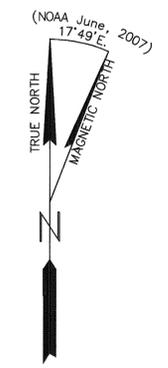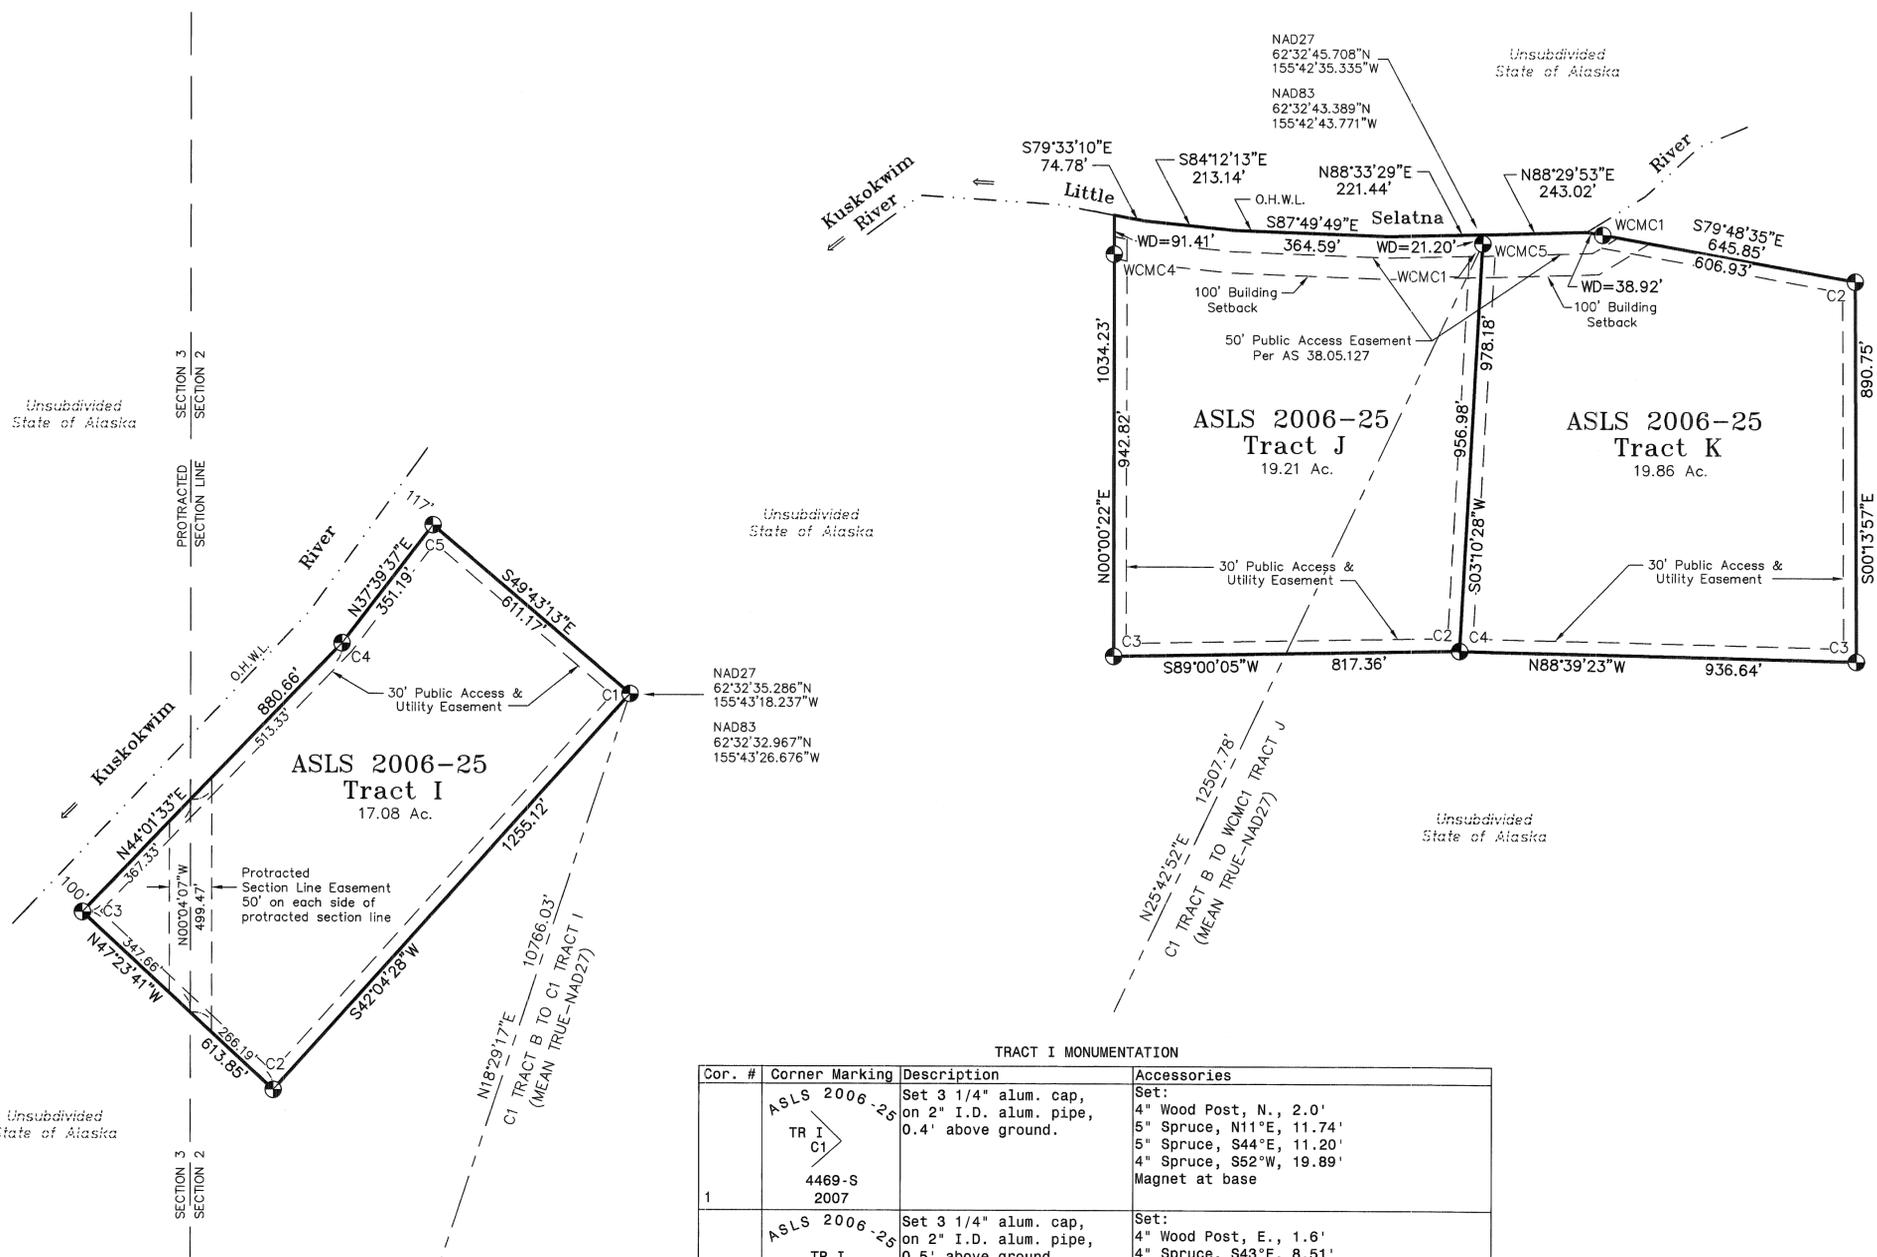

- LEGEND**
- PRIMARY MONUMENT SET THIS SURVEY
 - PRIMARY MONUMENT RECOVERED
 - O.H.W.L. ORDINARY HIGH WATER LINE
 - SURVEYED LINE
 - - - UNSURVEYED LINE
 - · - · - ORDINARY HIGH WATER LINE—RIVER
 - · - · - ORDINARY HIGH WATER LINE—POND OR SLOUGH
 - - - EASEMENT
 - - - TIE LINE
 - ⇒ DIRECTION OF STREAM FLOW

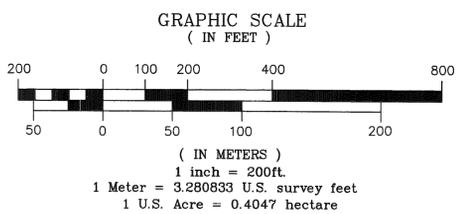

TRACT I MONUMENTATION

Cor. #	Corner Marking	Description	Accessories
1	ASLS 2006-25 TR I C1 4469-S 2007	Set 3 1/4" alum. cap, on 2" I.D. alum. pipe, 0.4' above ground.	Set: 4" Wood Post, N., 2.0' 5" Spruce, N11°E, 11.74' 5" Spruce, S44°E, 11.20' 4" Spruce, S52°W, 19.89' Magnet at base
2	ASLS 2006-25 TR I C2 4469-S 2007	Set 3 1/4" alum. cap, on 2" I.D. alum. pipe, 0.5' above ground.	Set: 4" Wood Post, E., 1.6' 4" Spruce, S43°E, 8.51' 4" Spruce, S51°W, 51.25' 4" Spruce, N63°W, 49.13' Magnet at base
3	ASLS 2006-25 TR I C3 4469-S 2007	Set 3 1/4" alum. cap, on 2" I.D. alum. pipe.	Set: 4" Wood Post, S., 1.0' 5" Spruce, N89°E, 20.65' 7" Spruce, S49°30'E, 70.45' 10" Birch, S14°W, 7.10' Magnet at base
4	ASLS 2006-25 TR I C4 4469-S 2007	Set 3 1/4" alum. cap, on 2" I.D. alum. pipe, 0.3' above ground.	Set: 4" Wood Post, S., 3.0' 7" Birch, N8°E, 19.60' 5" Spruce, S85°E, 18.83' 5" Spruce, S47°30'W, 27.21' Magnet at base
5	ASLS 2006-25 TR I C5 4469-S 2007	Set 3 1/4" alum. cap, on 2" I.D. alum. pipe, 0.3' above ground.	Set: 4" Wood Post, NE., 2.0' 9" Spruce, N30°30'E, 17.45' 8" Birch, S5°W, 15.80' 8" Birch, N22°W, 5.50' Magnet at base

SEE SHEET 6 FOR ADDITIONAL MONUMENTS

Mt. McKinley 2009-4

SHEET 5 OF 6

DATE OF SURVEY: BEGINNING May 30, 2007 ENDING July 04, 2008	NAME OF SURVEYOR: Mullikin Surveys P.O. Box 790 Homer, AK 99603-0790
STATE OF ALASKA DEPARTMENT OF NATURAL RESOURCES, DIVISION OF MINING, LAND, AND WATER ANCHORAGE, ALASKA	
ALASKA STATE LAND SURVEY 2006-25	
SELATNA REMOTE RECREATIONAL CABIN SITES CREATING TRACTS A THROUGH K WITHIN UNSURVEYED SECTIONS 2, 3, 10, 15 & 16, T. 28 N., R. 35 W., SEWARD MERIDIAN, ALASKA, Mt. McKinley Recording District	
DRAWN BY: MPF DATE: 8-01-07 8-25-08	APPROVAL RECOMMENDED: <i>William S. Brown for 11/1/09</i> STATEWIDE PLATTING SUPERVISOR, DATE
SCALE: 1" = 200'	CHECKED: DEM, JVM FIELD BOOKS: 282A-282C 300B & 301C FILE NO: ASLS 20060025

SELATNA REMOTE RECREATIONAL CABIN SITES

TRACT D MONUMENTATION

Cor. #	Corner Marking	Description	Accessories
1	ASLS 2006-25 TR D C1 4469-S 2007	Set 3 1/4" alum. cap, on 2" I.D. alum. pipe, 0.5' above ground.	Set: Post, W., 1.0' 5" Spruce, N47°E, 5.50' 8" Spruce, S22°E, 19.69' 5" Spruce, N24°W, 6.84' Magnet at base
2	ASLS 2006-25 TR E/TR D C1/C2 4469-S 2007	Set 3 1/4" alum. cap, on 2" I.D. alum. pipe, 0.6' above ground.	Set: 4" Wood Post, SE., 1.5' 5" Spruce, S53°E, 16.59' 7" Spruce, S12°W, 19.22' 5" Spruce, N66°W, 29.30' Magnet at base
3	ASLS 2006-25 C5 TR E C3 TR D 4469-S 2007	Set 3 1/4" alum. cap, on 2" I.D. alum. pipe, 0.5' above ground.	Set: 4" Wood Post, W., 5.5' 12" Birch, N18°E, 22.98' 9" Birch, S45°E, 43.05' 12" Birch, S56°W, 26.66' Magnet at base
4	ASLS 2006-25 C4 TR D 4469-S 2007	Set 3 1/4" alum. cap, on 2" I.D. alum. pipe, 0.6' above ground.	Set: 4" Wood Post, W., 0.5' 14" Spruce, S86°E, 36.23' 11" Spruce, S26°W, 29.65' 7" Birch, N68°W, 38.01' Magnet at base
5	ASLS 2006-25 TR D C5 4469-S 2007	Set 3 1/4" alum. cap, on 2" I.D. alum. pipe, 0.5' above ground.	Set: 7" Wood Post, NE., 6.0' 13" Spruce, N2°E, 13.28' 15" Spruce, S28°E, 5.78' 8" Spruce, N84°W, 42.25' Magnet at base

TRACT E MONUMENTATION

Cor. #	Corner Marking	Description	Accessories
1	See Tract D, Corner 2		
2	ASLS 2006-25 TR E C2 4469-S 2007	Set 3 1/4" alum. cap, on 2" I.D. alum. pipe, 0.5' above ground.	Set: 4" Wood Post, W., 1.0' 5" Spruce, S57°E, 12.31' 8" Spruce, S59°W, 9.93' 6" Spruce, N11°W, 6.45' Magnet at base
3	ASLS 2006-25 C3 TR E 4469-S 2007	Set 3 1/4" alum. cap, on 2" I.D. alum. pipe, 0.3' above ground.	Set: 4" Wood Post, NE., 0.5' 10" Birch, N50°E, 24.30' 9" Birch, S29°E, 17.73' 9" Birch, S84°W, 37.89' Magnet at base
4	ASLS 2006-25 C4 TR E 4469-S 2007	Set 3 1/4" alum. cap, on 2" I.D. alum. pipe, 0.4' above ground.	Set: 4" Wood Post, SE., 0.5' 8" Alder, N26°E, 16.52' 11" Birch, S30°E, 64.12' 13" Birch, S27°W, 58.94' Magnet at base
5	See Tract D, Corner 3		

TRACT J MONUMENTATION

Cor. #	Corner Marking	Description	Accessories
WCMC1	ASLS 2006-25 WC MC C1/C5 TR J TR K 4469-S 2007	Set 3 1/4" alum. cap, on 2" I.D. alum. pipe.	Set: 4" Wood Post, N., 1.0' 9" Birch, N89°E, 54.57' 6" Birch, S1°E, 7.10' 4" Alder, N77°W, 47.95' Magnet at base
2	ASLS 2006-25 TR J TR K C2 C4 4469-S 2007	Set 3 1/4" alum. cap, on 2" I.D. alum. pipe, 0.5' above ground.	Set: 4" Wood Post, S., 0.6' 7.5" Spruce, N29°E, 22.40' 5" Spruce, S2°E, 7.49' 6" Spruce, N76°W, 7.02' Magnet at base
3	ASLS 2006-25 TR J C3 4469-S 2007	Set 3 1/4" alum. cap, on 2" I.D. alum. pipe, 0.5' above ground.	Set: 3" Wood Post, W., 1.0' 5" Spruce, S76°E, 15.72' 4" Spruce, N72°30'W, 19.97' 5" Birch, N33°W, 24.23' Magnet at base
WCMC4	ASLS 2006-25 WC MC C4 TR J 4469-S 2007	Set 3 1/4" alum. cap, on 2" I.D. alum. pipe, 0.3' above ground.	Set: 4" Wood Post, NE., 3.0' 5" Spruce, N63°E, 26.22' 12" Spruce, S42°30'E, 18.12' 12" Spruce, N1°30'W, 21.80' Magnet at base

TRACT K MONUMENTATION

Cor. #	Corner Marking	Description	Accessories
WCMC1	ASLS 2006-25 WC MC C1 TR K 4469-S 2007	Set 3 1/4" alum. cap, on 2" I.D. alum. pipe, 0.3' above ground.	Set: 4" Wood Post, SW., 0.5' 12" Spruce, N71°E, 39.35' 8" Spruce, S43°E, 15.77' 7" Birch, S75°W, 22.54' Magnet at base
2	ASLS 2006-25 C2 TR K 4469-S 2007	Set 3 1/4" alum. cap, on 2" I.D. alum. pipe, 0.3' above ground.	Set: 4"x2" Wood Post, S., 0.5' 4" Spruce, S46°W, 31.35' 5" Spruce, N78°30'W, 16.90' 4" Spruce, N33°W, 32.30' Magnet at base
3	ASLS 2006-25 TR K C3 4469-S 2007	Set 3 1/4" alum. cap, on 2" I.D. alum. pipe, 0.5' above ground.	Set: 3" Wood Post, S., 1.0' 3.5" Spruce, S6°E, 30.09' 4" Spruce, S24°W, 33.10' 4" Spruce, N81°W, 36.89' Magnet at base
4	See Tract J, Corner 2		
5	See Tract J, Corner 1		

20094
REC DIST
DATE Nov. 30 2007
TIME 2:27
Request by: AS/State Land
Address: and water

DATE OF SURVEY: BEGINNING May 30, 2007 ENDING July 04, 2008	NAME OF SURVEYOR: Mullikin Surveys P.O. Box 790 Homer, AK 99603-0790
STATE OF ALASKA DEPARTMENT OF NATURAL RESOURCES, DIVISION OF MINING, LAND, AND WATER ANCHORAGE, ALASKA	
ALASKA STATE LAND SURVEY 2006-25	
SELATNA REMOTE RECREATIONAL CABIN SITES CREATING TRACTS A THROUGH K WITHIN UNSURVEYED SECTIONS 2, 3, 10, 15 & 16, T. 28 N., R. 35 W., SEWARD MERIDIAN, ALASKA, Mt. McKinley Recording District	
DRAWN BY: MPF DATE: 8-01-07 8-25-08	APPROVAL RECOMMENDED: William S. Brown for 11/1/08 STATEWIDE PLATING SUPERVISOR, DATE
SCALE: N.A.	CHECKED DEM, JVM
FIELD BOOKS 282A-282C 300B & 301C	FILE NO: ASLS 20060025

Mt. McKinley 20094


Attachment "A"

ALASKA STATE LAND SURVEY 2006-25

APPLICANT CERTIFICATE

I, the undersigned, hereby certify that I am the applicant as shown hereon.
I hereby approve this survey and plat.

TRACT C ADL No. 229605

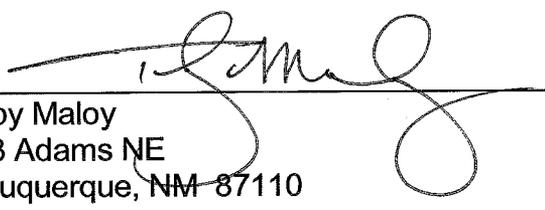

Toby Maloy
913 Adams NE
Albuquerque, NM 87110


11-25-08
Date

NOTARY'S ACKNOWLEDGEMENT

Subscribed and sworn before me this 25th day of November, 2008

For _____

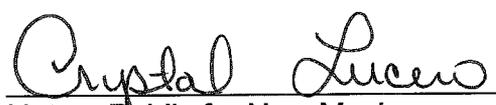
Notary Public for New Mexico
My Commission Expires 4/25/09

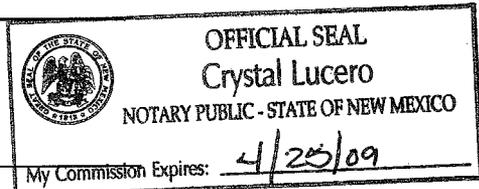

Attachment "B"

ALASKA STATE LAND SURVEY 2006-25

APPLICANT CERTIFICATE

I, the undersigned, hereby certify that I am the applicant as shown hereon.
I hereby approve this survey and plat.

TRACT No. "J" ADL No. 229756

Paul Claus
Paul E. Claus
P.O. Box 109
Chitina, Alaska 99566


1/26/09
Date

NOTARY'S ACKNOWLEDGEMENT

Subscribed and sworn to before me this 26 day of January, 2009

For Paul Claus

[Signature]
Notary Public for Alaska
My Commission Expires with office

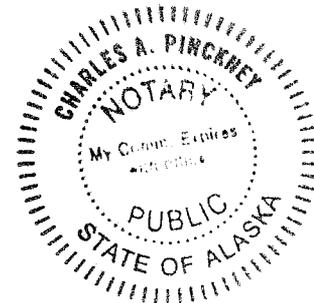

Attachment "C"

ALASKA STATE LAND SURVEY 2006-25

APPLICANT CERTIFICATE

I, the undersigned, hereby certify that I am the applicant as shown hereon.
I hereby approve this survey and plat.

TRACT No. "K" ADL No. 229755

Donna E. Claus
Donna E. Claus
P.O. Box 109
Chitina, Alaska 99566


1/26/09
Date

NOTARY'S ACKNOWLEDGEMENT

Subscribed and sworn to before me this 26 day of January, 2009

For Donna Claus

[Signature]
Notary Public for Alaska
My Commission Expires with office

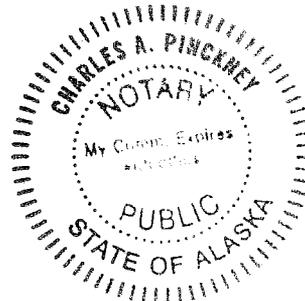

Attachment "B"

ALASKA STATE LAND SURVEY 2006-25

APPLICANT CERTIFICATE

I, the undersigned, hereby certify that I am the applicant as shown hereon.
I hereby approve this survey and plat.

TRACT No. I ADL No. 229567

Louis Mallette Sr
Louis Mallette, Sr.
PO Box 13
Lower Kalskag, Alaska 99626

January 24, 2009
Date

NOTARY'S ACKNOWLEDGEMENT

Subscribed and sworn before me this 24th day of January, 2009

For Lower Kalskag Postal Service

Nastasia
Notary Public for Alaska
My Commission Expires _____



Attachment "E"

ALASKA STATE LAND SURVEY 2006-25

APPLICANT CERTIFICATE

I, the undersigned, hereby certify that I am the applicant as shown hereon.
I hereby approve this survey and plat.

TRACT No. "D" ADL No. 229572




Richard Alexie
PO Box ~~3022~~ 401
Bethel, Alaska 99559

8/3/09
Date

NOTARY'S ACKNOWLEDGEMENT

Subscribed and sworn to before me this 3rd day of August, 2009

For Richard Alexie

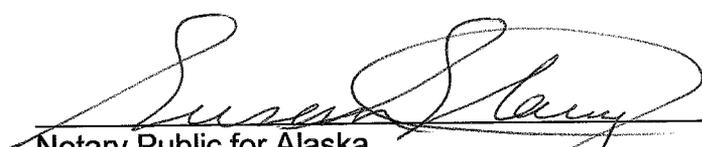

Notary Public for Alaska
My Commission Expires with office

