



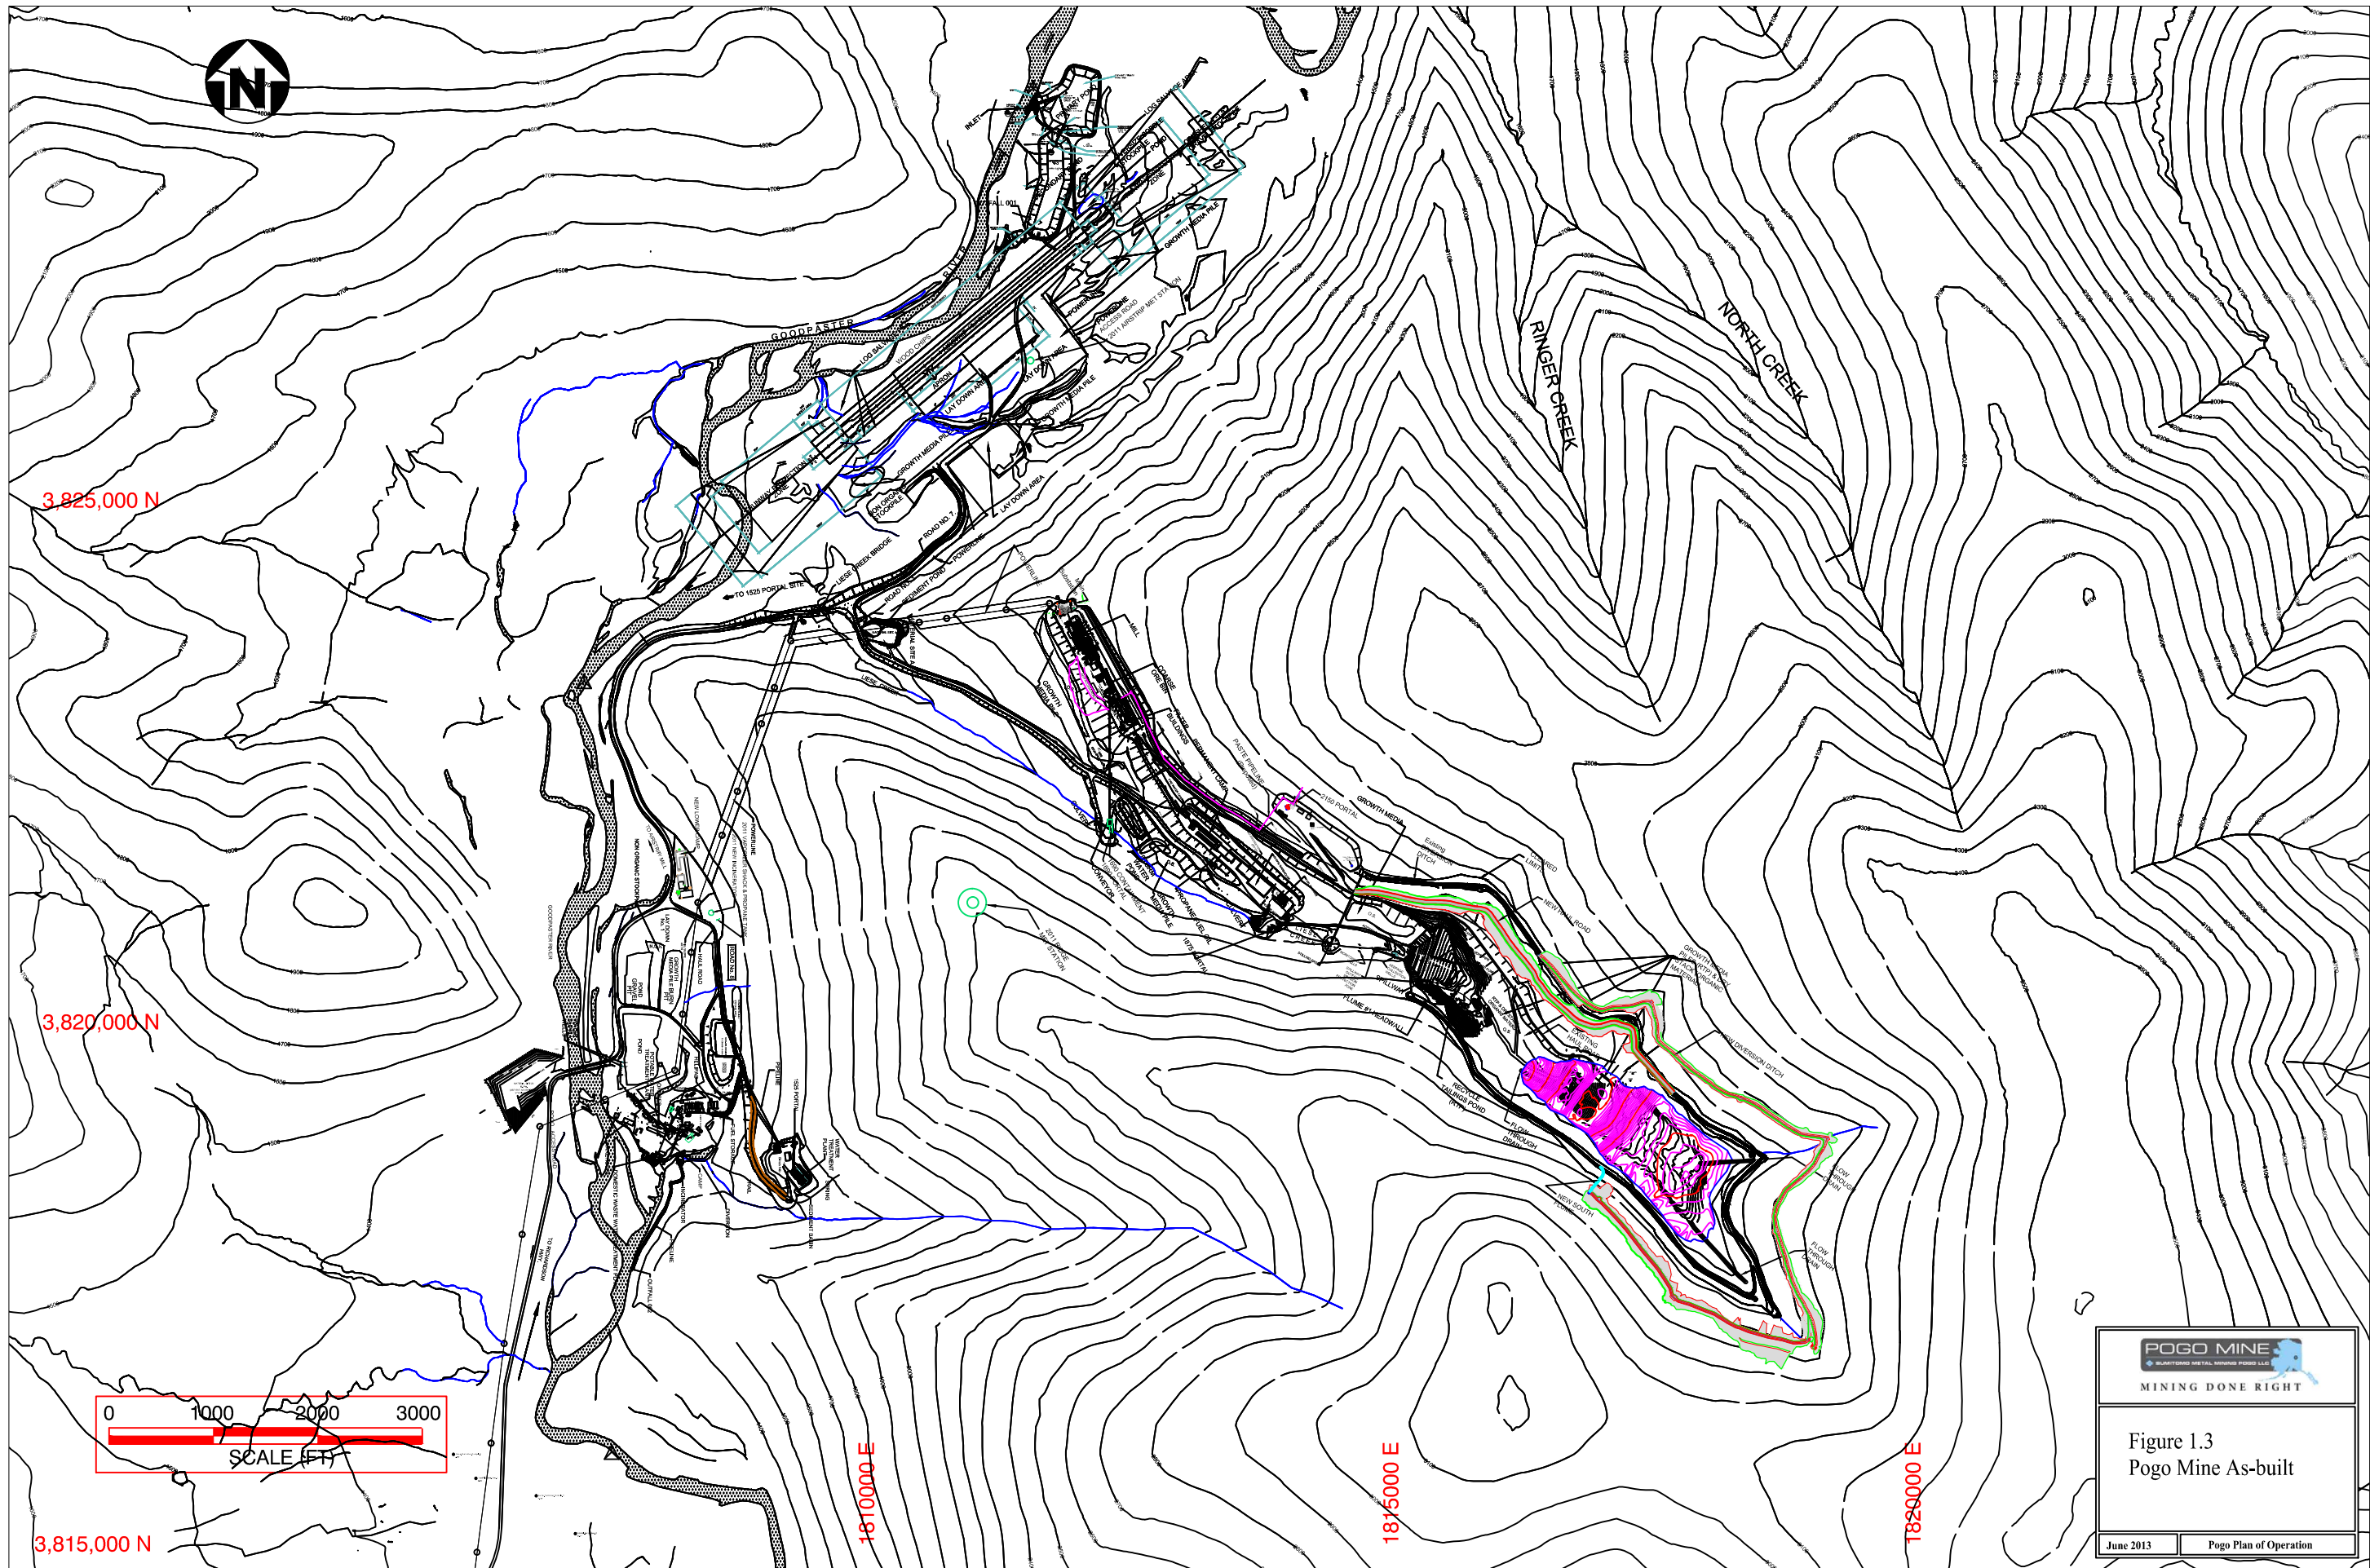



POGO MINE
MINING DONE RIGHT

Figure 1.3
Pogo Mine As-built

June 2013 Pogo Plan of Operation

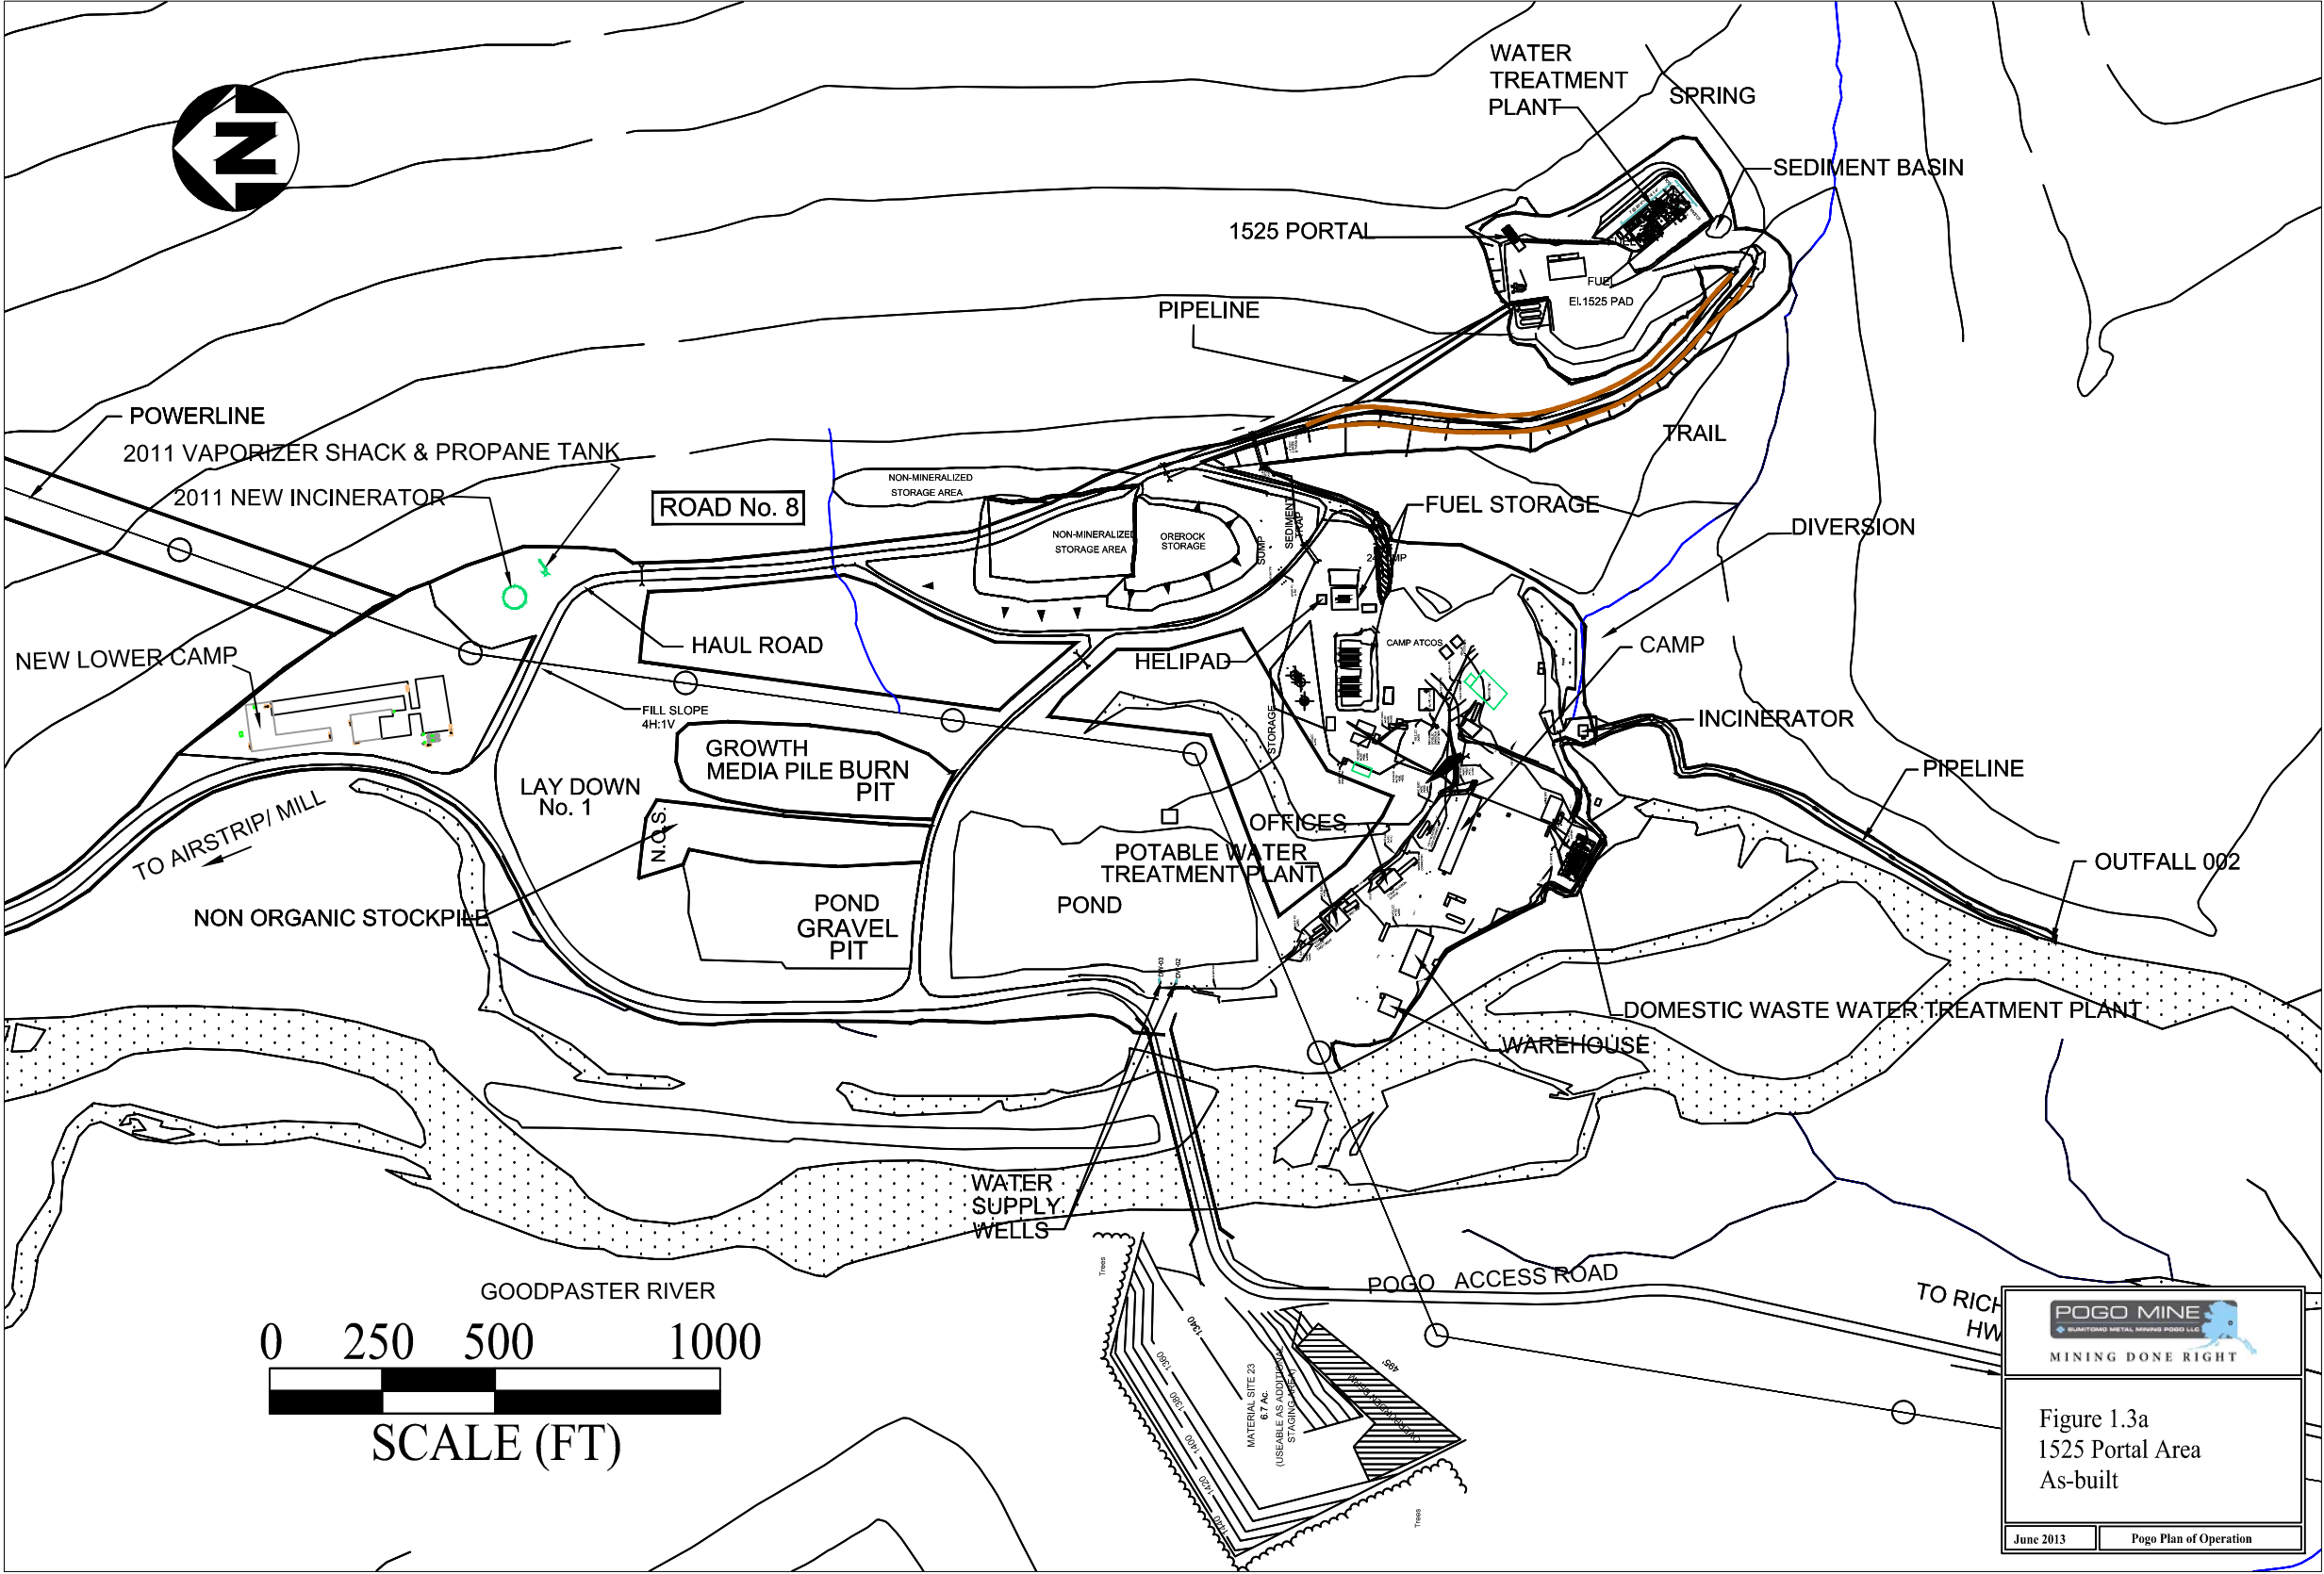

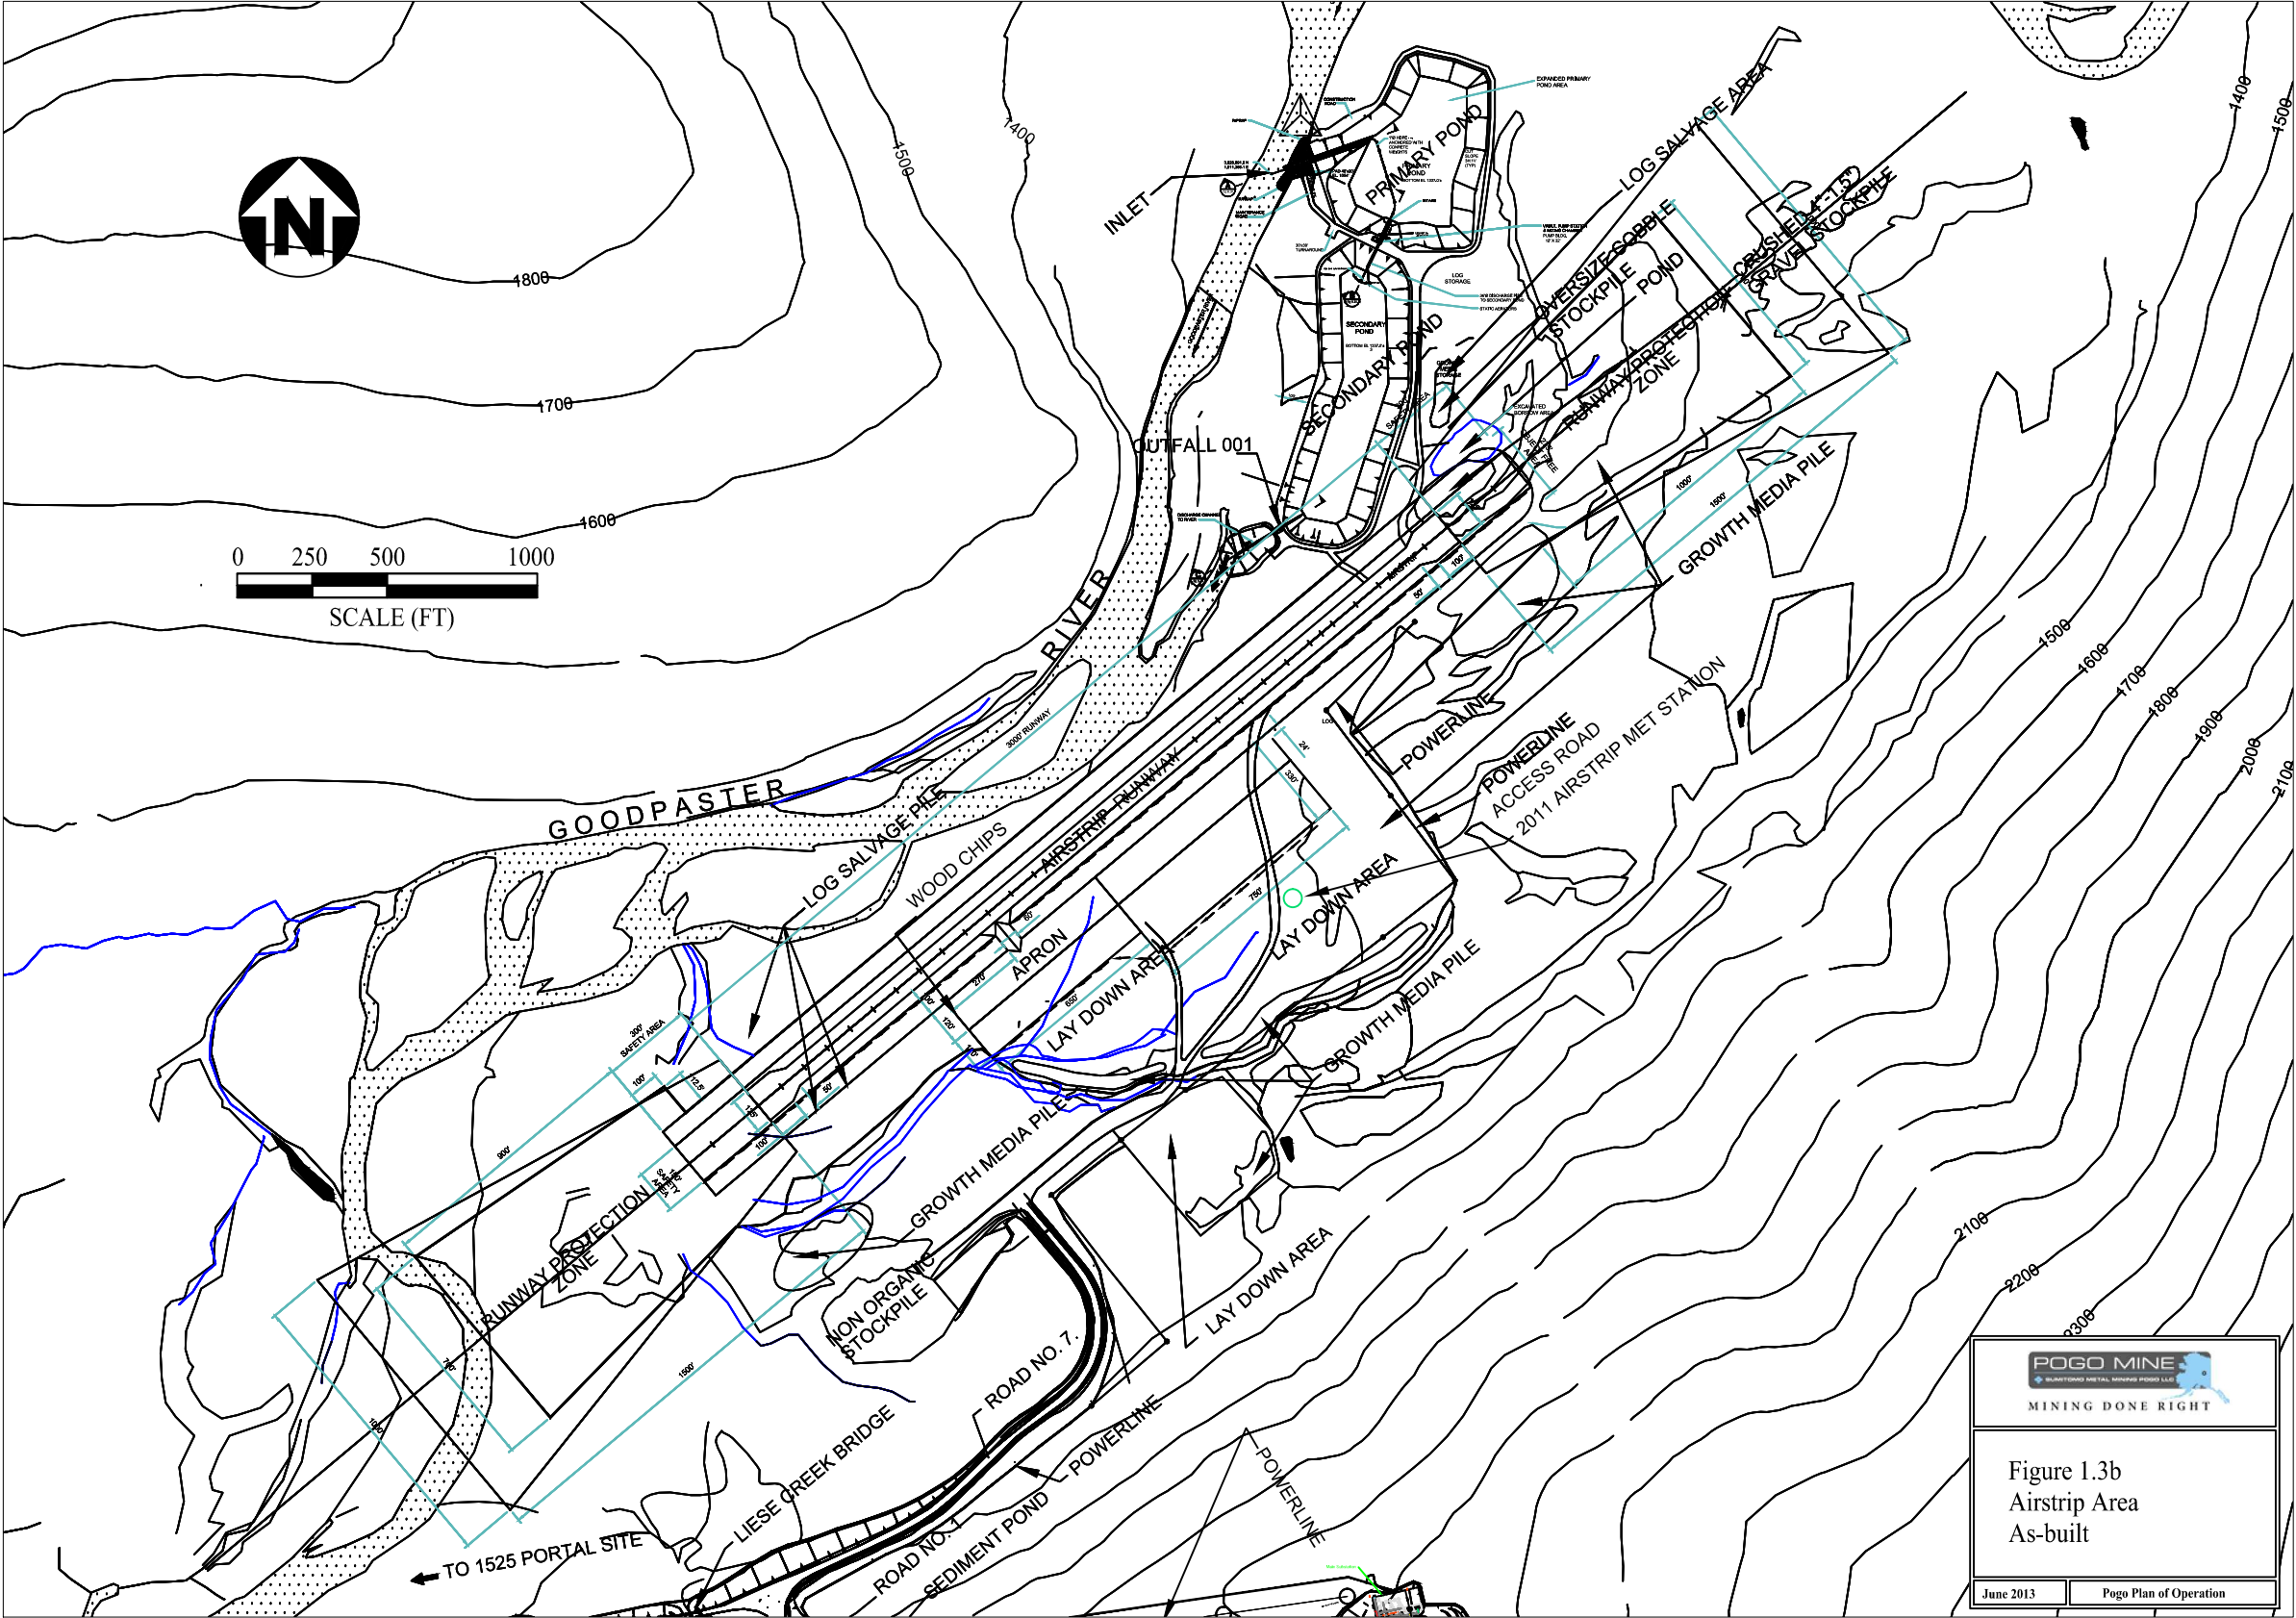

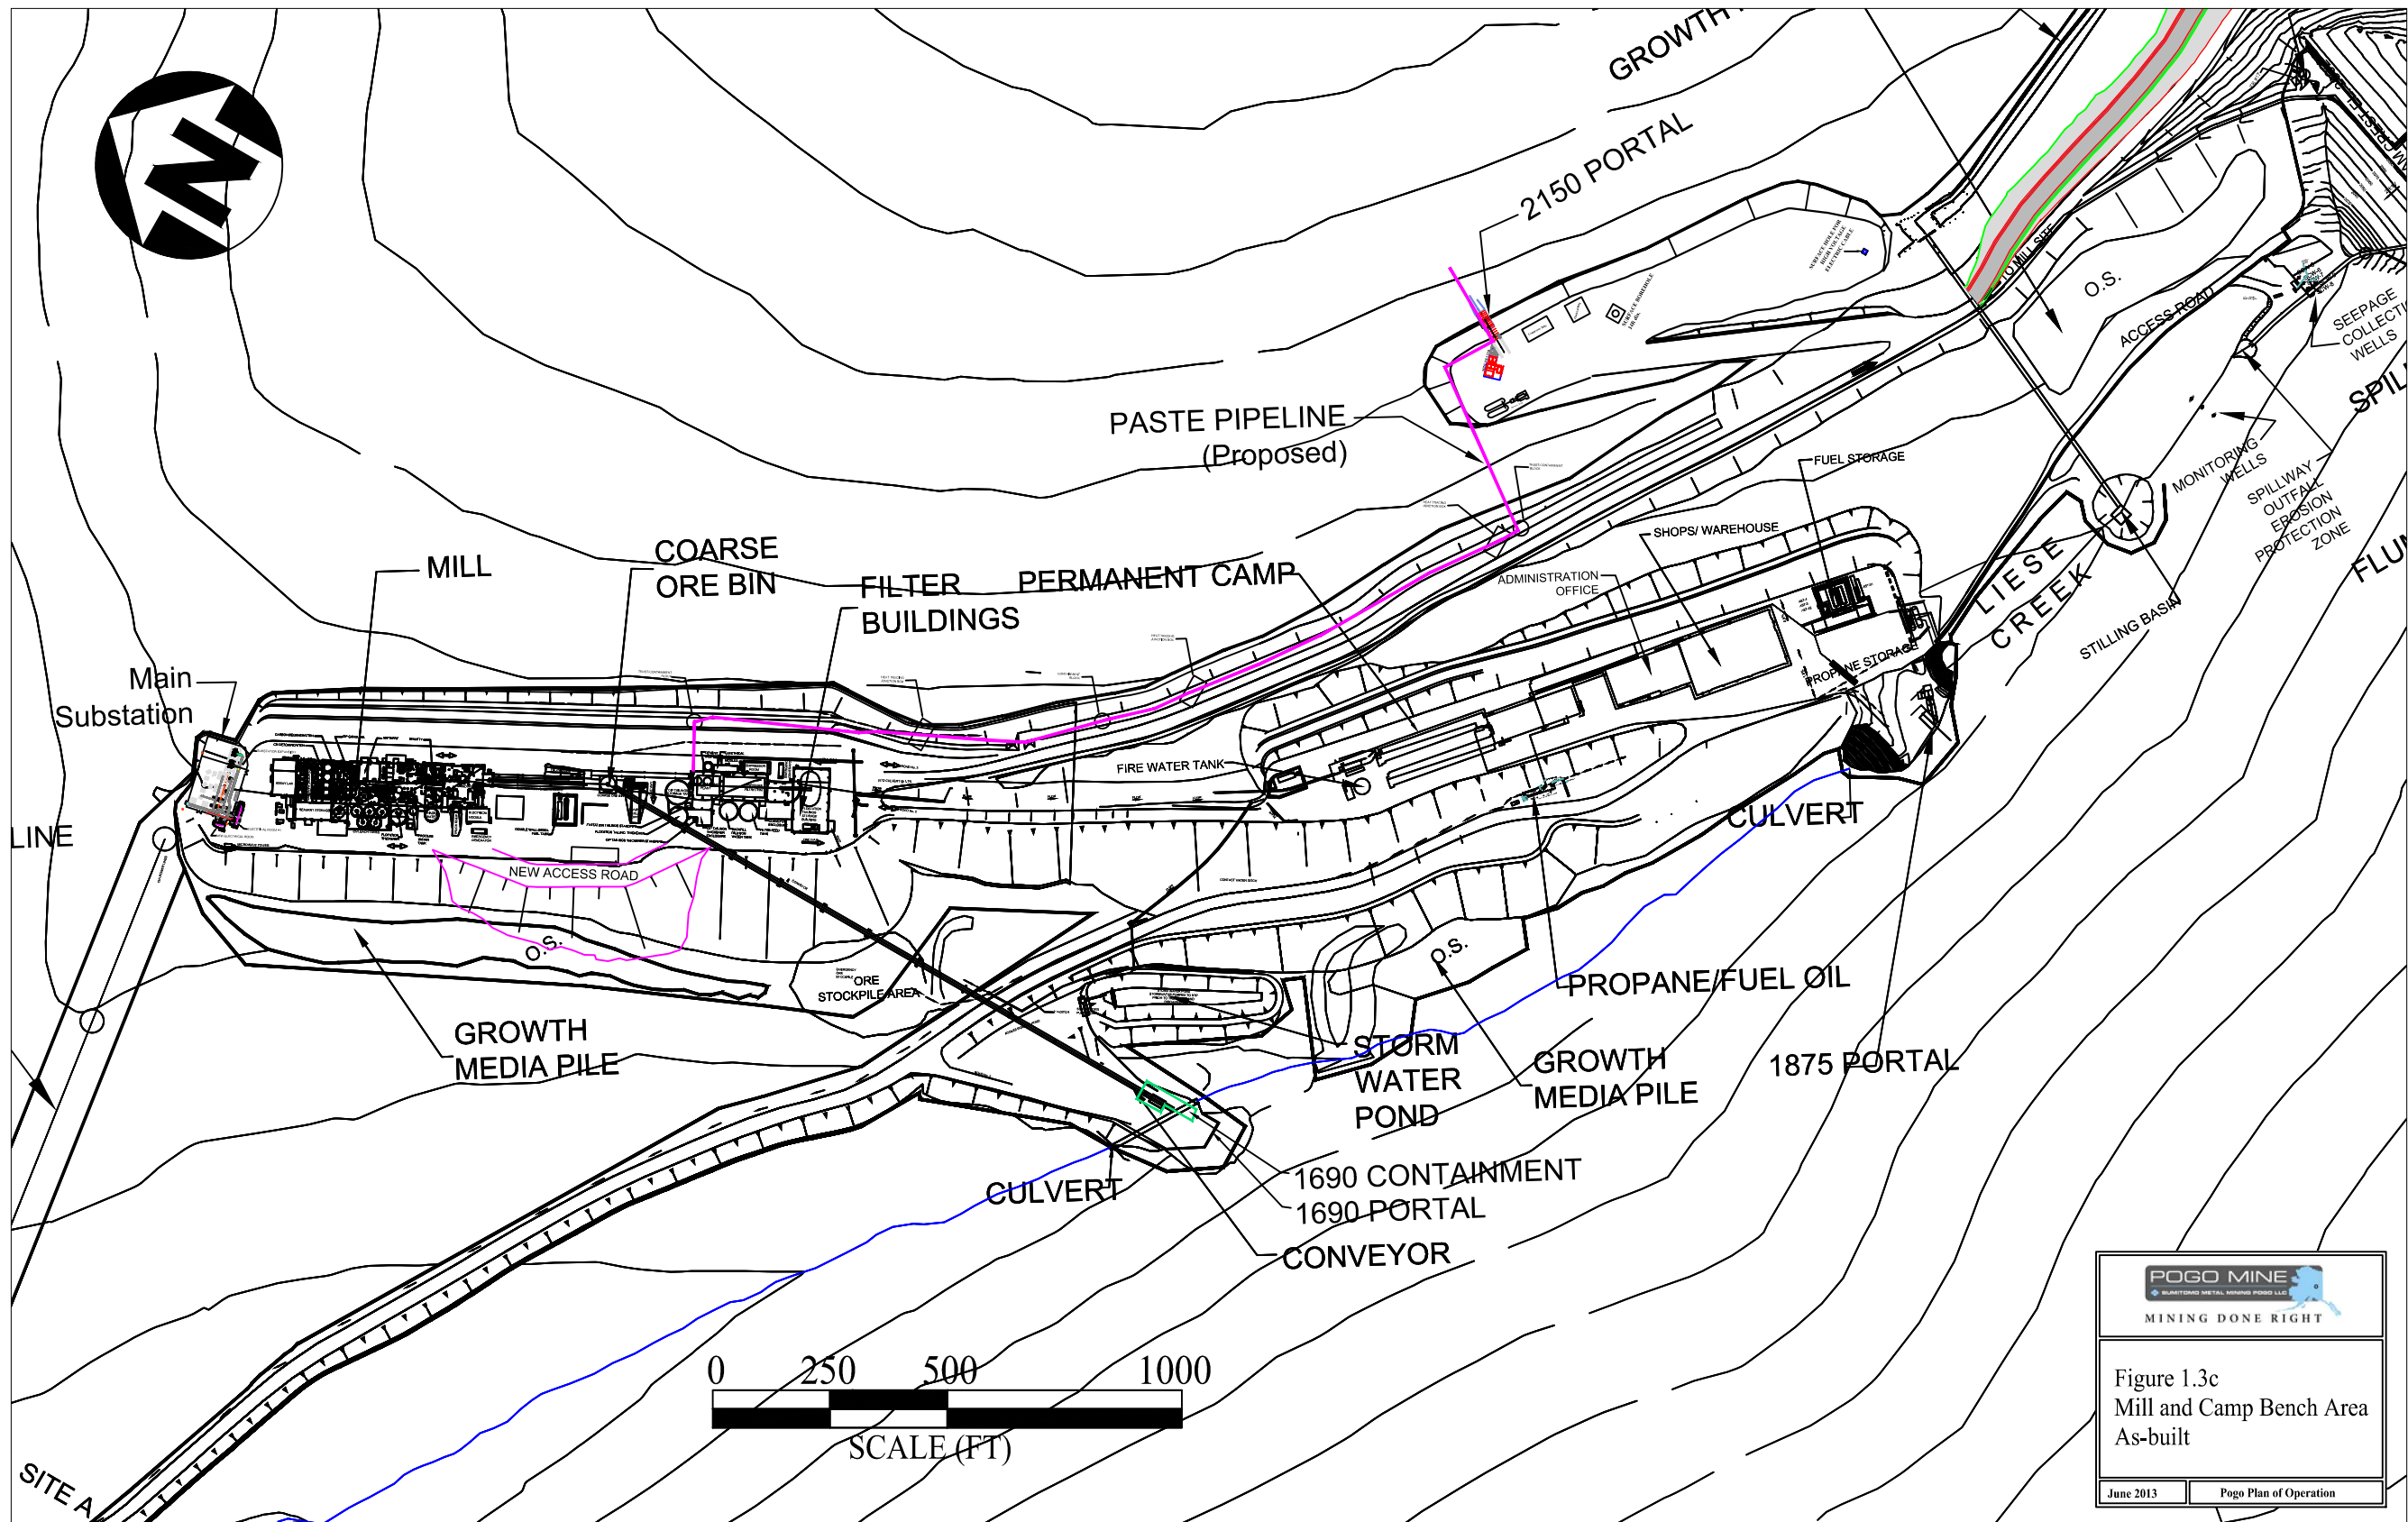




 MINING DONE RIGHT

Figure 1.3c
 Mill and Camp Bench Area
 As-built


June 2013 Pogo Plan of Operation

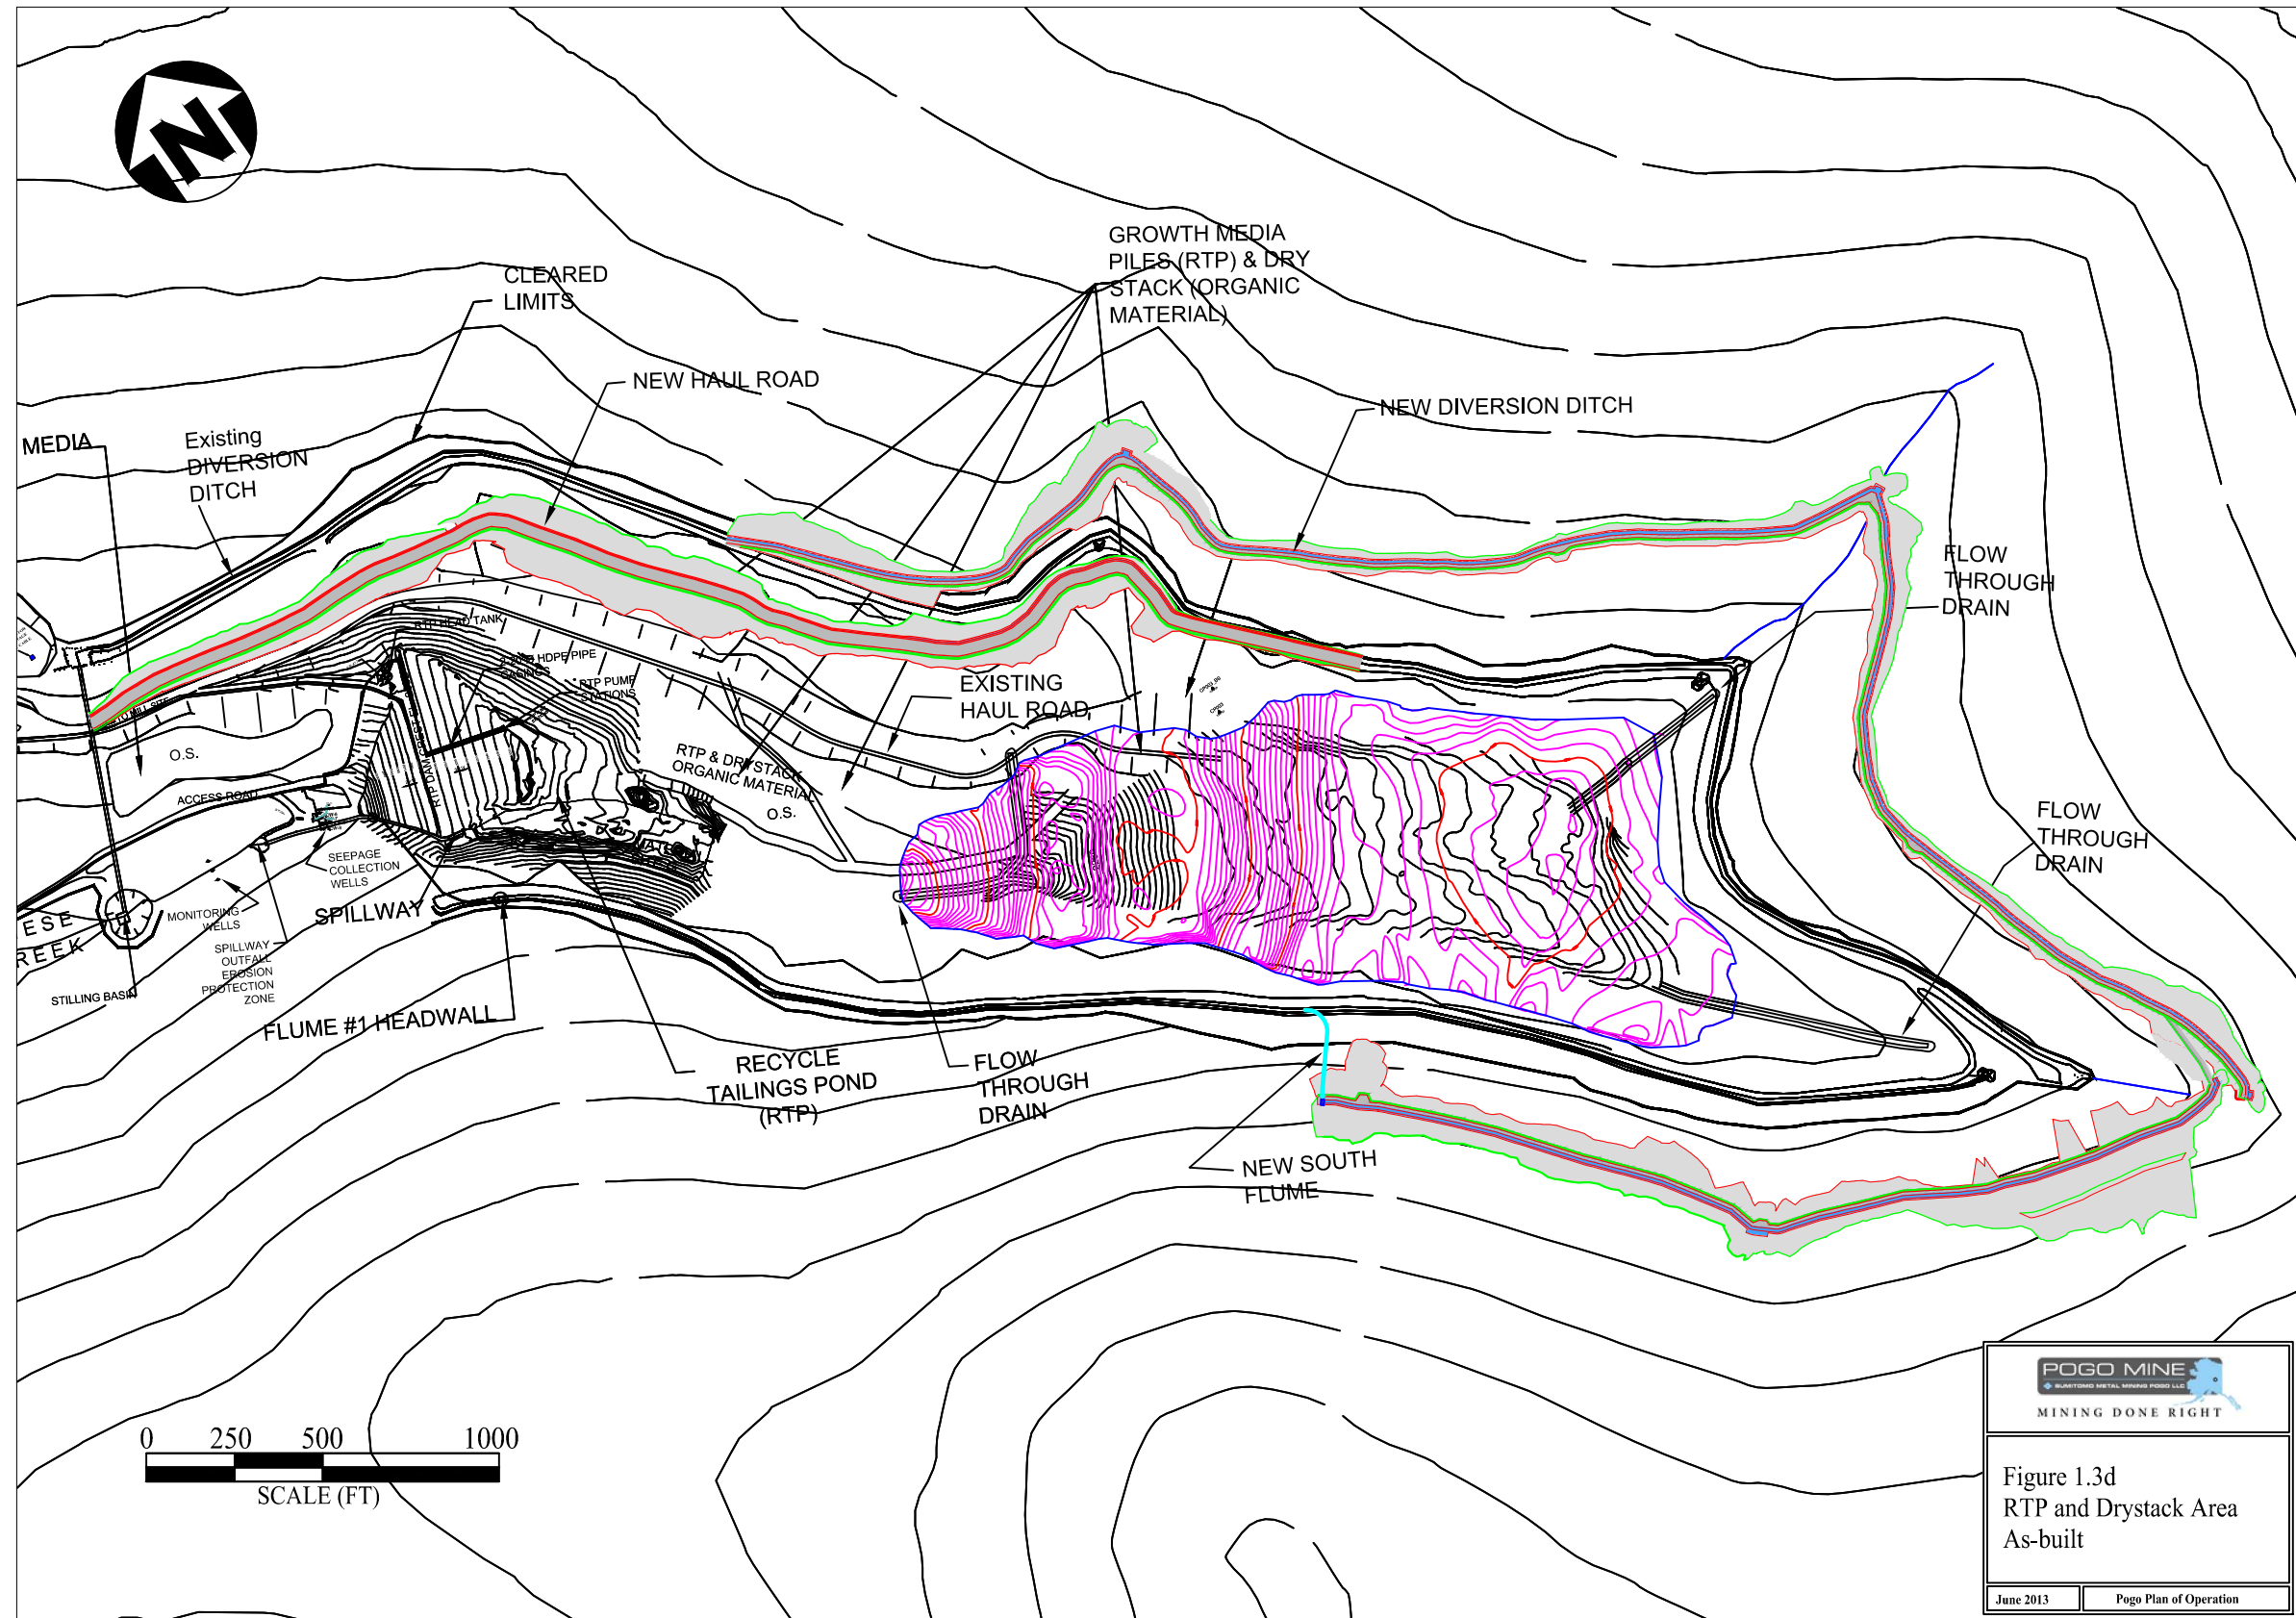



POGO MINE
MINING DONE RIGHT

Figure 1.3d
RTP and Drystack Area
As-built

June 2013 Pogo Plan of Operation

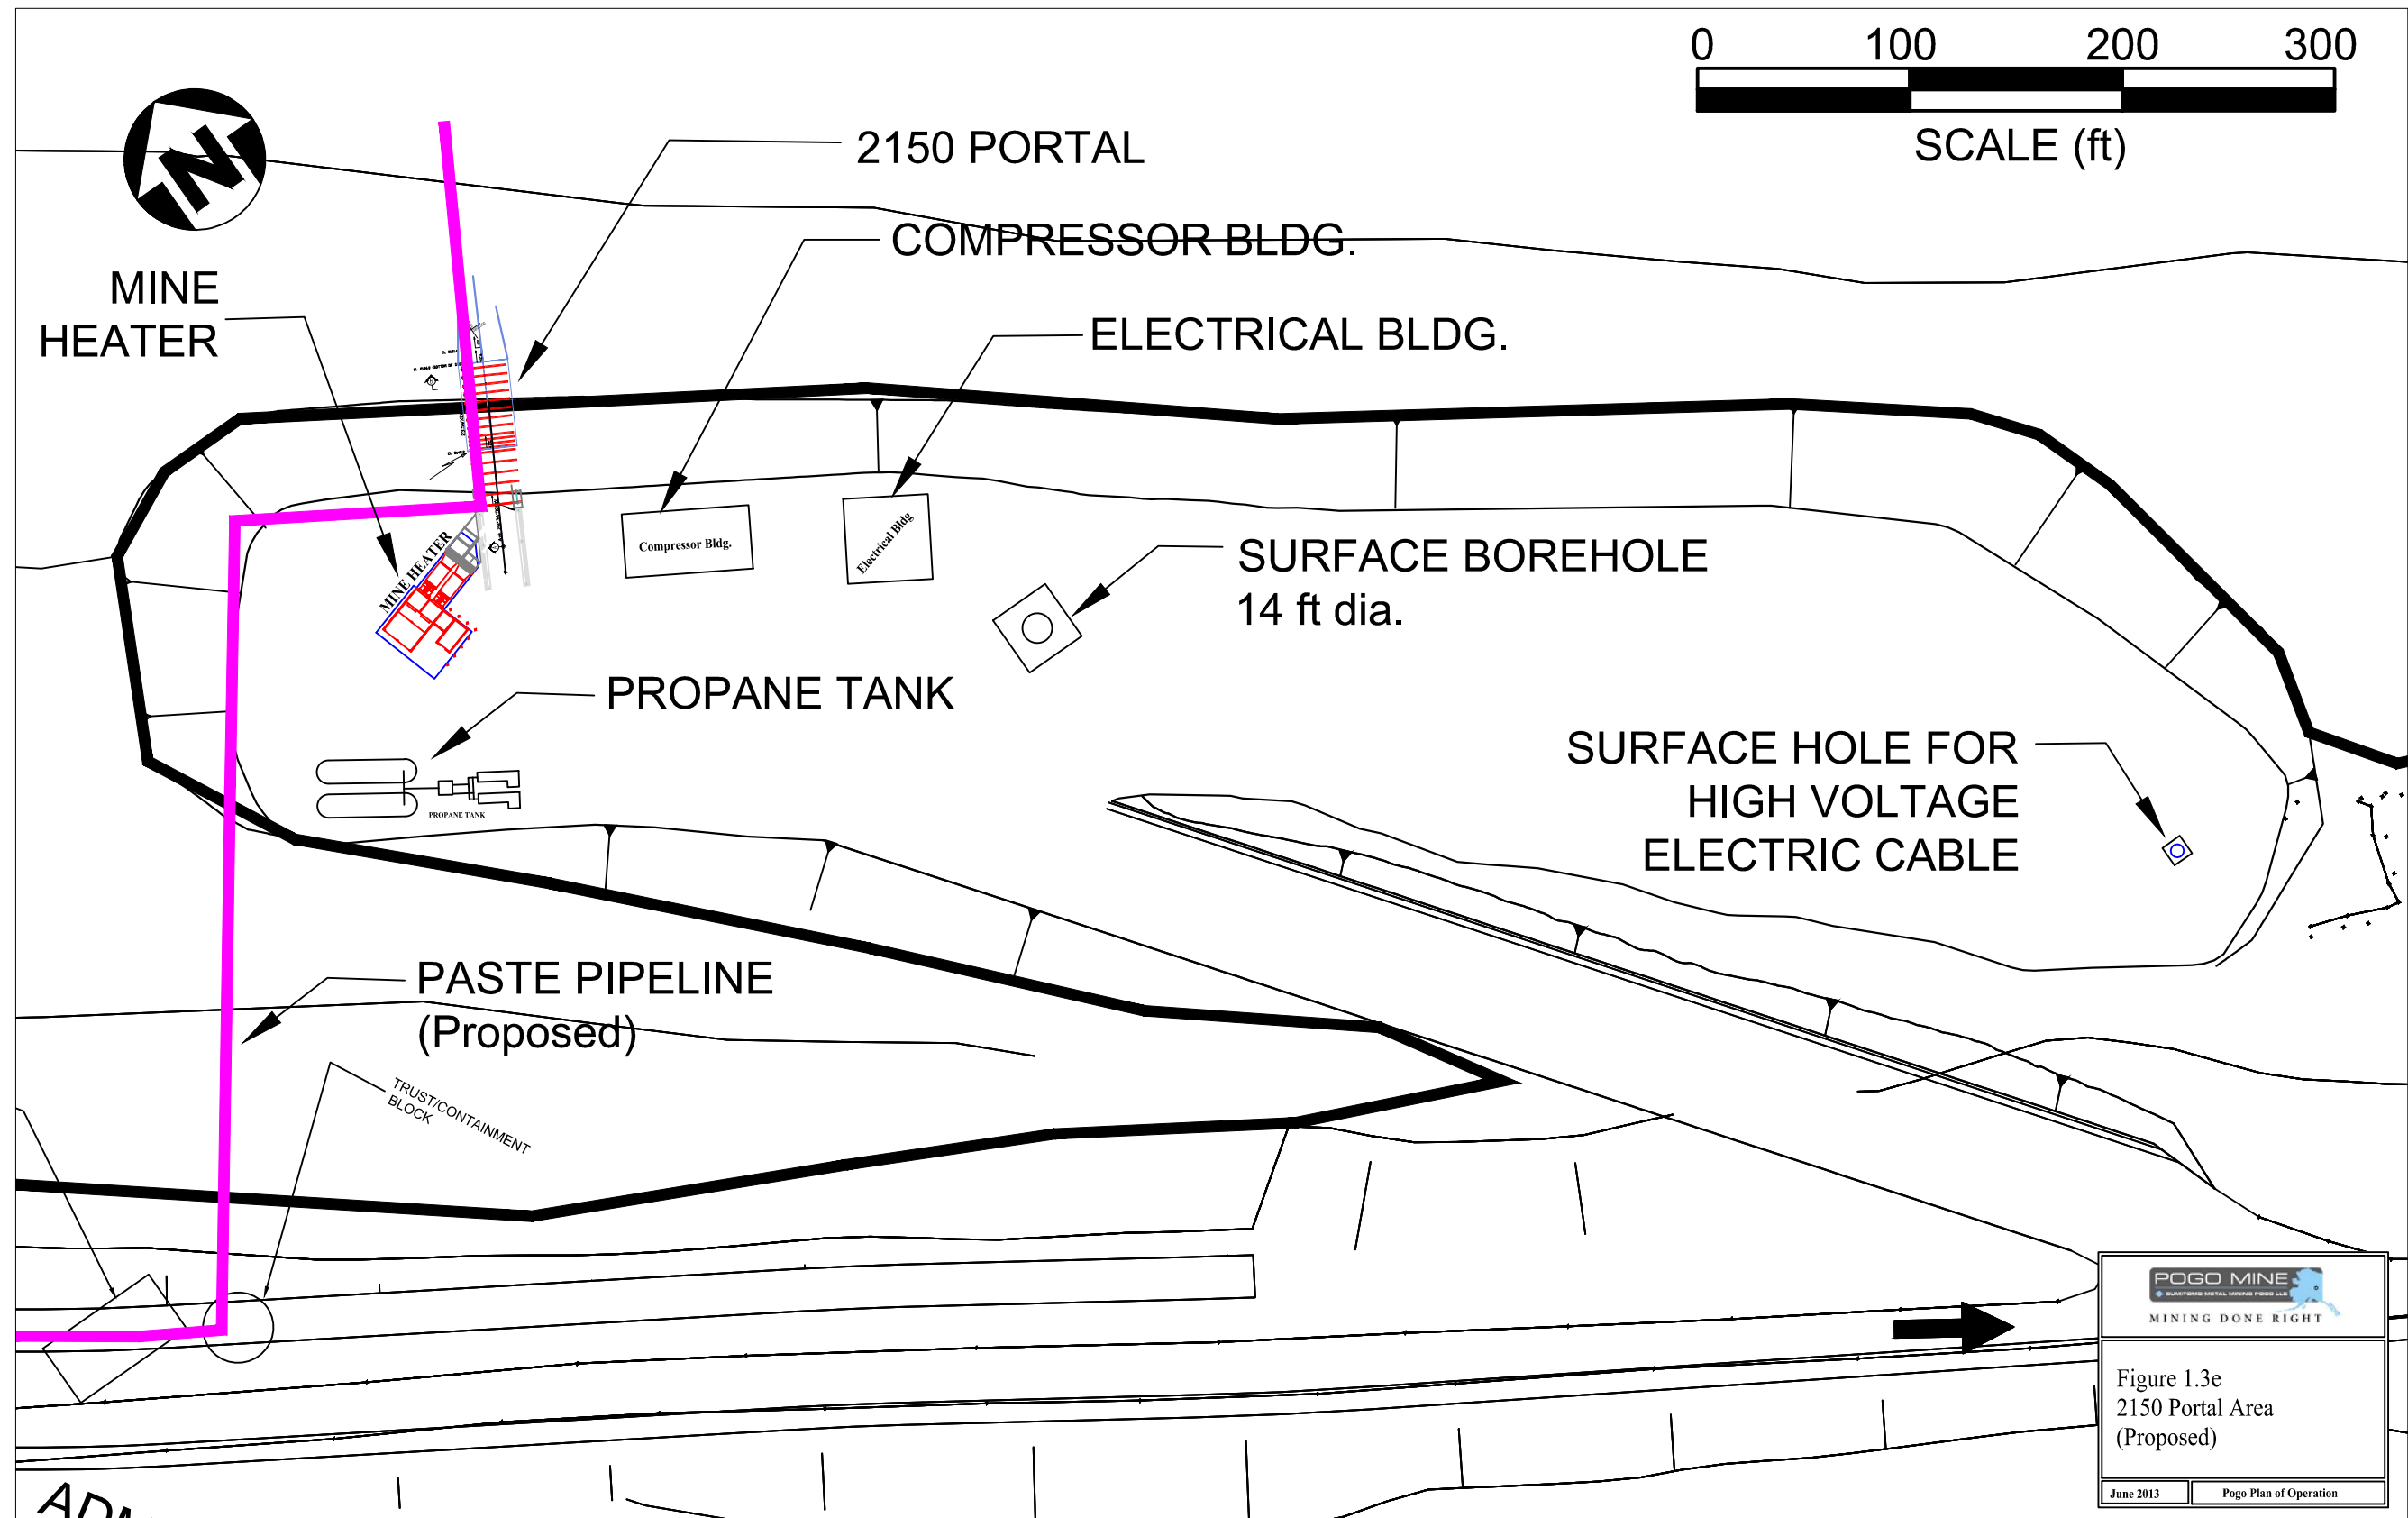

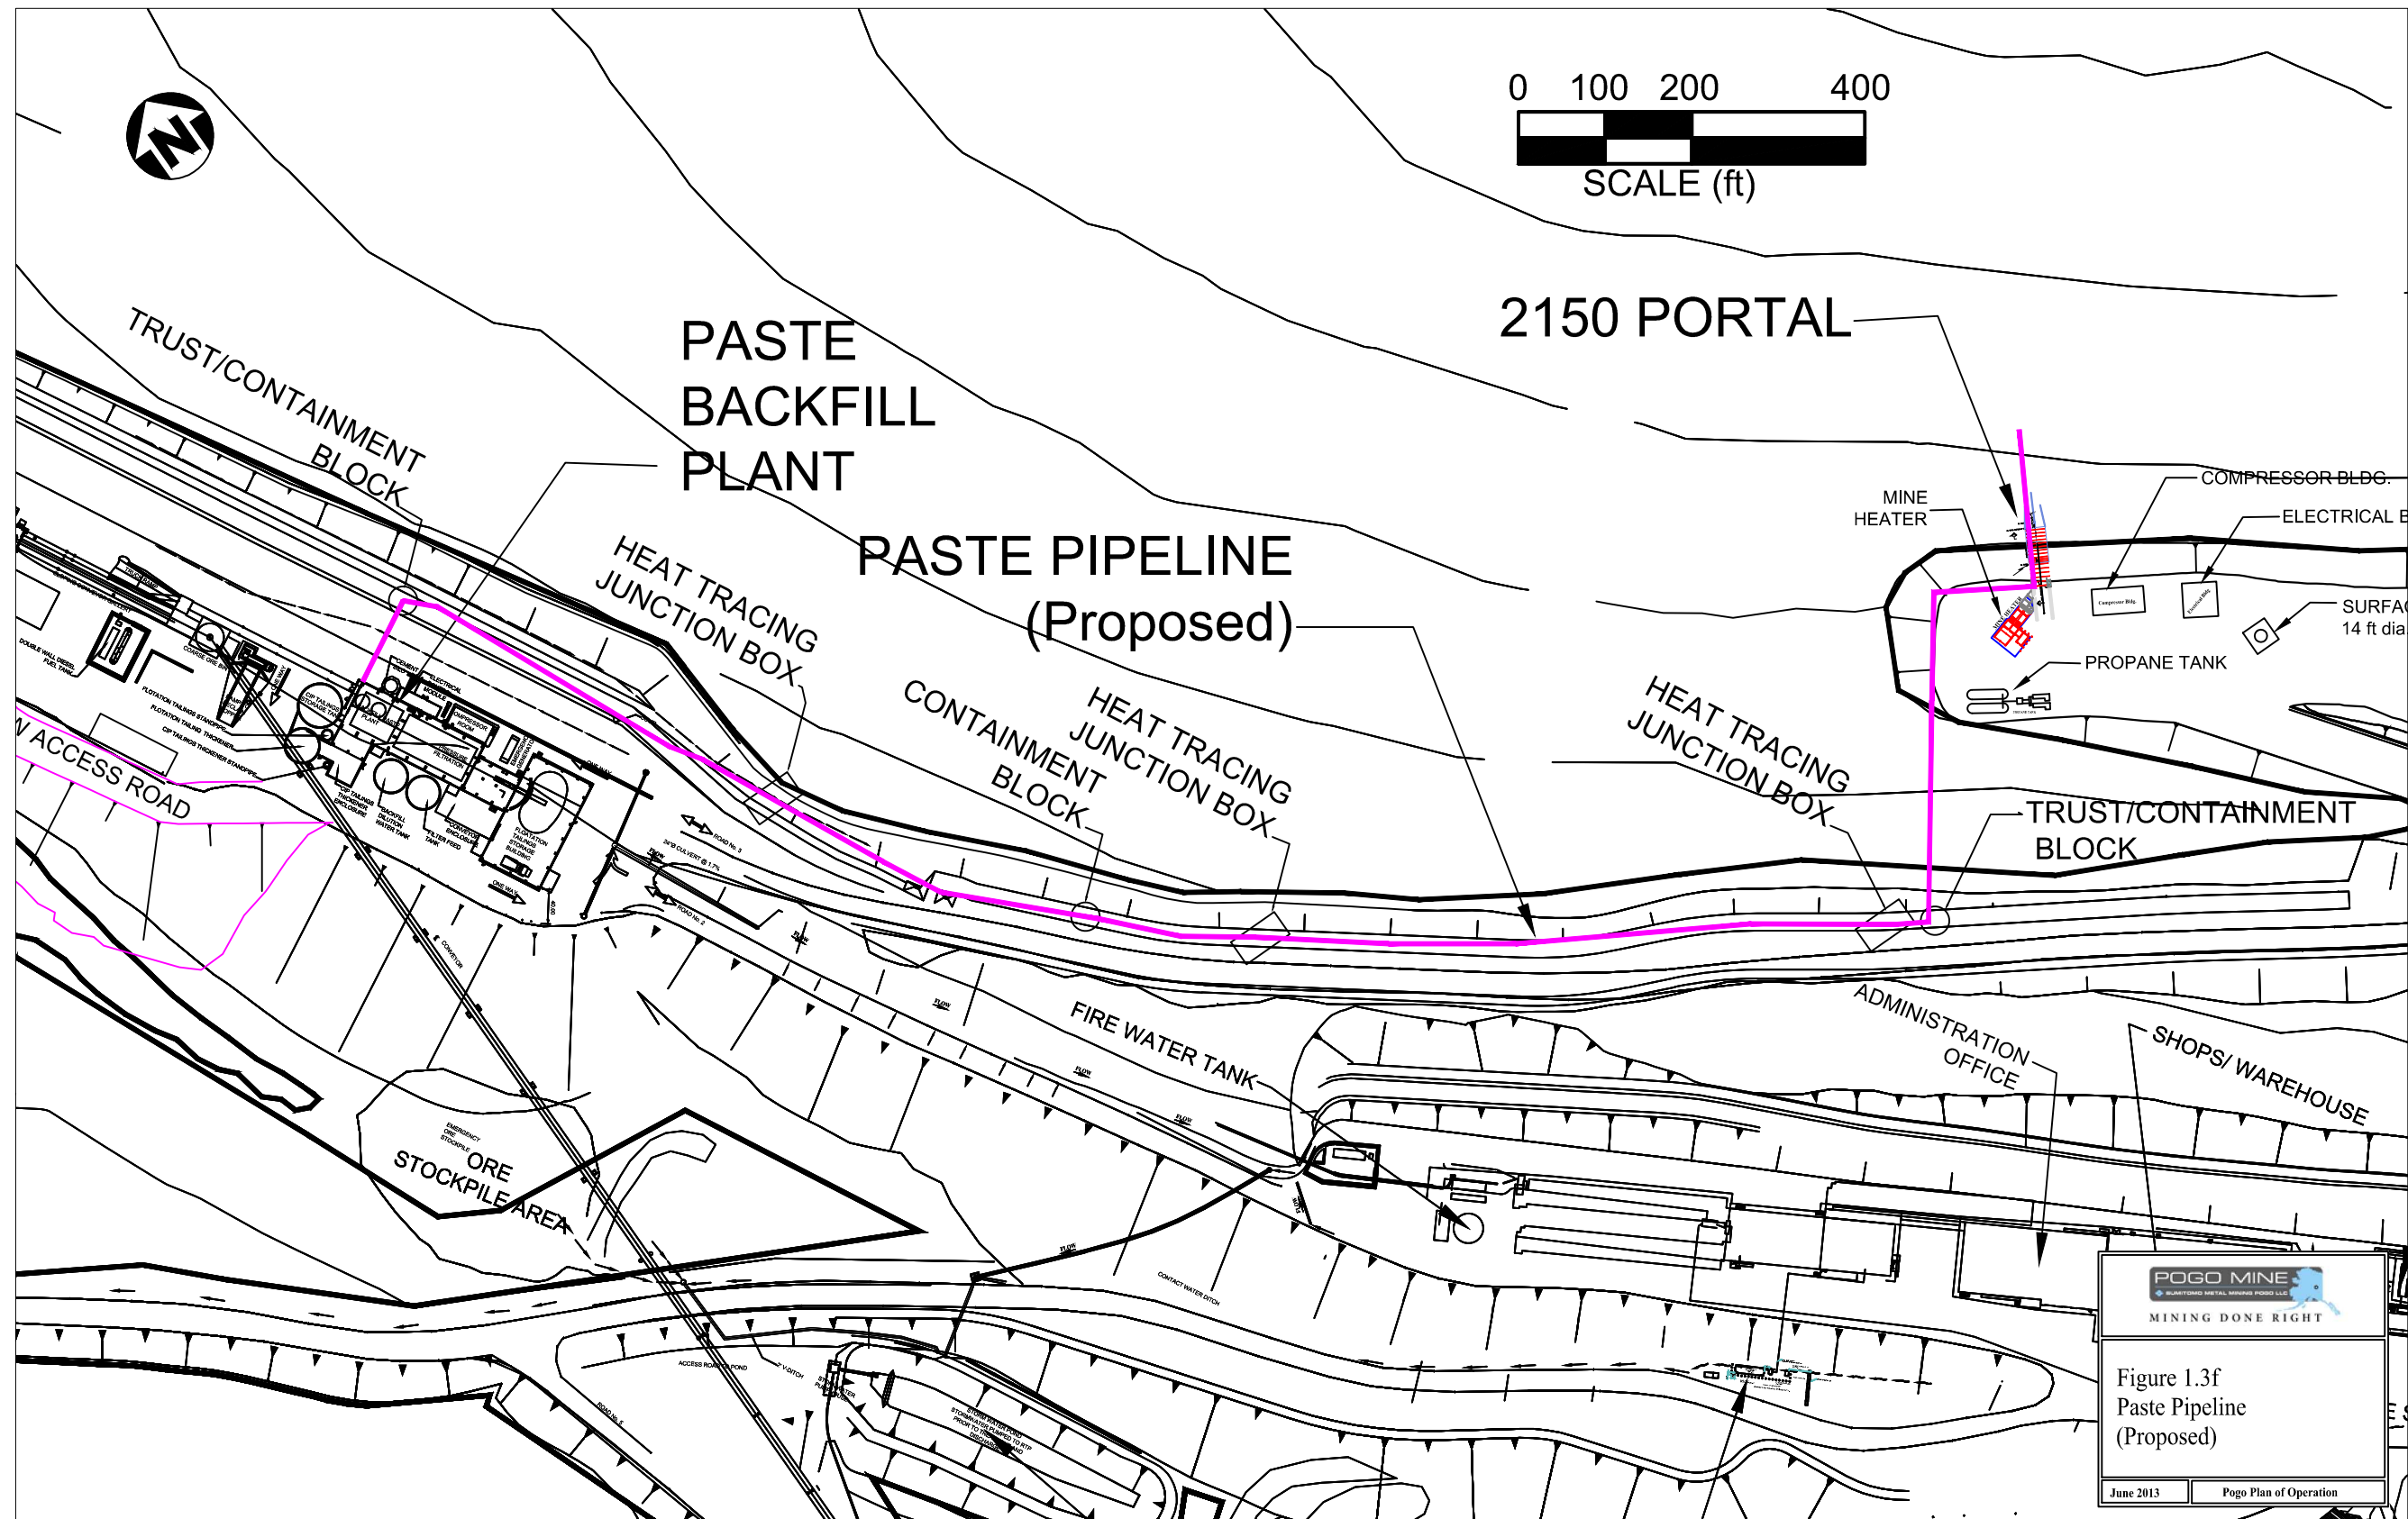

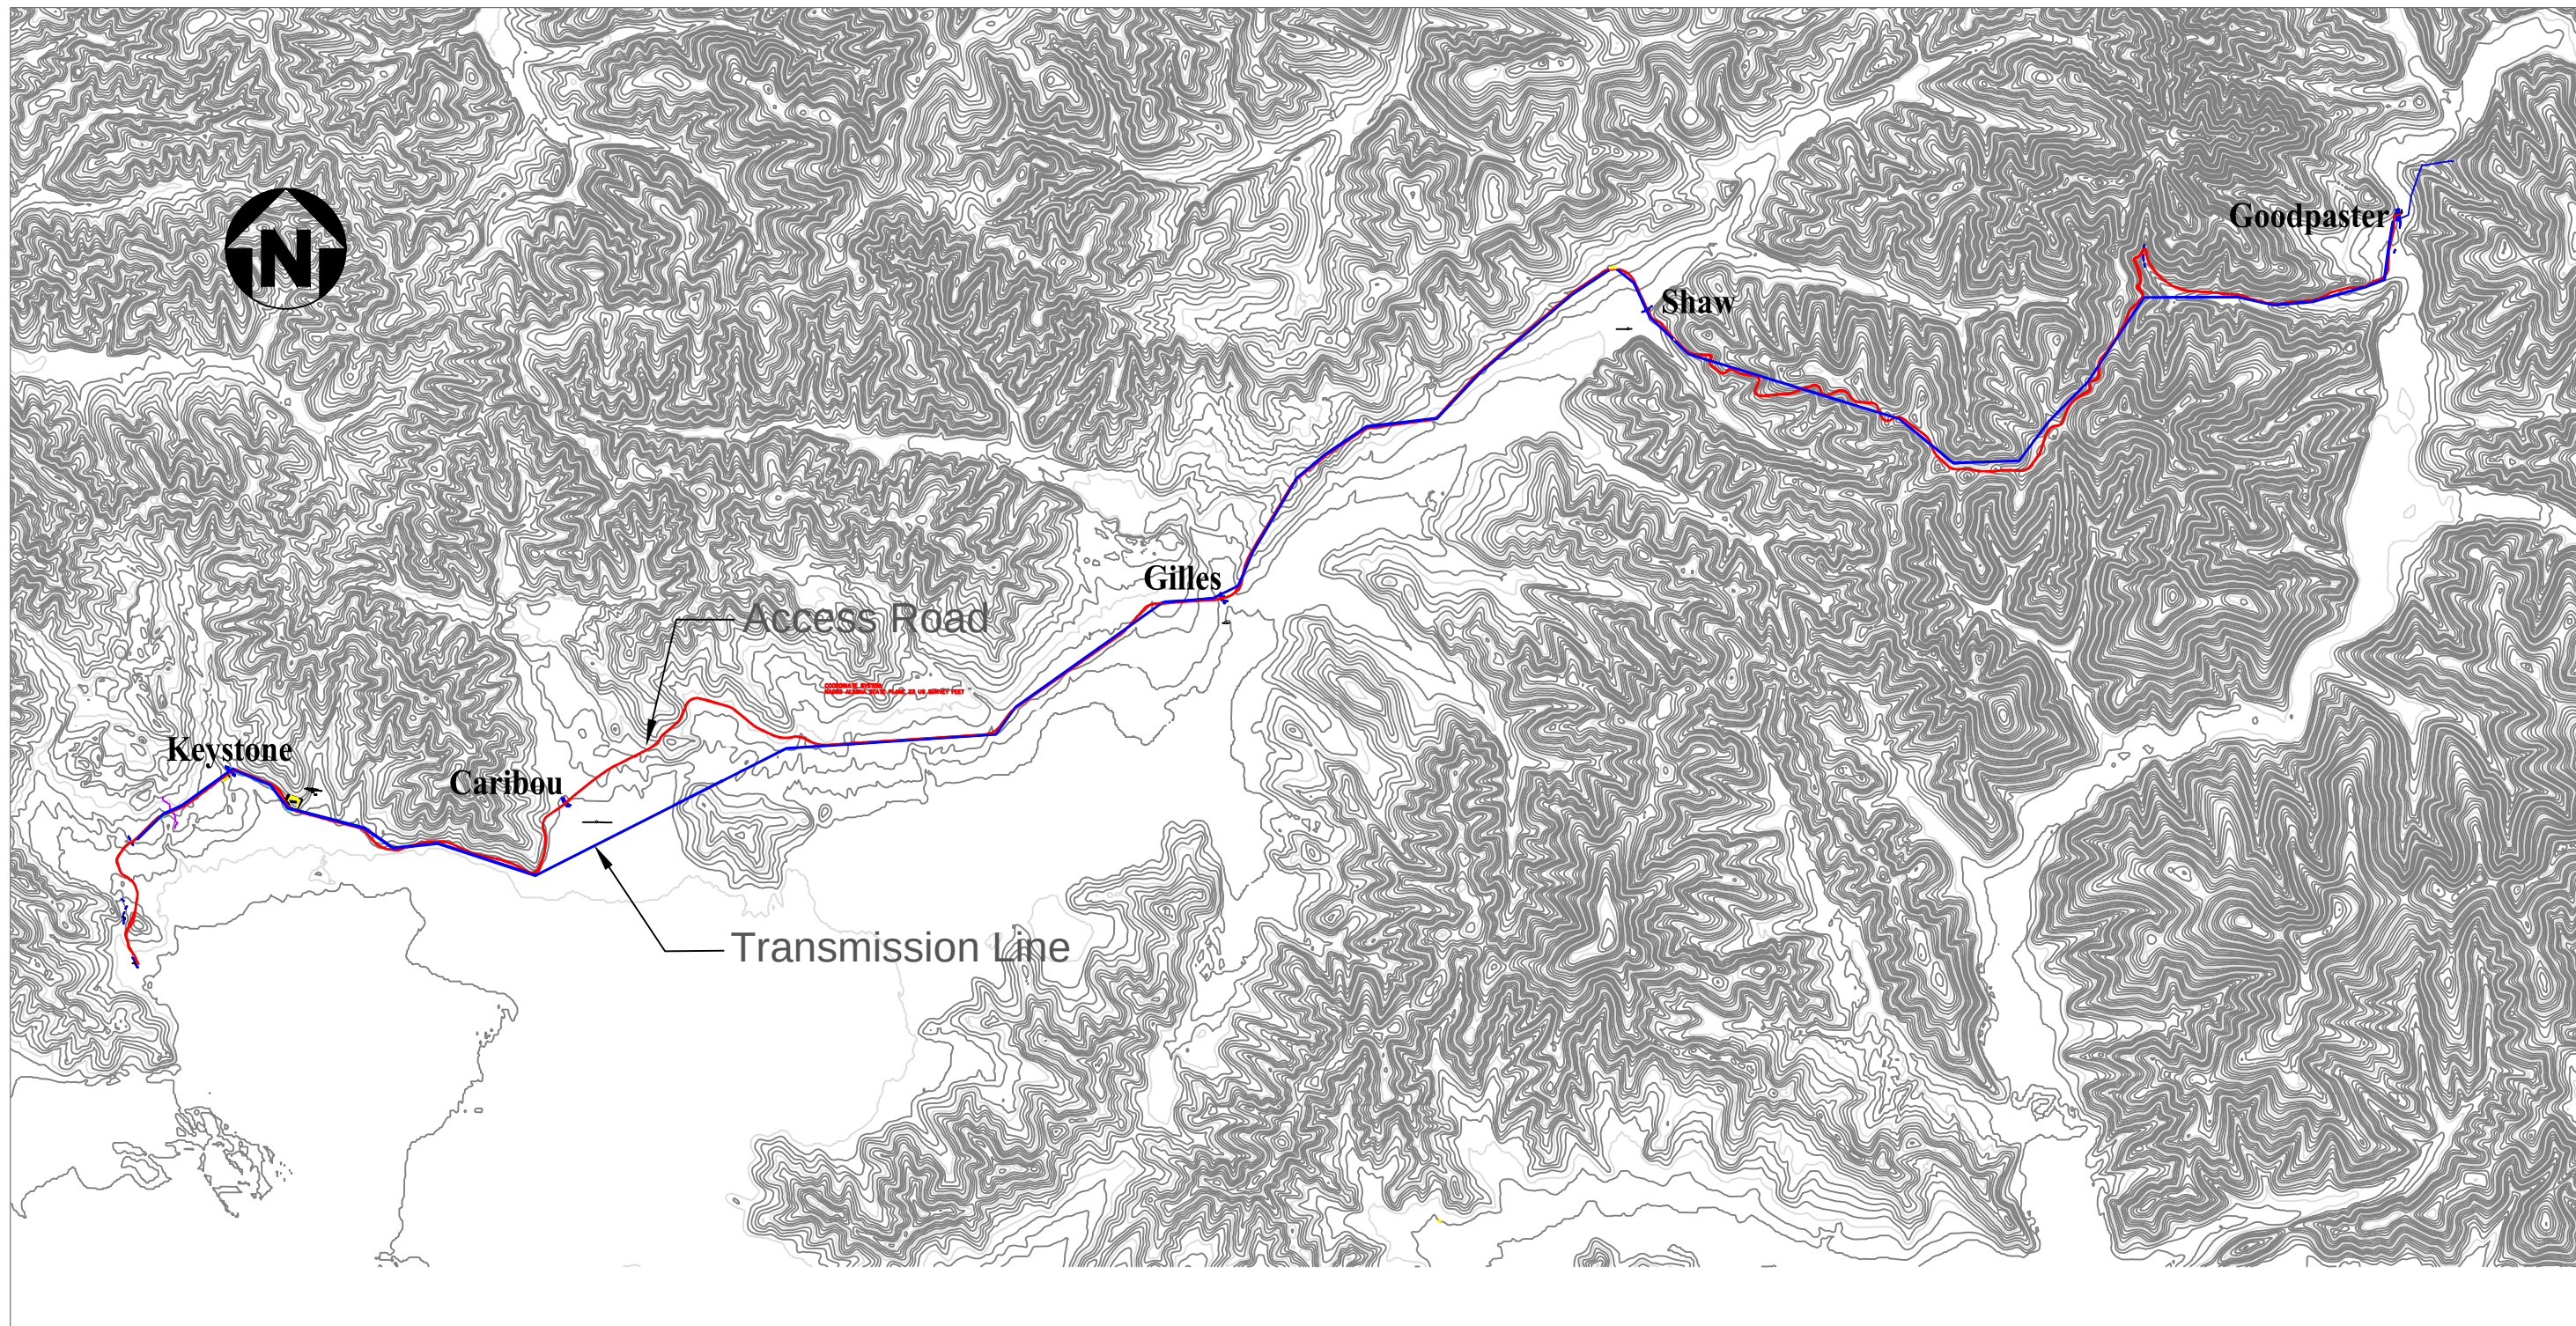


SCALE: 1 : 14000



Figure 4.1
Pogo Access Road and
Transmission Line

June 2013

Pogo Plan of Operation

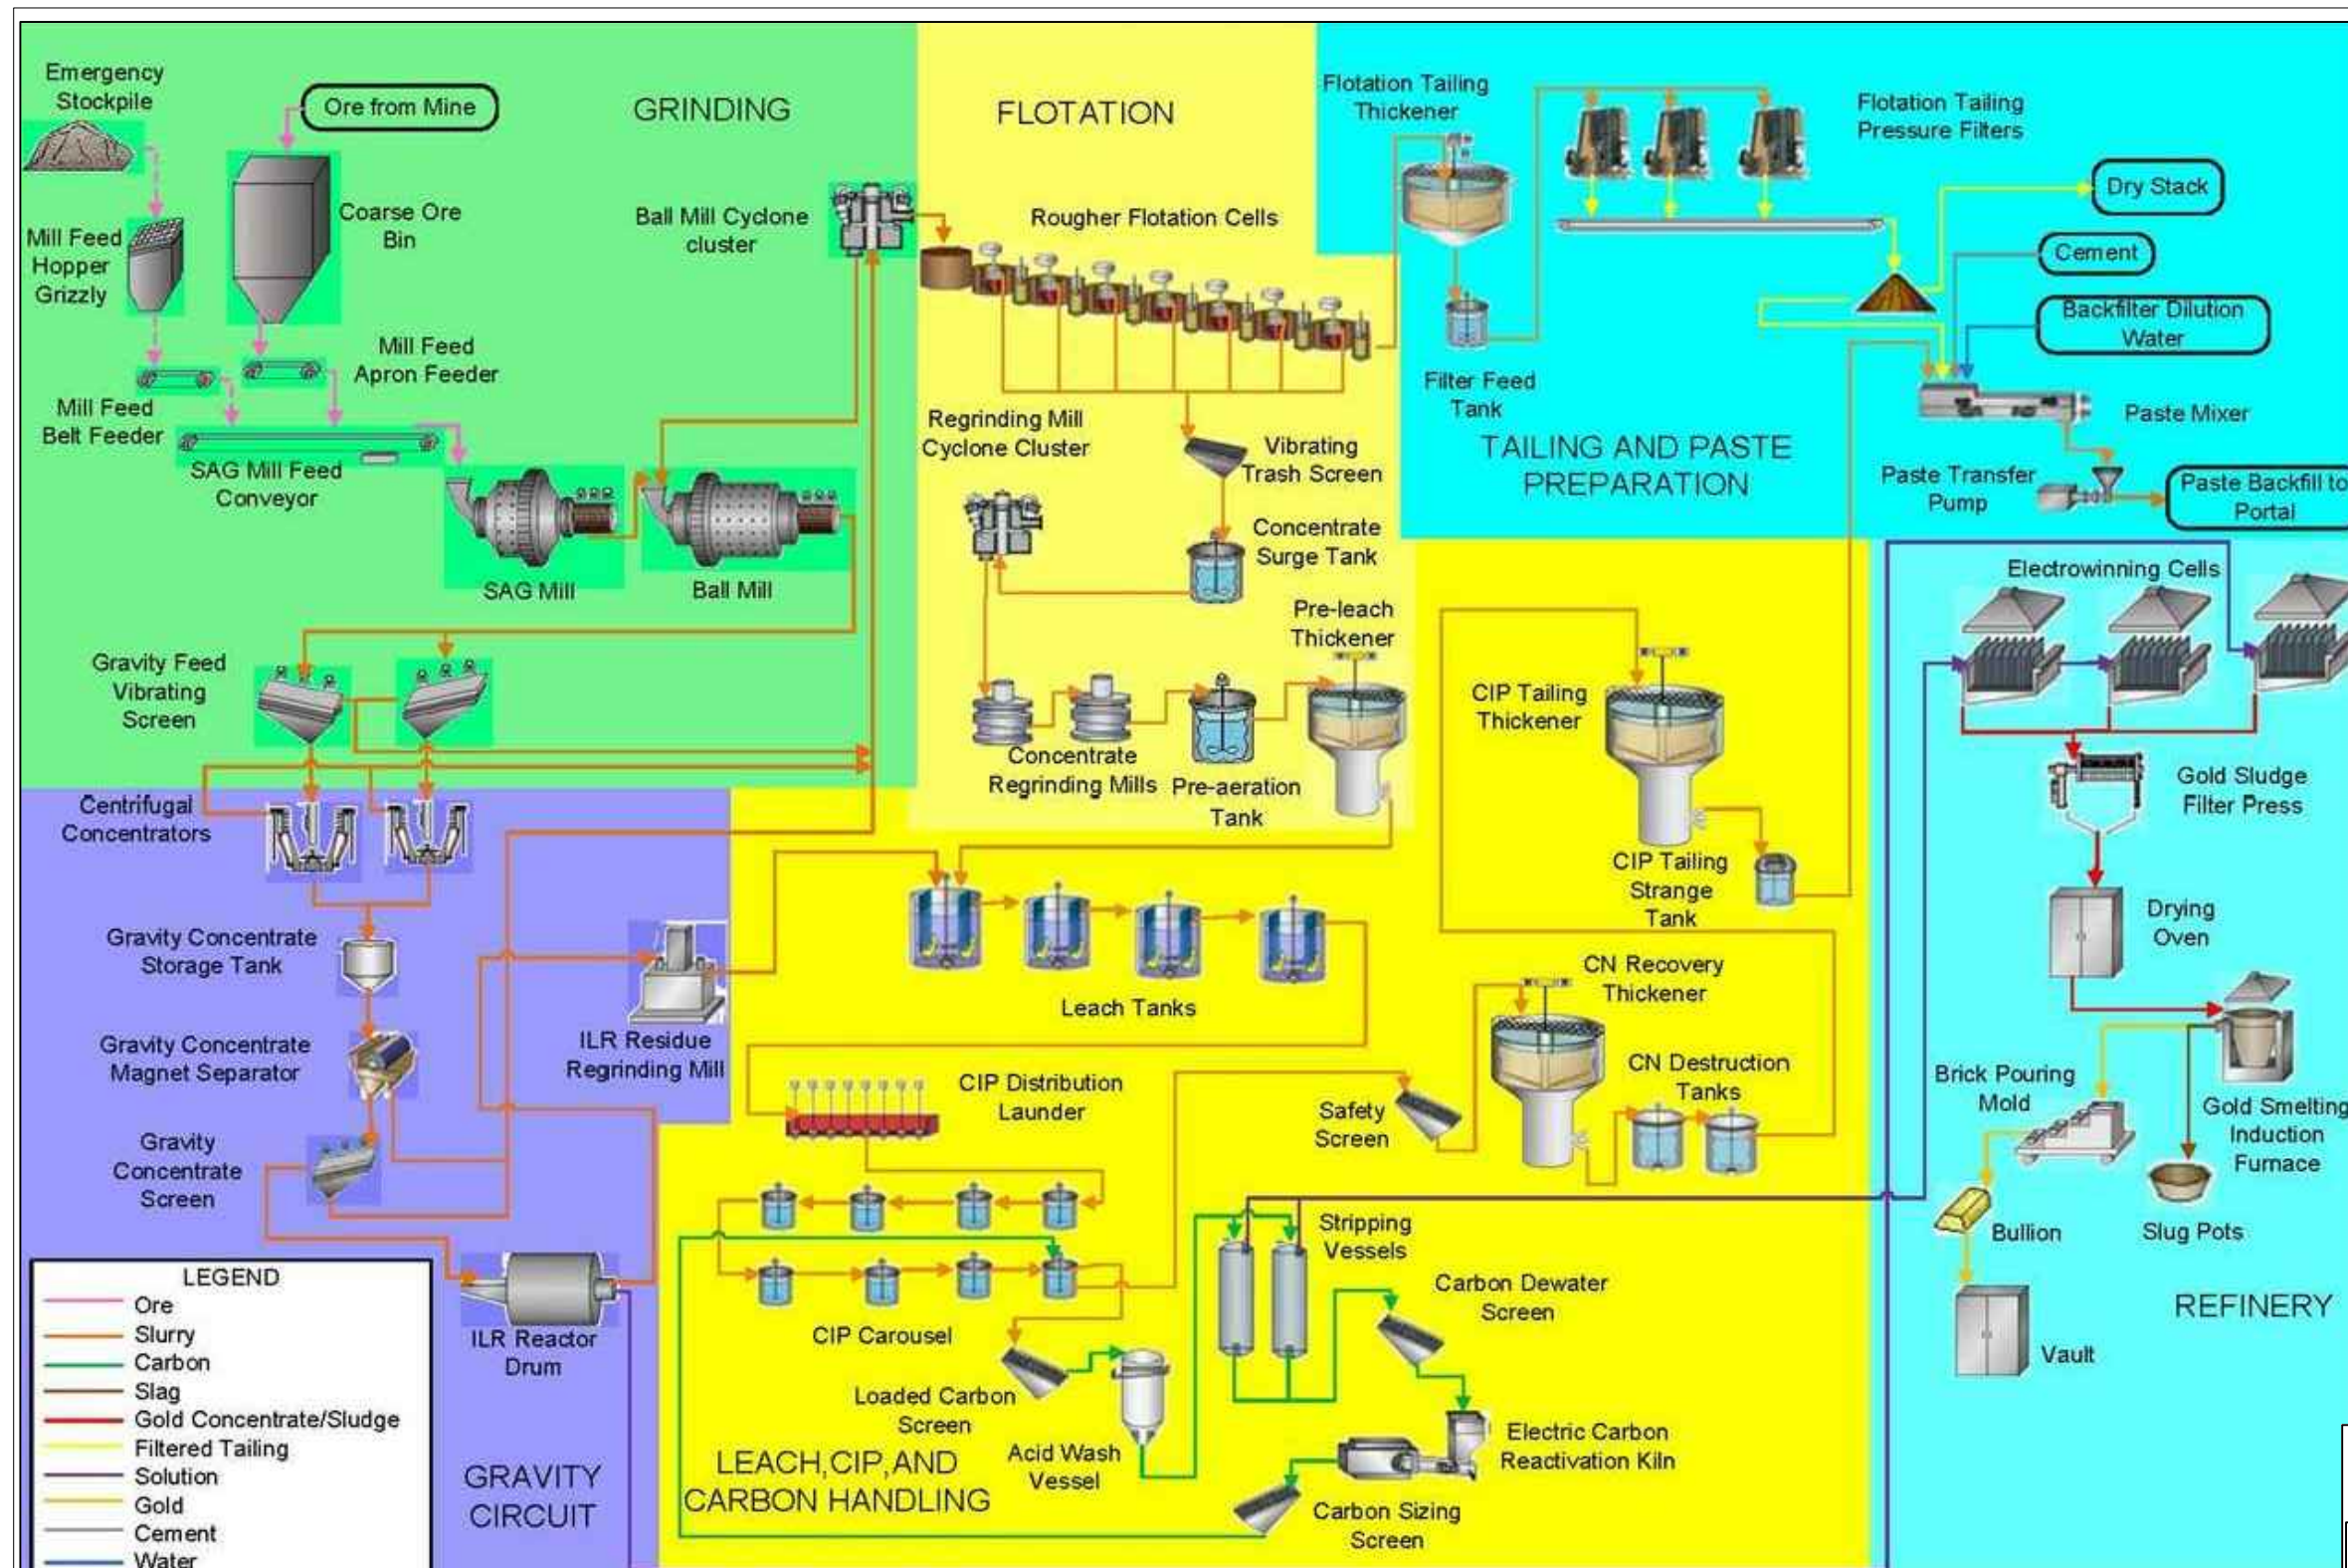

POGO MINE
MINING DONE RIGHT

Figure 6.1
Process Flow Diagram

June 2013 Pogo Plan of Operation

G:\Environmental\Plan of Ops and Reclamation Plan Working Copy\2013 Plan of Operation Rev 6 ED Mining\Figures for 2013 POO Rev 6 ED Mining\AutoCAD Files\201306 POO R6 Figure 7.1 DSTF 20 Million Tons.dwg

LEGEND

Existing Diversion Ditch

Proposed Diversion Ditch

Extent of Year 2030 Material Placement

Rock Drain Extension Required for Year 2030

Green Rock Outer Shell

GPA Materials


Tailings

NOTES



1. Contour interval is 10ft.

2. Base contour data received from POGO mine site dated May 20, 2010.

3. 20 M ton configuration developed for assessment of proposed ultimate configuration.

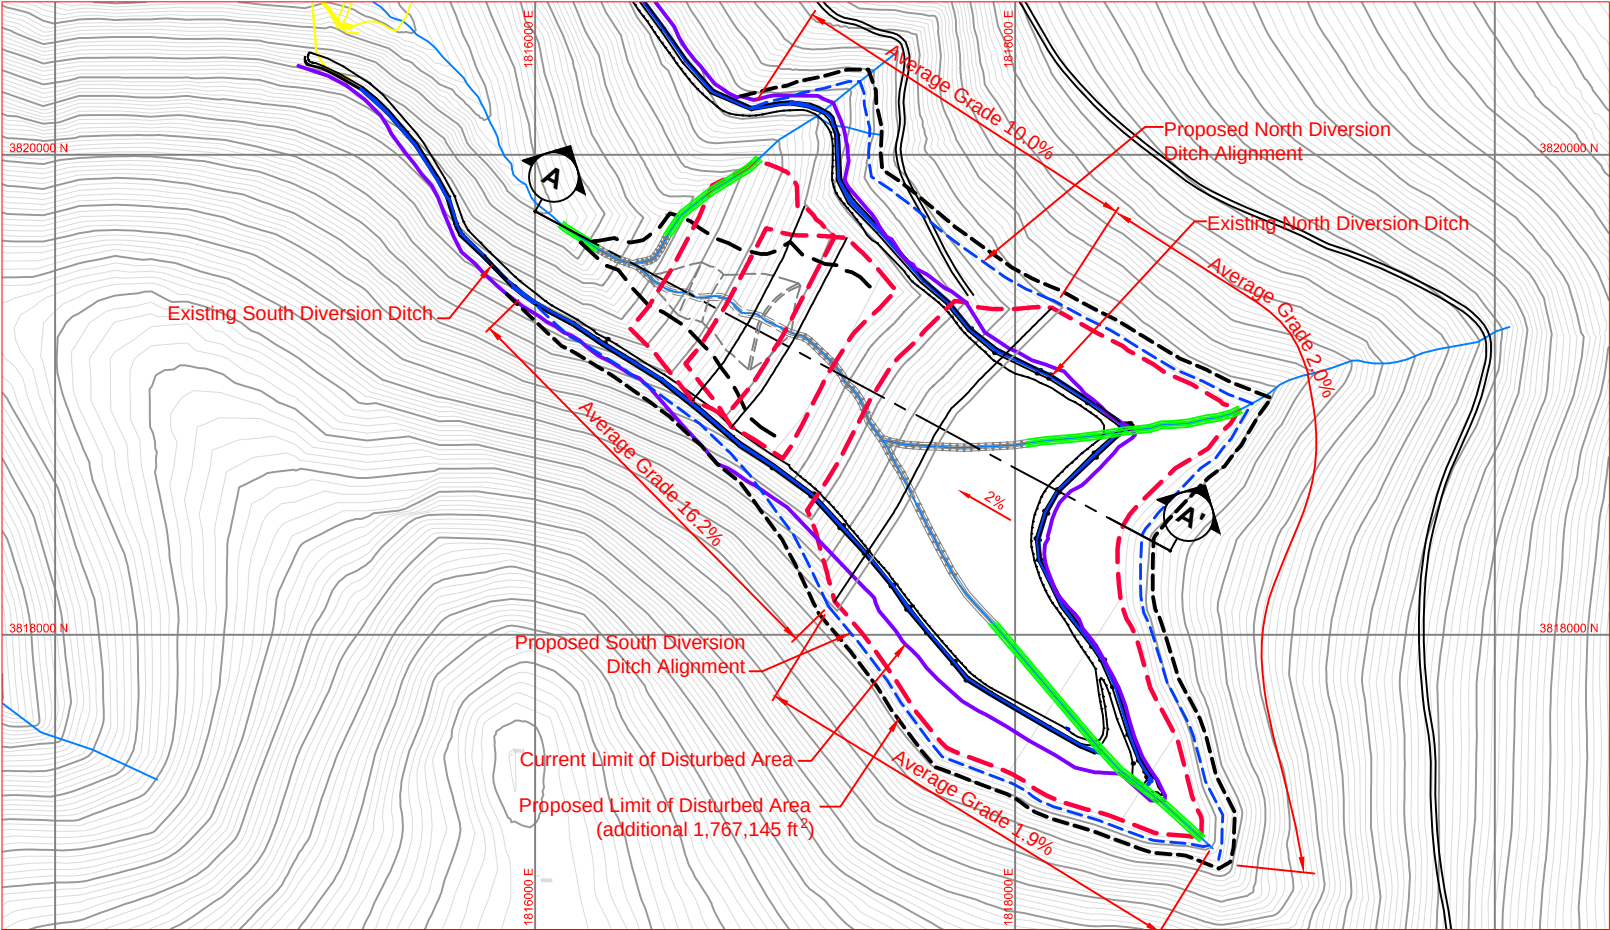

PLAN VIEW
DRY STACK STORAGE AREA

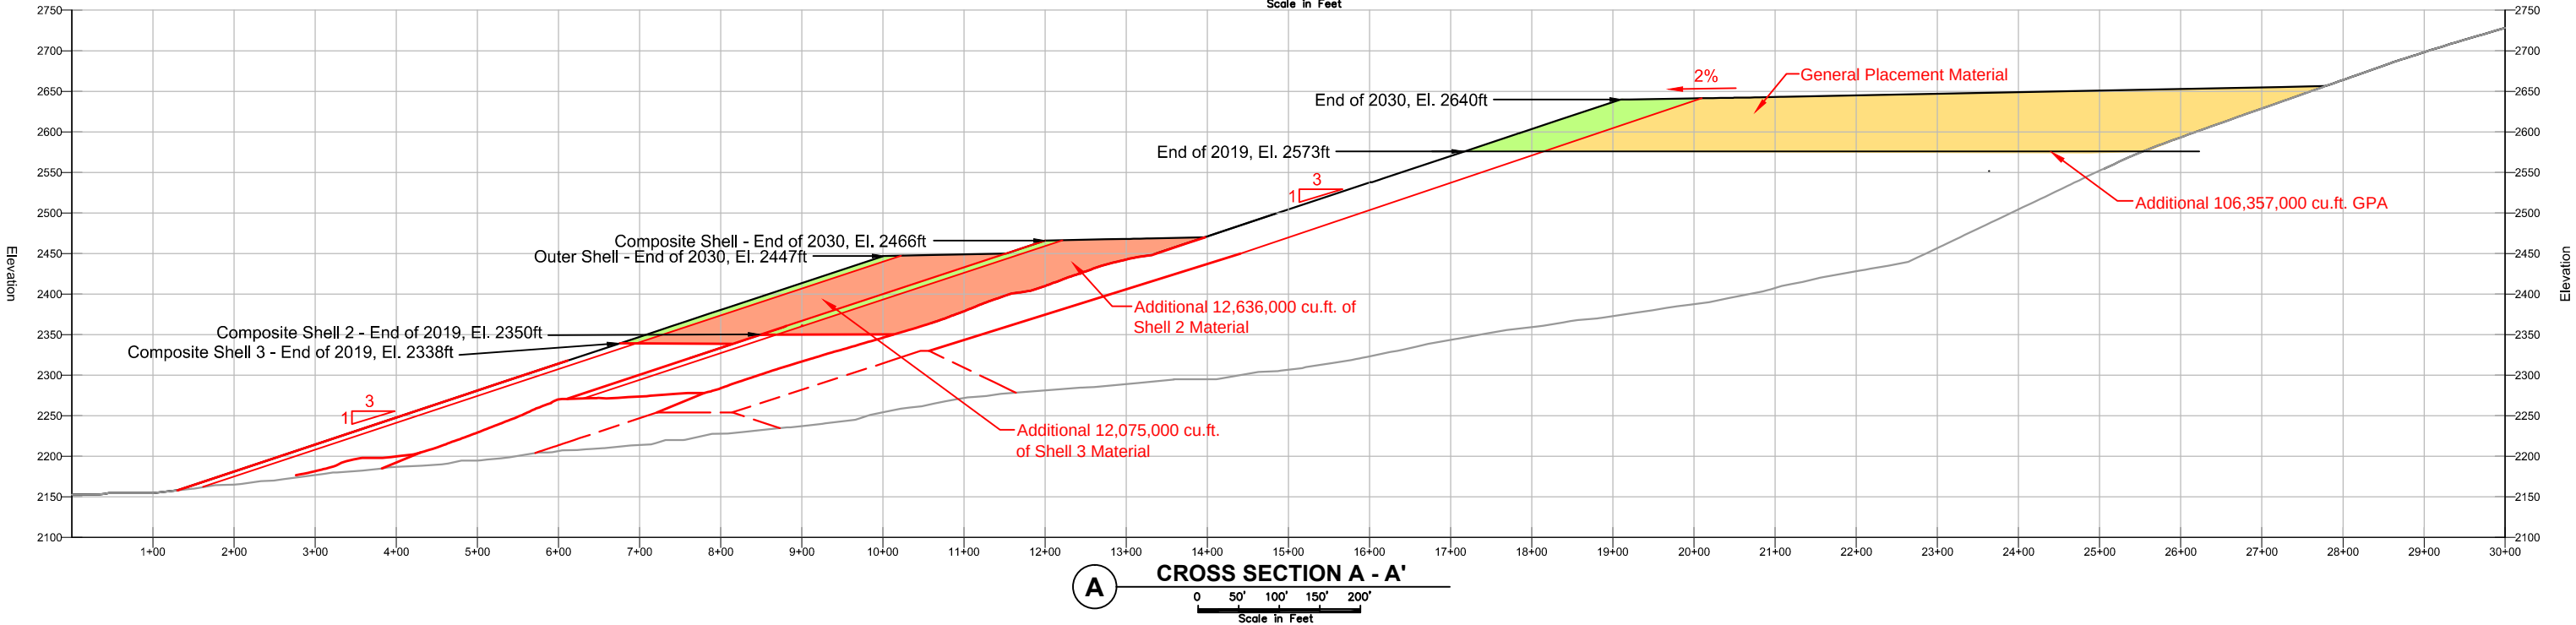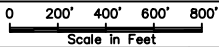

A CROSS SECTION A - A'
Scale in Feet
0 50' 100' 150' 200'



SRK JOB NO.:
FILE NAME:

POGO MINE

Figure 7.1
Dry Stack Tailings Facility
20 million Tons

DATE: 6/22/13	APPROVED:	DRAWING: ---
------------------	-----------	-----------------

— Diversion Ditch


Rock Drain Extension for Year 2012

 Green Rock Outer Shell


 Dry Stack Material

Tailings

1. Contour interval is 5ft.
2. Base contour data received from POGO mine site.

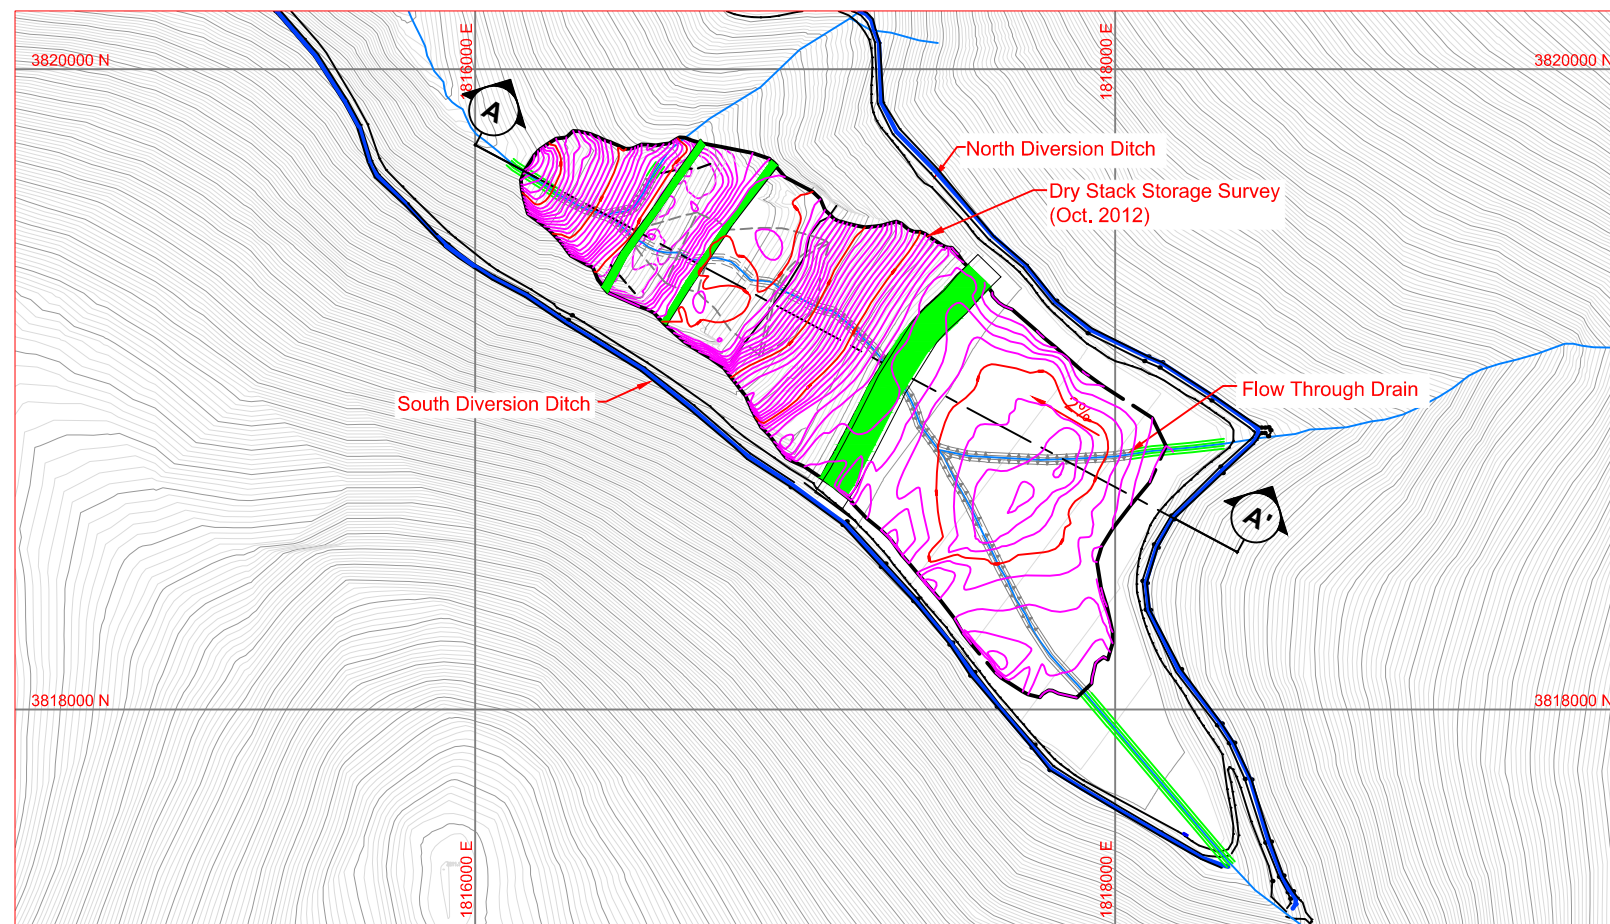


PLAN VIEW
DRY STACK STORAGE AREA

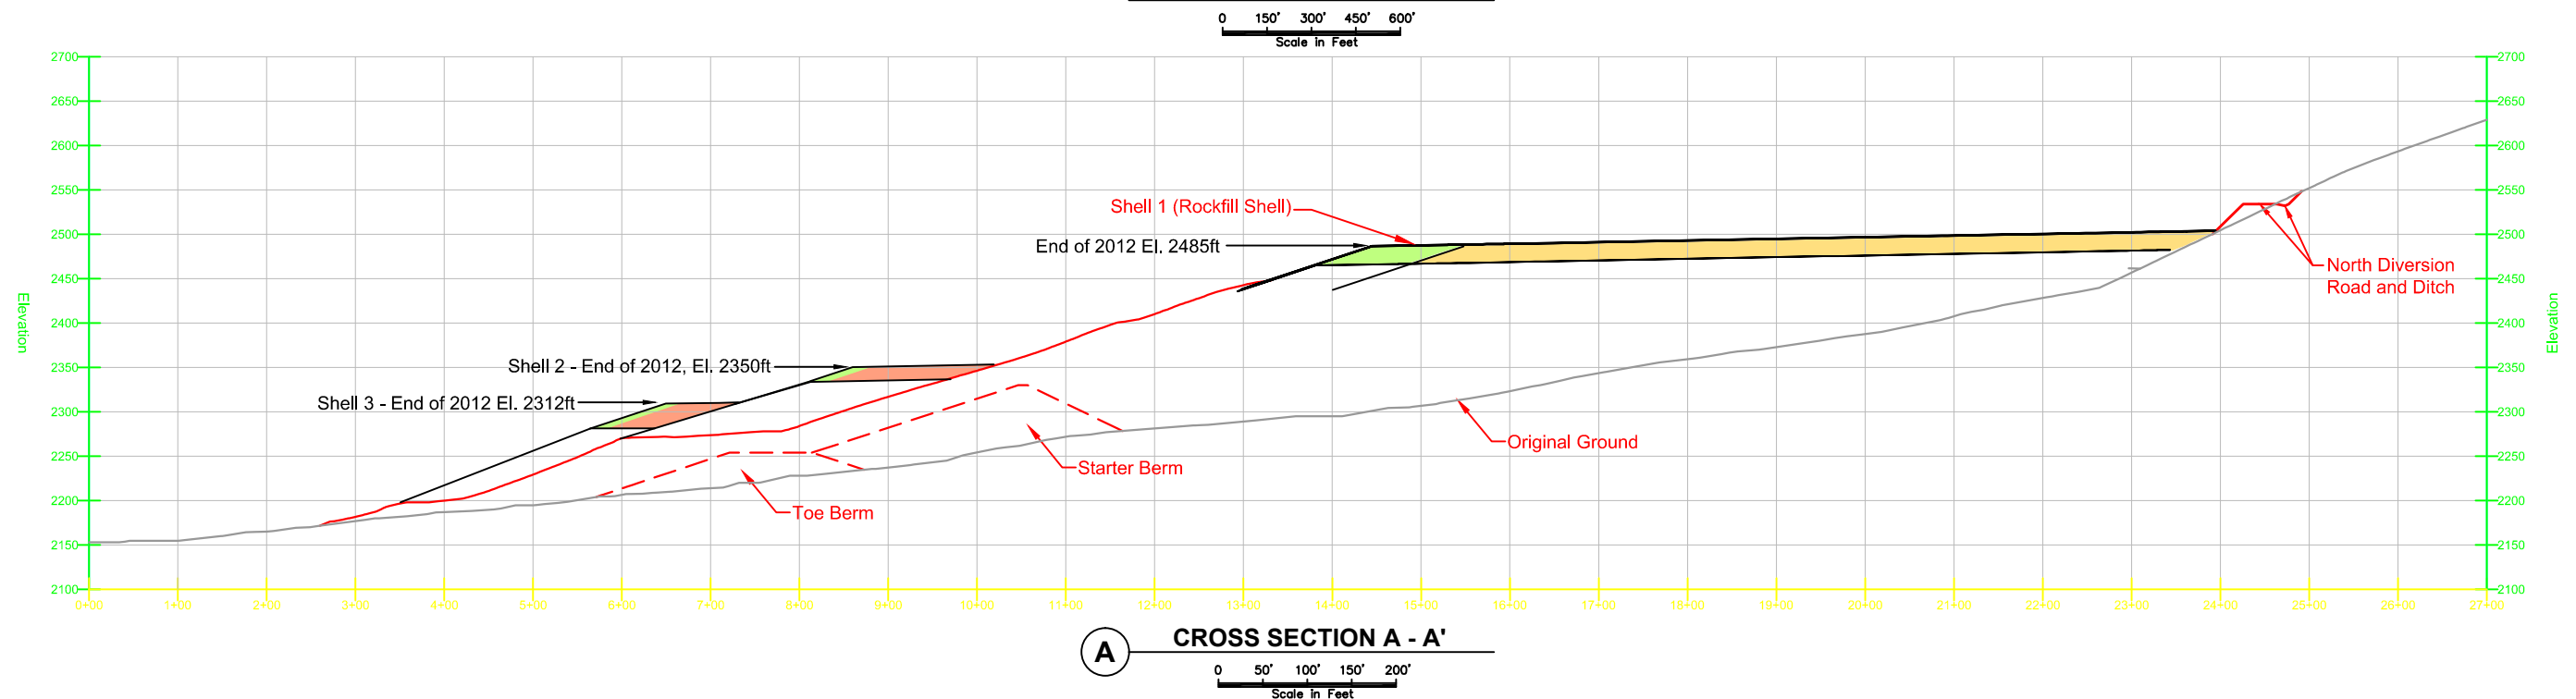


																2013 Pogo Plan of Operations																																																																																																																																																																																																																																																																																																																																																																																																																																																																																																																																																																																																																																																																																																																																																																																																																																																																																																																																																																																																																																																																																																																																																																																																																																																																																																																																																																																																																																																																																																																																																																																																																																																																																																																																																																																																																																																																																																																																																																																																																																																																																																																																																																																																																																																																																																																																																																																																																																																																																																																																																																																																																																																																																																																																																																																																																																																																																																																																																																																																																																																																																																																																																																																																																																																																																																																																																																																																																																																																																																																																																																																																																																																																																																																																																																																																																																																																																																																																																																																																																																																																																																																																																																																																																																																																																																																																																																																																																																																																																																																																																																																																																																																																																																																																																																																																																																																																																																																																																																																																																																																																																																																																																																																																																																																																																																																																																																																																																																																																																																																																																																																																																																																																																																																																																																																																																																																																																																																																																											
										DESIGN: LB			DRAWN: NV			REVIEWED: LB			Sumitomo Metal Mining Pogo LLC			DRAWING TITLE: Figure 7.1a Drystack Tailings Facility Plan and Section Oct. 2012																																																																																																																																																																																																																																																																																																																																																																																																																																																																																																																																																																																																																																																																																																																																																																																																																																																																																																																																																																																																																																																																																																																																																																																																																																																																																																																																																																																																																																																																																																																																																																																																																																																																																																																																																																																																																																																																																																																																																																																																																																																																																																																																																																																																																																																																																																																																																																																																																																																																																																																																																																																																																																																																																																																																																																																																																																																																																																																																																																																																																																																																																																																																																																																																																																																																																																																																																																																																																																																																																																																																																																																																																																																																																																																																																																																																																																																																																																																																																																																																																																																																																																																																																																																																																																																																																																																																																																																																																																																																																																																																																																																																																																																																																																																																																																																																																																																																																																																																																																																																																																																																																																																																																																																																																																																																																																																																																																																																																																																																																																																																																																																																																																																																																																																																																																																																																																																																																																																																																					
										CHECKED: -			APPROVED: -			DATE: Feb. 2011																																																																																																																																																																																																																																																																																																																																																																																																																																																																																																																																																																																																																																																																																																																																																																																																																																																																																																																																																																																																																																																																																																																																																																																																																																																																																																																																																																																																																																																																																																																																																																																																																																																																																																																																																																																																																																																																																																																																																																																																																																																																																																																																																																																																																																																																																																																																																																																																																																																																																																																																																																																																																																																																																																																																																																																																																																																																																																																																																																																																																																																																																																																																																																																																																																																																																																																																																																																																																																																																																																																																																																																																																																																																																																																																																																																																																																																																																																																																																																																																																																																																																																																																																																																																																																																																																																																																																																																																																																																																																																																																																																																																																																																																																																																																																																																																																																																																																																																																																																																																																																																																																																																																																																																																																																																																																																																																																																																																																																																																																																																																																																																																																																																																																																																																																																																																																																																																																																																																																											
DRAWING NO.										DRAWING TITLE										DRAWING NO.										DRAWING TITLE										NO.										DESCRIPTION										CHK'D										APP'D										DATE										PROFESSIONAL ENGINEERS STAMP										FILE NAME:										SRK JOB NO.: 1CS021.000										DRAWING NO. 1										SHEET 1 of 7										REVISION NO. A																																																																																																																																																																																																																																																																																																																																																																																																																																																																																																																																																																																																																																																																																																																																																																																																																																																																																																																																																																																																																																																																																																																																																																																																																																																																																																																																																																																																																																																																																																																																																																																																																																																																																																																																																																																																																																																																																																																																																																																																																																																																																																																																																																																																																																																																																																																																																																																																																																																																																																																																																																																																																																																																																																																																																																																																																																																																																																																																																																																																																																																																																																																																																																																																																																																																																																																																																																																																																																																																																																																																																																																																																																																																																																																																																																																																																																																																																																																																																																																																																																																																																																																																																																																																																																																																																																																																																																																																																																																																																																																																																																																																																																																																																																																																																																																																																																																																																																																																																																																																																																																																																																																																																																																																																																																																																																																																																																																																																																																																																																																																																																																																																																																																																																																																																																																																																															


- Diversion Ditch
- Extent of Year 2013 Material Placement
- Rock Drain Extension
- Green Rock Outer Shell
- Dry Stack Material
- Tailings

1. Contour interval is 5ft.
2. Base contour data received from POGO mine site.

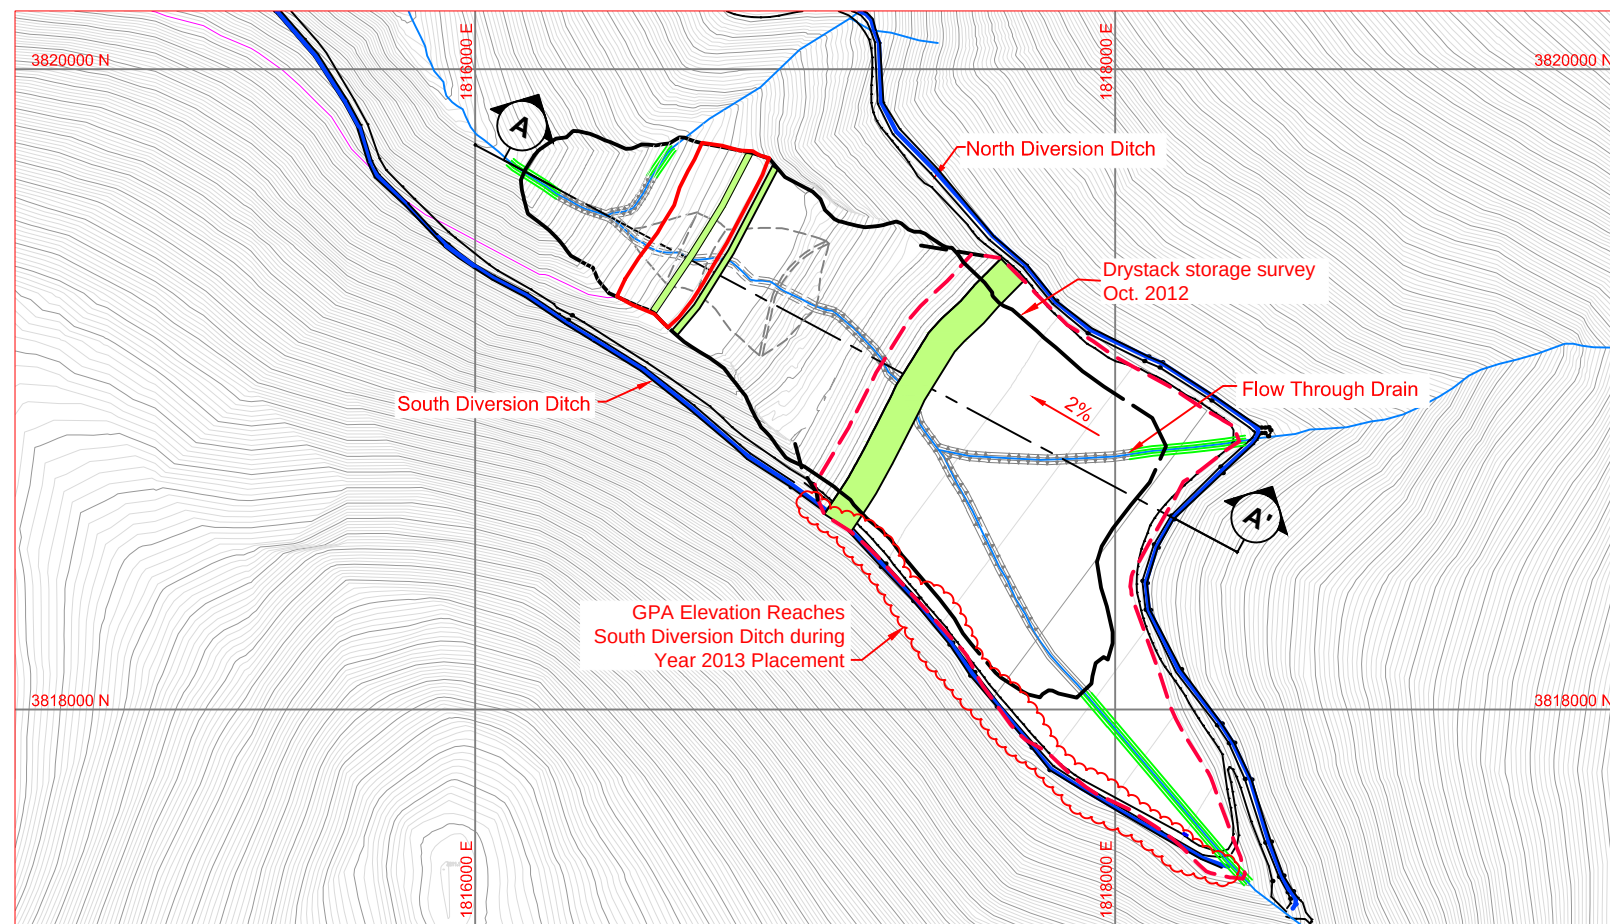

PLAN VIEW
DRY STACK STORAGE AREA

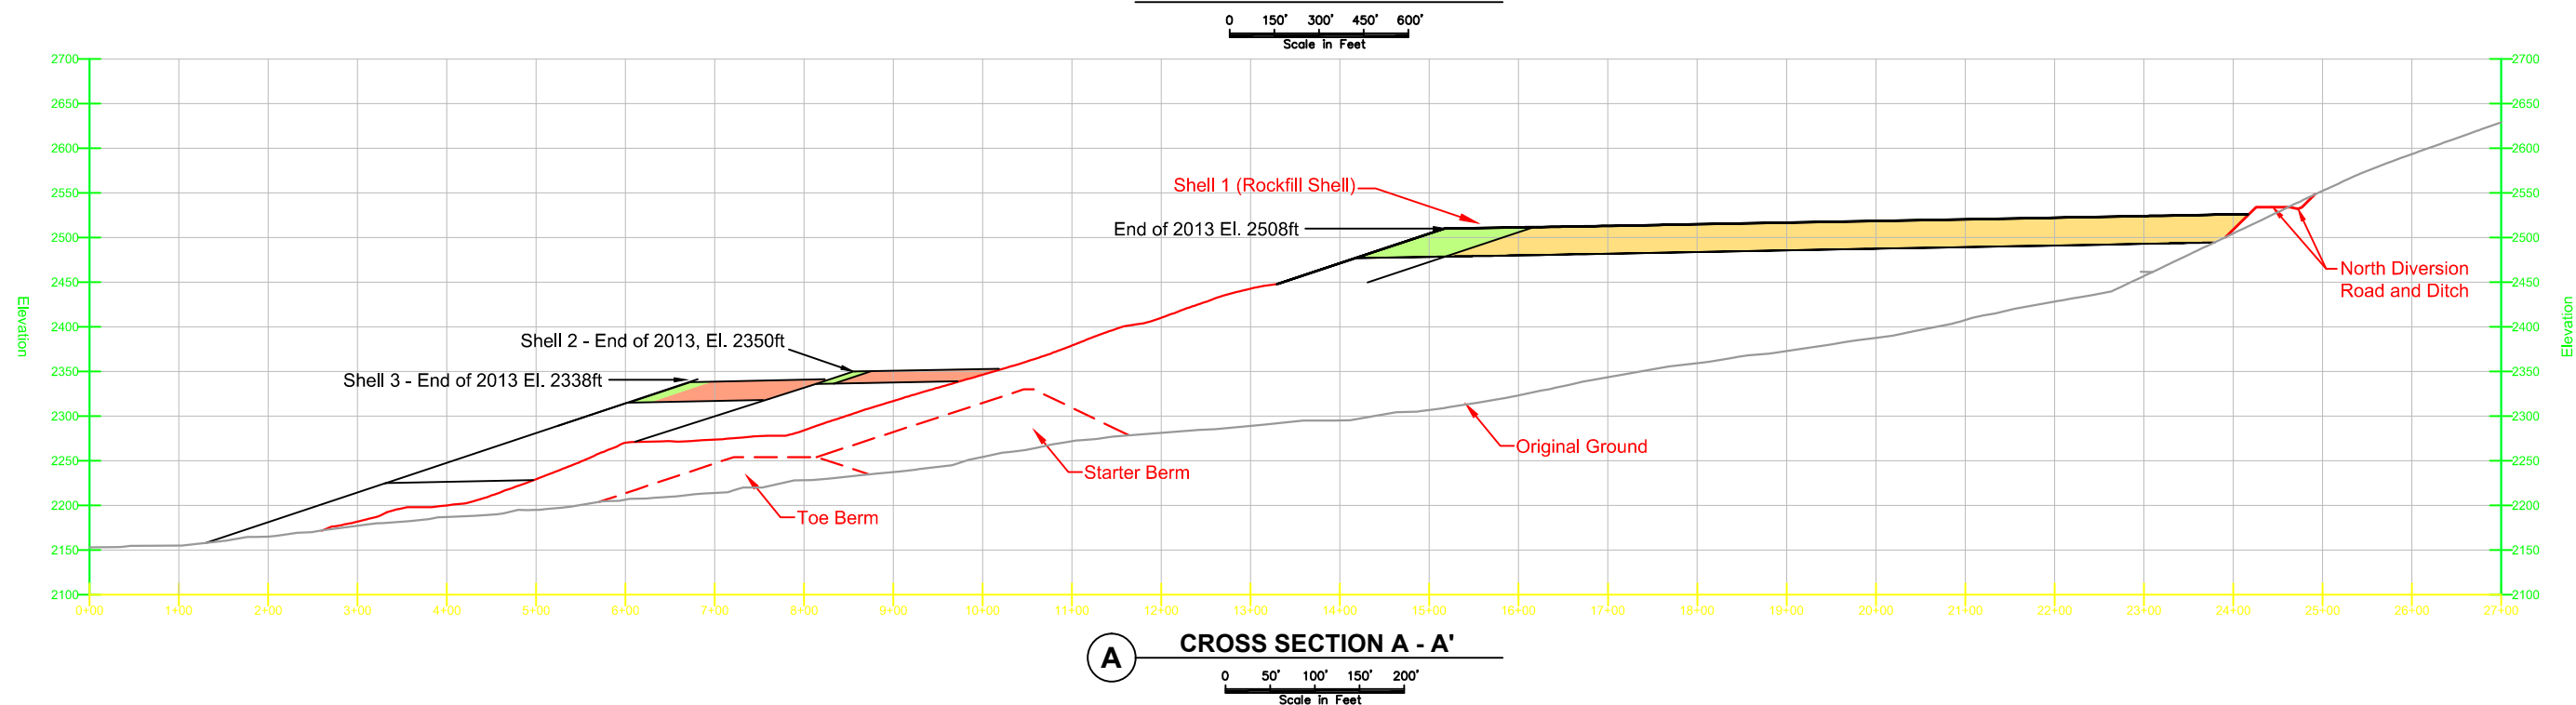


 										 SRK Consulting Engineers and Scientists Vancouver			 POGO MINE SUMITOMO METAL MINING POGO LLC MINING DONE RIGHT			2013 Pogo Plan of Operations																																																																																																																																																																																																																																																																																																																																																																																																																																																																																																																																																																																																																																																																																																																																																																																																																																																																																																																																																																																																																																																																																																																																																																																																																																																																																																																																																																																																																																																																																																																																																																																																																																																																																																																																																																																																																																																																																																																																																																																																																																																																																																																																																																																																																																																																																																																																																																																																																																																																																																																																																																																																																																																																																																																																																																																																																																																																																																																																																																																																																																																																																																																																																																																																																																																																																																																																																																																																																																																																																																																																																																																																																																																																																																																																																																																																																																																																																																																																																																																																																																																																																																																																																																																																																																																																																																																																																																																																																																																																																																																																																																																																																																																																																																																																																																																																																																																																																																																																																																																																																																																																																																																																																																																																																																																																																																																																																																																															
										DESIGN: LB			DRAWN: NV			REVIEWED: LB			Sumitomo Metal Mining Pogo LLC			DRAWING TITLE: Figure 7.1b Drystack Tailings Facility Plan and Section End of 2013																																																																																																																																																																																																																																																																																																																																																																																																																																																																																																																																																																																																																																																																																																																																																																																																																																																																																																																																																																																																																																																																																																																																																																																																																																																																																																																																																																																																																																																																																																																																																																																																																																																																																																																																																																																																																																																																																																																																																																																																																																																																																																																																																																																																																																																																																																																																																																																																																																																																																																																																																																																																																																																																																																																																																																																																																																																																																																																																																																																																																																																																																																																																																																																																																																																																																																																																																																																																																																																																																																																																																																																																																																																																																																																																																																																																																																																																																																																																																																																																																																																																																																																																																																																																																																																																																																																																																																																																																																																																																																																																																																																																																																																																																																																																																																																																																																																																																																																																																																																																																																																																																																																																																																																																																																																																																																																																																																																									
										CHECKED: -			APPROVED: -			DATE: Feb. 2011																																																																																																																																																																																																																																																																																																																																																																																																																																																																																																																																																																																																																																																																																																																																																																																																																																																																																																																																																																																																																																																																																																																																																																																																																																																																																																																																																																																																																																																																																																																																																																																																																																																																																																																																																																																																																																																																																																																																																																																																																																																																																																																																																																																																																																																																																																																																																																																																																																																																																																																																																																																																																																																																																																																																																																																																																																																																																																																																																																																																																																																																																																																																																																																																																																																																																																																																																																																																																																																																																																																																																																																																																																																																																																																																																																																																																																																																																																																																																																																																																																																																																																																																																																																																																																																																																																																																																																																																																																																																																																																																																																																																																																																																																																																																																																																																																																																																																																																																																																																																																																																																																																																																																																																																																																																																																																																																																																																															
DRAWING NO.										DRAWING TITLE										DRAWING NO.										DRAWING TITLE										NO.										DESCRIPTION										CHK'D										APP'D										DATE										PROFESSIONAL ENGINEERS STAMP										FILE NAME:										SRK JOB NO.: 1CS021.000										DRAWING NO. 2										SHEET 2 of 7										REVISION NO. A																																																																																																																																																																																																																																																																																																																																																																																																																																																																																																																																																																																																																																																																																																																																																																																																																																																																																																																																																																																																																																																																																																																																																																																																																																																																																																																																																																																																																																																																																																																																																																																																																																																																																																																																																																																																																																																																																																																																																																																																																																																																																																																																																																																																																																																																																																																																																																																																																																																																																																																																																																																																																																																																																																																																																																																																																																																																																																																																																																																																																																																																																																																																																																																																																																																																																																																																																																																																																																																																																																																																																																																																																																																																																																																																																																																																																																																																																																																																																																																																																																																																																																																																																																																																																																																																																																																																																																																																																																																																																																																																																																																																																																																																																																																																																																																																																																																																																																																																																																																																																																																																																																																																																																																																																																																																			


G:\Environmental\Plan of Ops and Reclamation Plan Working Copy\2013 Plan of Operation Rev 6 ED Mining\Figures for 2013 POO Rev 6 ED Mining\Figure 7.1b DSTF Year-by-Year Planning

- Diversion Ditch
- Extent of Year 2014 Material Placement
- Rock Drain Extension Required for Year 2014
- Green Rock Outer Shell
- Dry Stack Material
- Tailings

1. Contour interval is 5ft.
2. Base contour data received from POGO mine site.

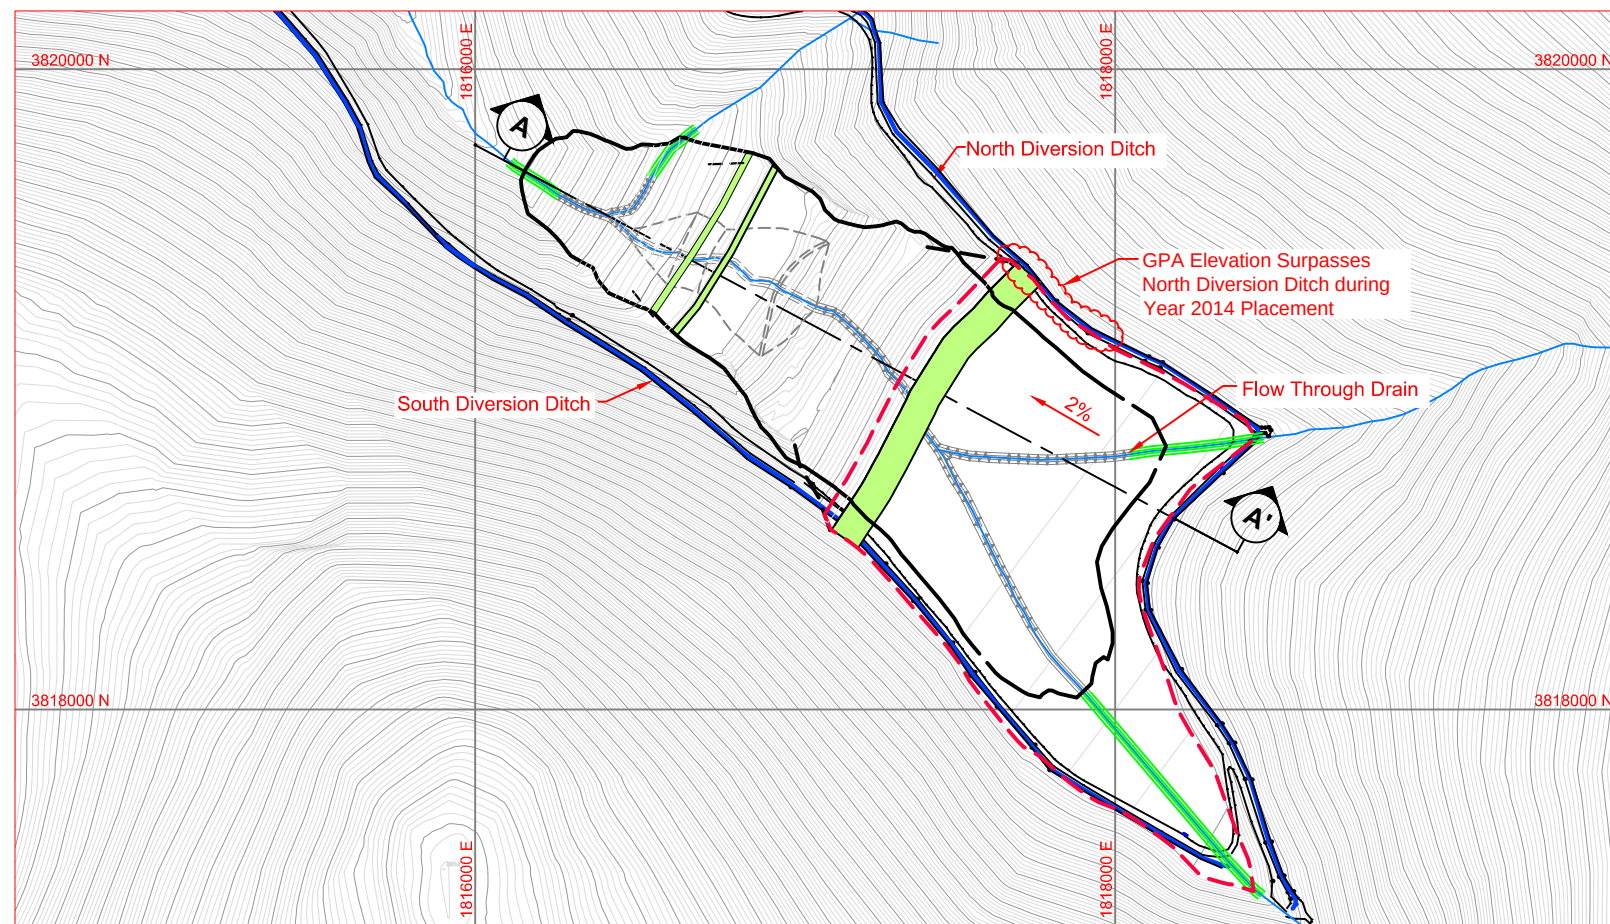

PLAN VIEW
DRY STACK STORAGE AREA

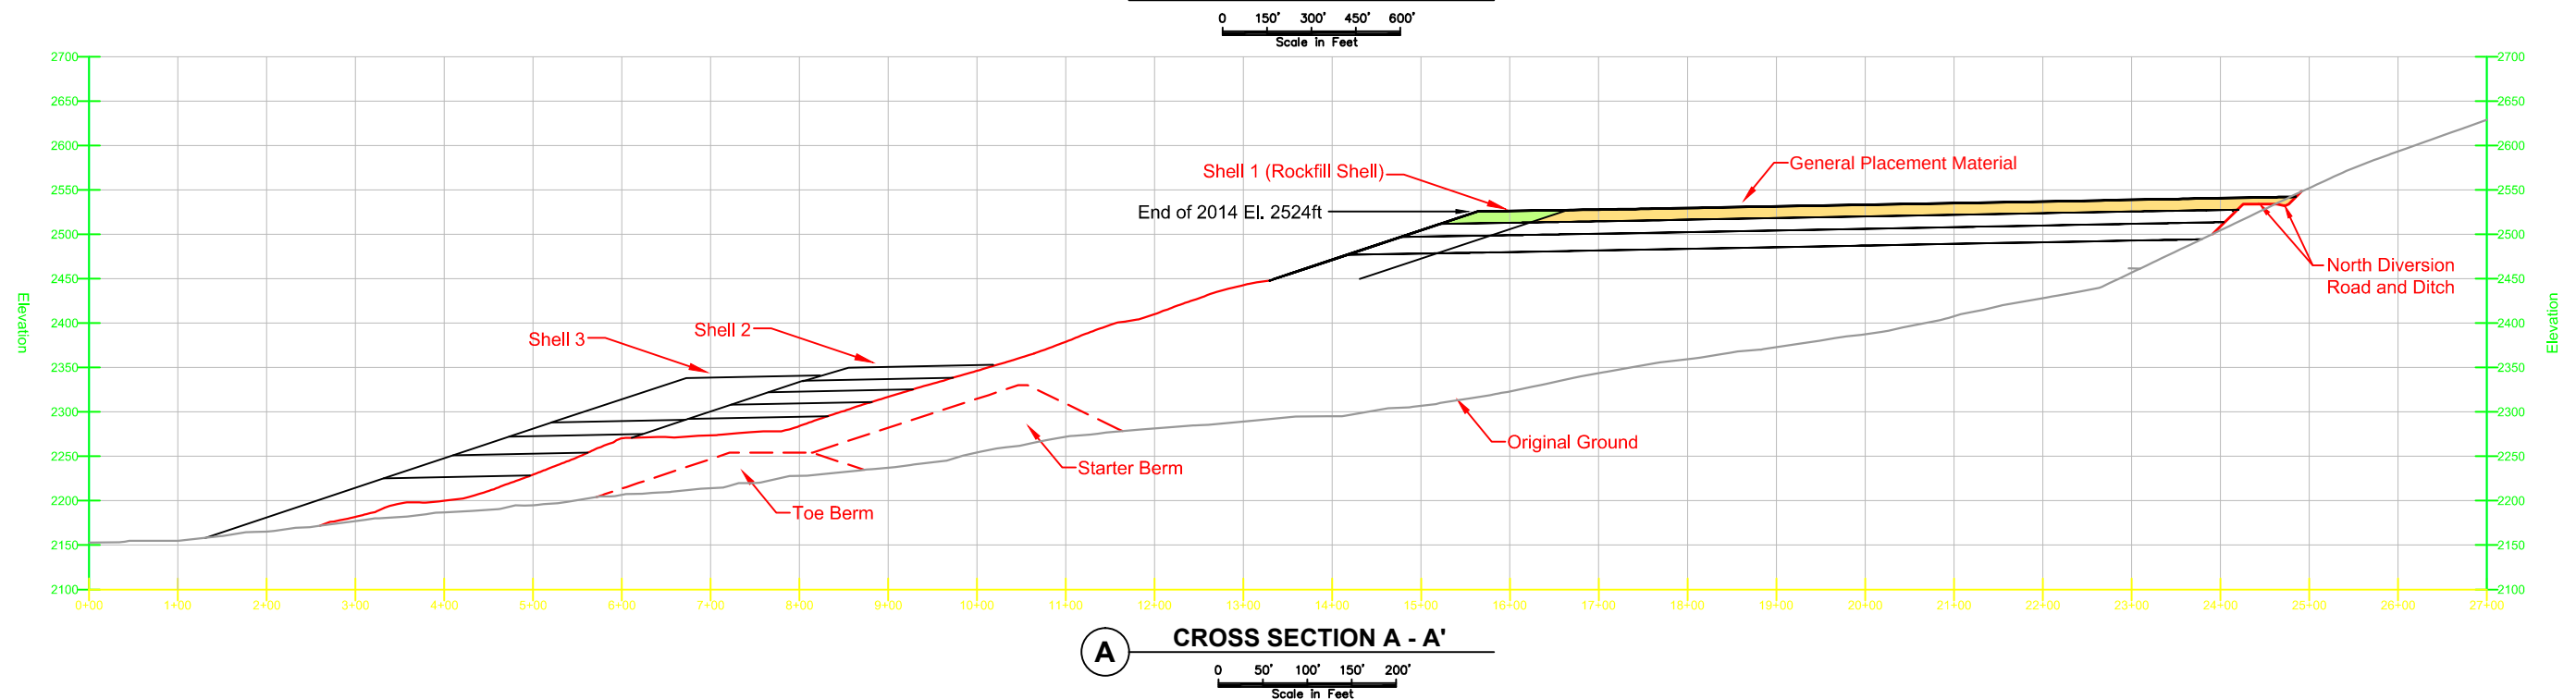


										 SRK Consulting Engineers and Scientists Vancouver			 POGO MINE SUMITOMO METAL MINING POGO LLC MINING DONE RIGHT			2013 Pogo Plan of Operations								
										DESIGN: LB			DRAWN: NV			REVIEWED: LB			Sumitomo Metal Mining Pogo LLC			DRAWING TITLE: Figure 7.1c Drystack Tailings Facility Plan and Section End of 2014		
										CHECKED: -			APPROVED: -			DATE: Feb. 2011								
DRAWING NO.	DRAWING TITLE			DRAWING NO.	DRAWING TITLE			NO.	DESCRIPTION	CHK'D	APP'D	DATE	PROFESSIONAL ENGINEERS STAMP			FILE NAME:			SRK JOB NO.: 1CS021.000			DRAWING NO. 3	SHEET 3 of 7	REVISION NO. A
REFERENCE DRAWINGS										REVISIONS														

LEGEND



- Diversion Ditch
- Extent of Year 2015 Material Placement
- Rock Drain Extension Required for Year 2015
- Green Rock Outer Shell
- Dry Stack Material
- Tailings

NOTES


- 1. Contour interval is 5ft.
- 2. Base contour data received from POGO mine site.

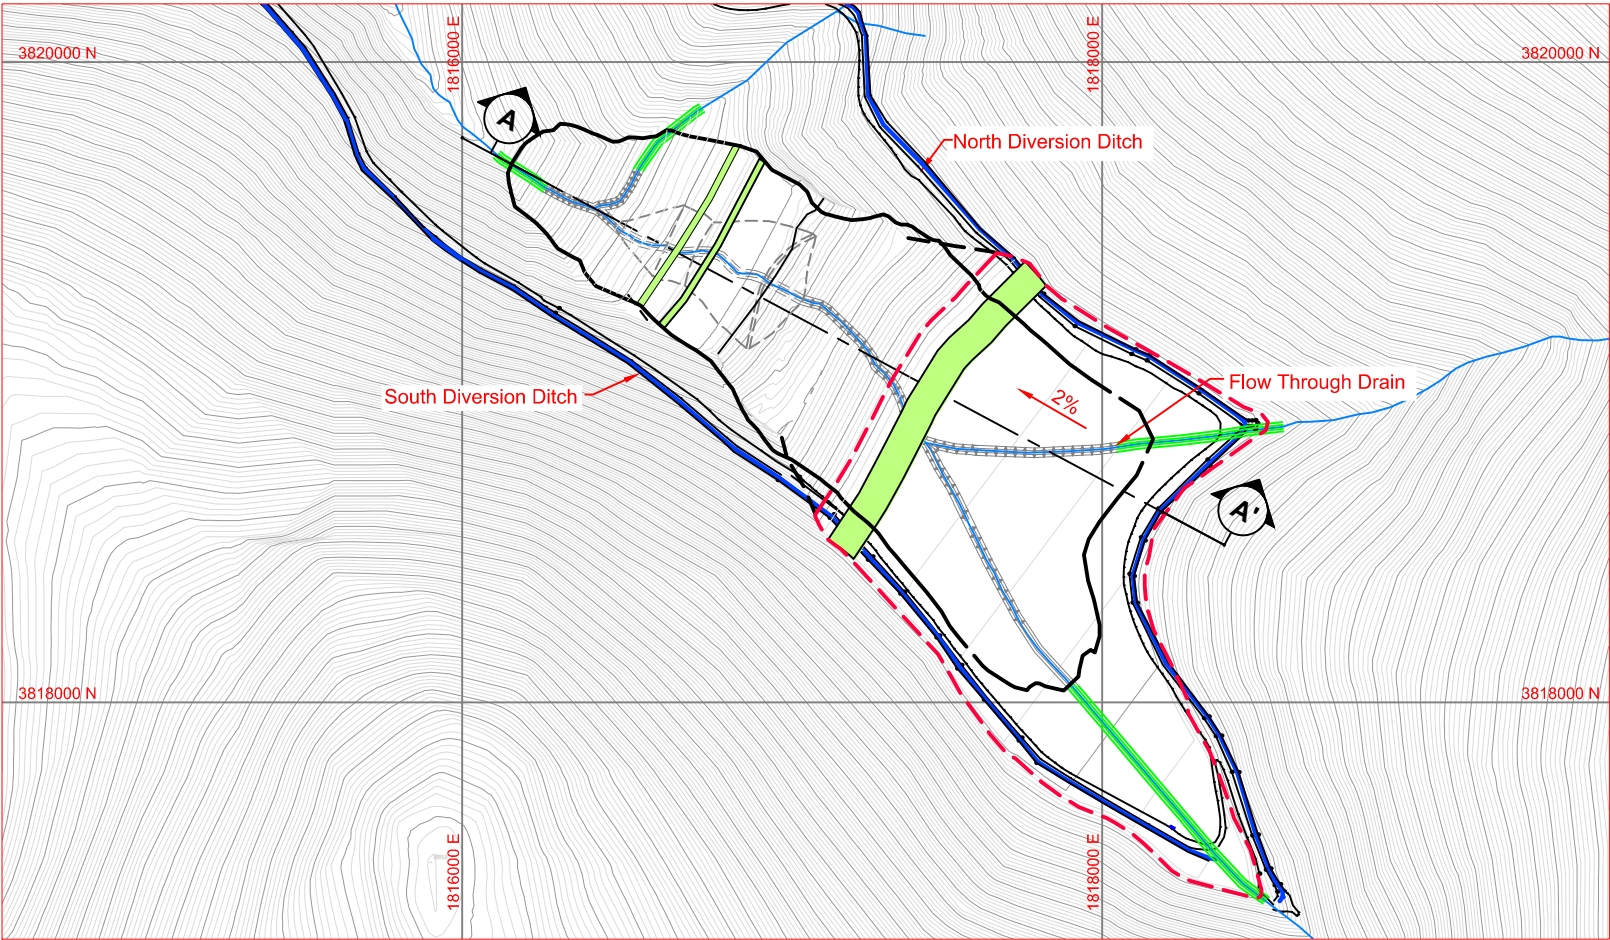

PLAN VIEW
DRY STACK STORAGE AREA

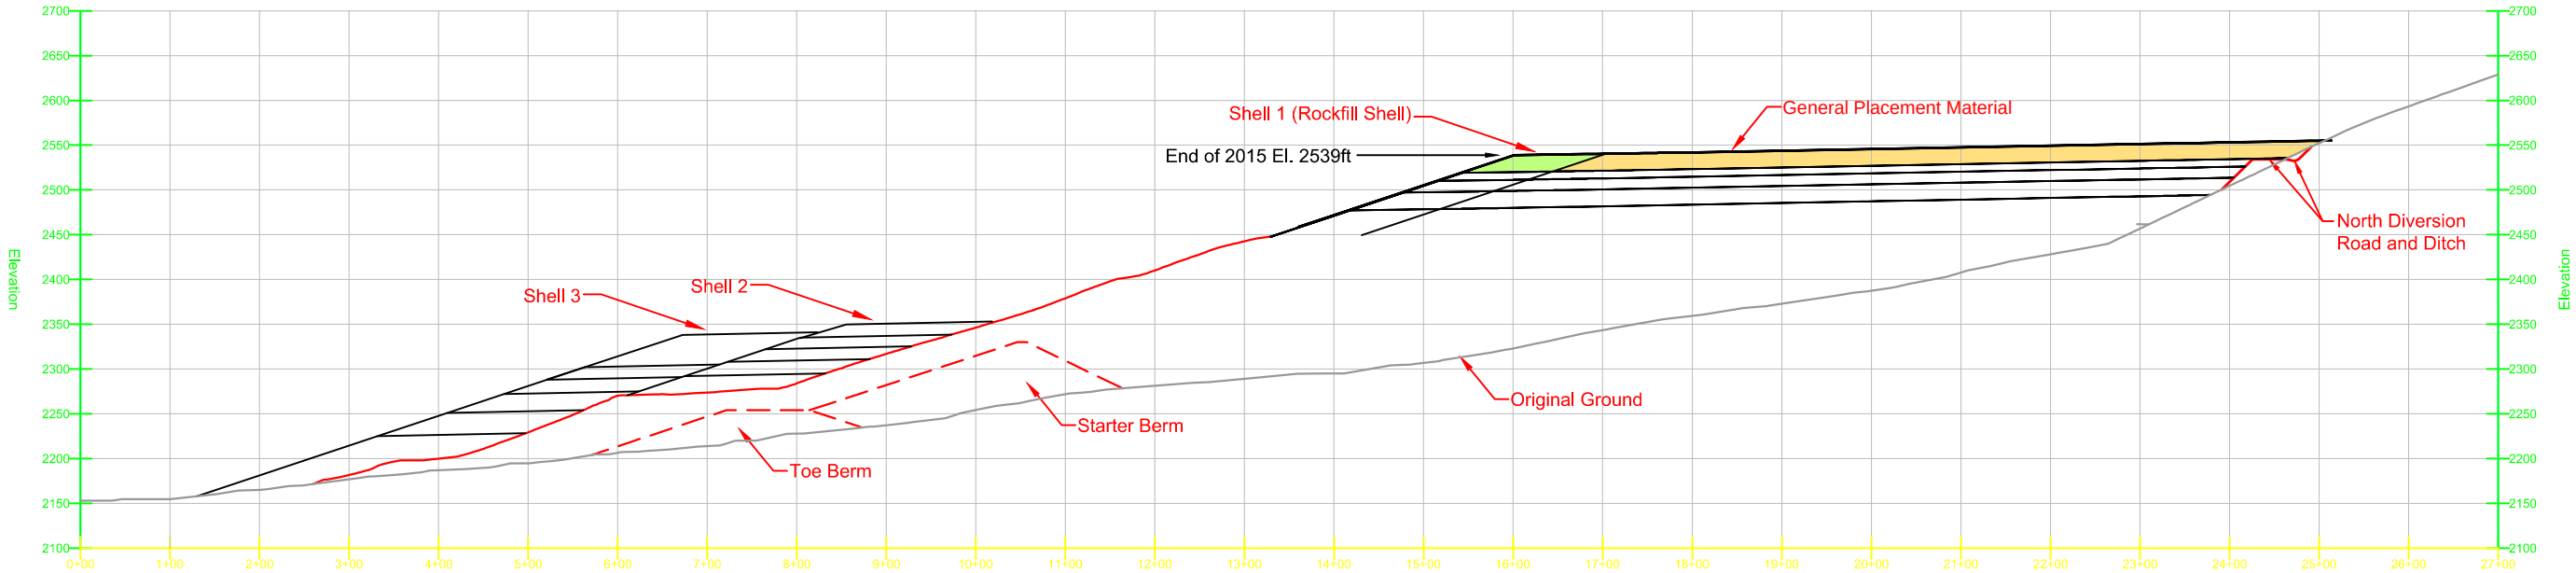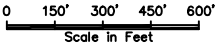

CROSS SECTION A - A'

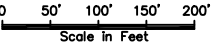

C:\Environment\Plan of Ops and Reclamation Plan Working Copy\2013 Plan of Operation Rev 6 E.D Mining\Figures for 2013 POGO Rev 6 E.D Mining\AutoCAD Files\201306 POGO Rev 6 Figure 7.1d DSST EGY 2015.dwg


											2013 Pogo Plan of Operations		
											DRAWING TITLE:		
											Figure 7.1d		
											Drystack Tailings Facility		
											Plan and Section End of 2015		
											DRAWING NO.		
											4		
											SHEET		
											4 of 7		
											REVISION NO.		
											A		

DRAWING NO.	DRAWING TITLE	DRAWING NO.	DRAWING TITLE	NO.	DESCRIPTION	CHK'D	APP'D	DATE
REFERENCE DRAWINGS				REVISIONS				


PROFESSIONAL ENGINEERS STAMP		FILE NAME:		SRK Consulting Engineers and Scientists		POGO MINE MINING DONE RIGHT		Sumitomo Metal Mining Pogo LLC		SRK JOB NO.: 1CS021.000	
DESIGN: LB	DRAWN: NV	REVIEWED: LB	CHECKED: -	APPROVED: -	DATE: Feb. 2011						

- Diversion Ditch
- Extent of Year 2016 Material Placement
- Rock Drain Extension Required for Year 2016
- Green Rock Outer Shell
- Dry Stack Material
- Tailings

1. Contour interval is 5ft.
2. Base contour data received from POGO mine site.

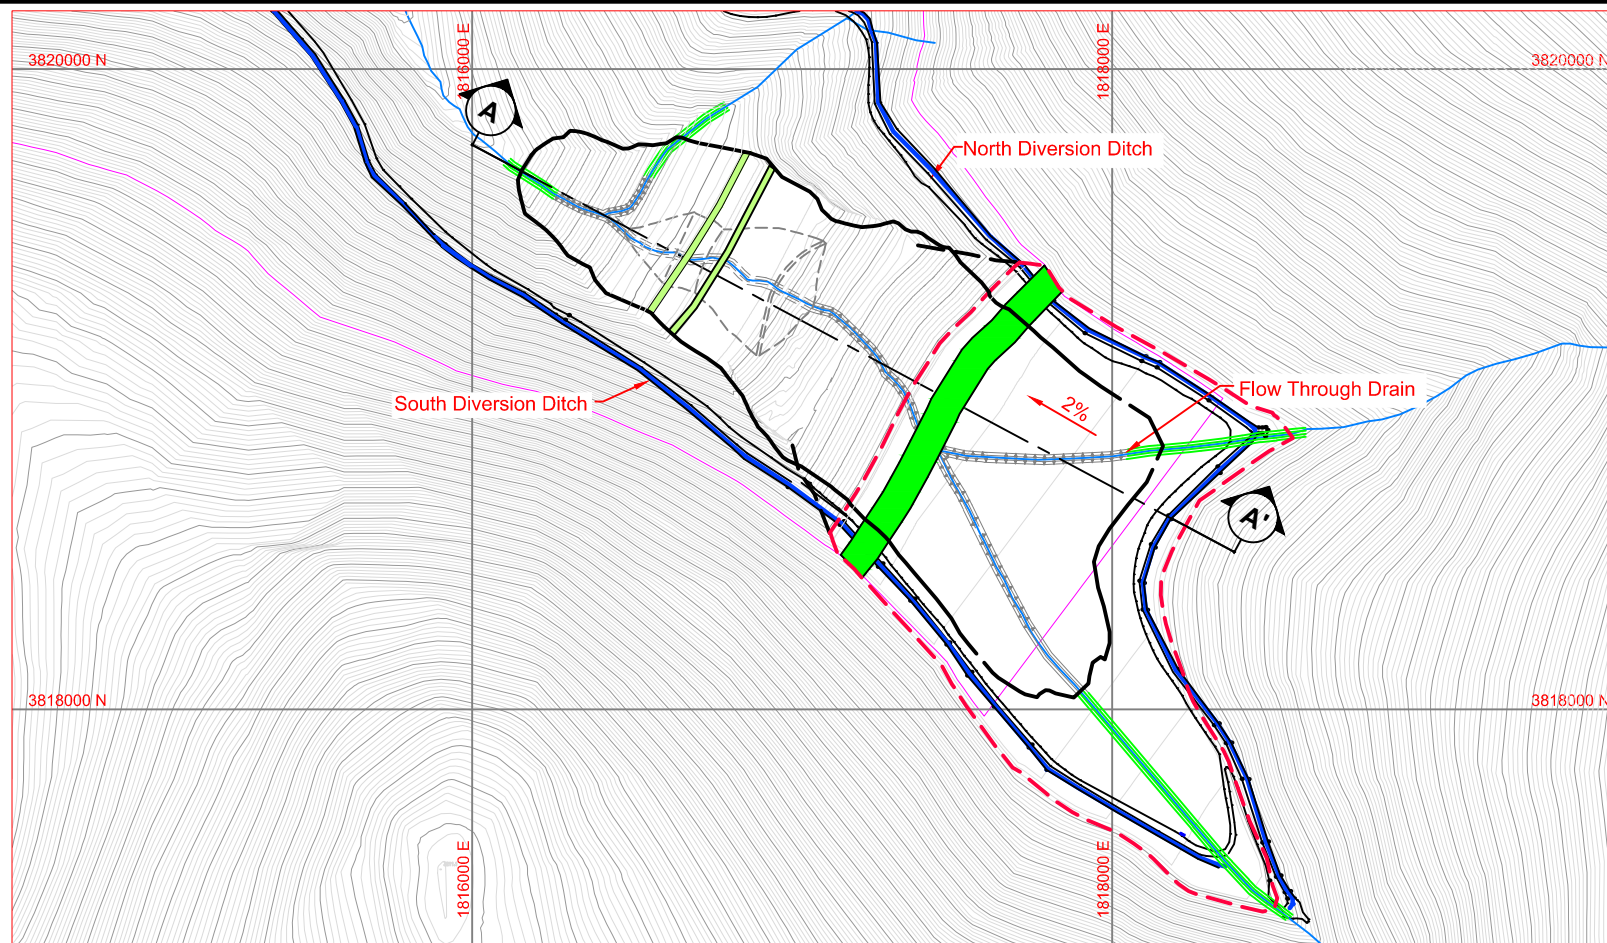


PLAN VIEW
DRY STACK STORAGE AREA

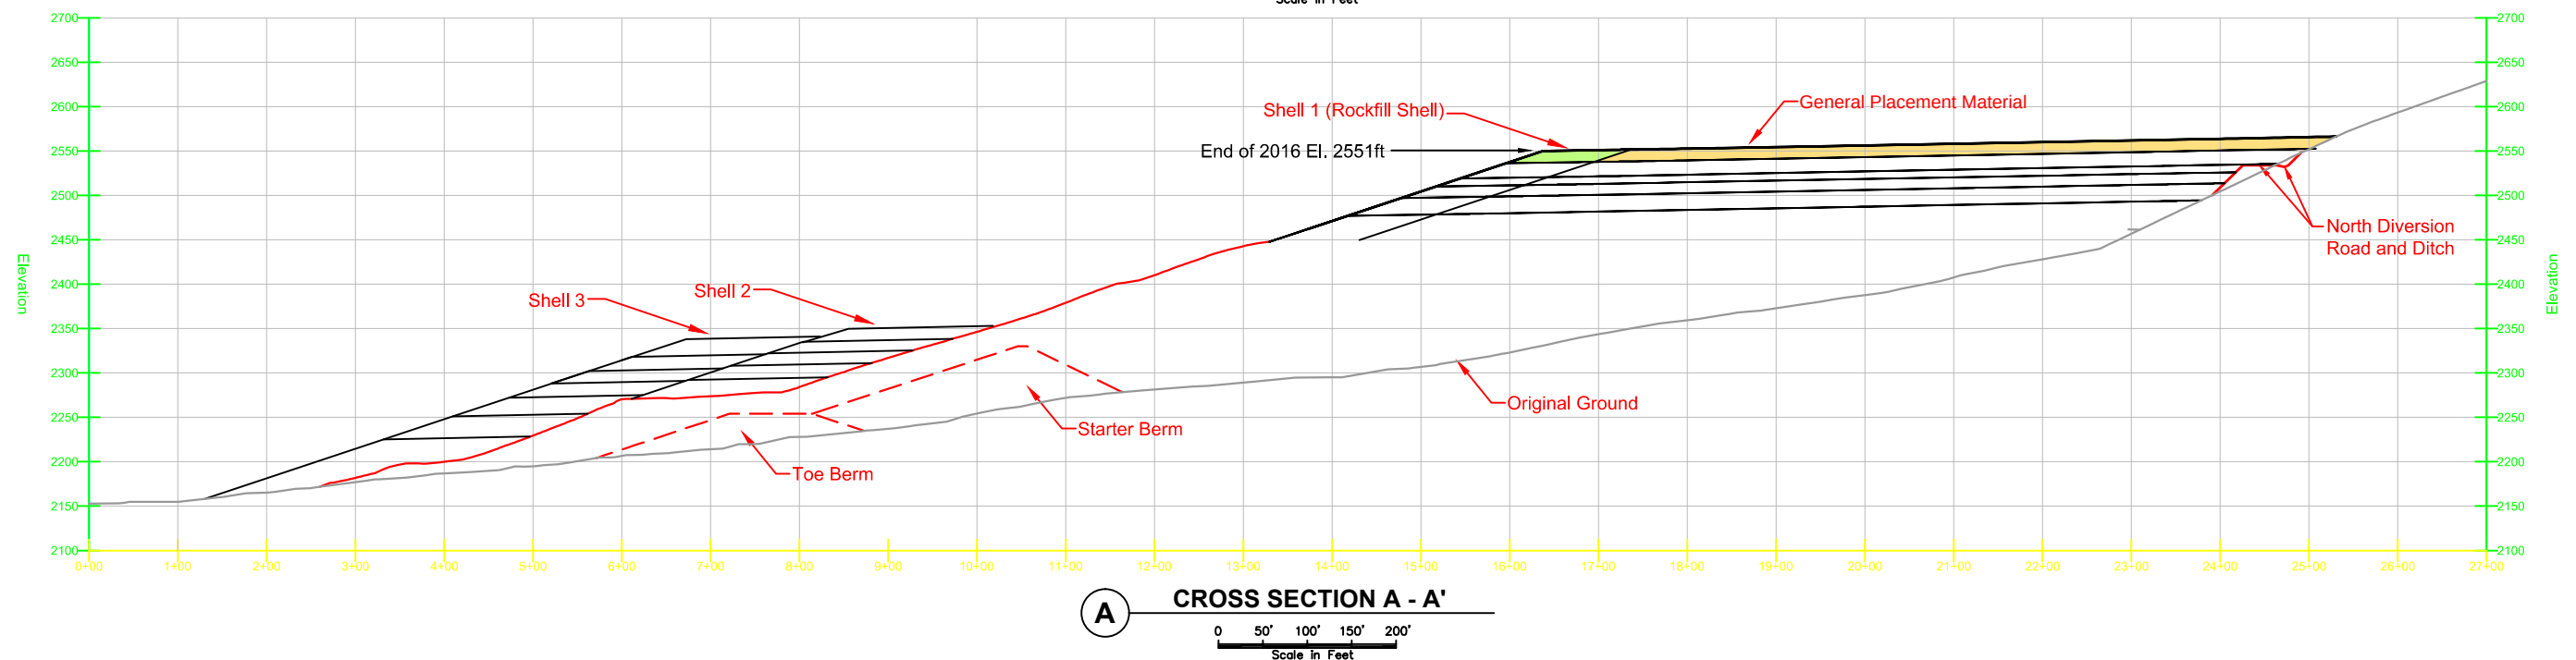


										SRK Consulting <i>Engineers and Scientists</i> Vancouver			POGO MINE SUMITOMO METAL MINING POGO LLC MINING DONE RIGHT			2013 Pogo Plan of Operations																								
										DESIGN: LB			DRAWN: NV			REVIEWED: LB			Sumitomo Metal Mining Pogo LLC			DRAWING TITLE: Figure 7.1e Drystack Tailings Facility Plan and Section End of 2016																		
										CHECKED: -			APPROVED: -			DATE: Feb. 2011																								
DRAWING NO.			DRAWING TITLE				DRAWING NO.			DRAWING TITLE				NO.	DESCRIPTION				CHK'D	APP'D	DATE	PROFESSIONAL ENGINEERS STAMP			FILE NAME:			SRK JOB NO.: 1CS021.000			DRAWING NO.	5	SHEET 5 of 7	REVISION NO. A						
REFERENCE DRAWINGS										REVISIONS																														

- Diversion Ditch
- Extent of Year 2017 Material Placement
- Rock Drain Extension Required for Year 2017
- Green Rock Outer Shell
- Dry Stack Material
- Tailings

1. Contour interval is 5ft.
2. Base contour data received from POGO mine site.

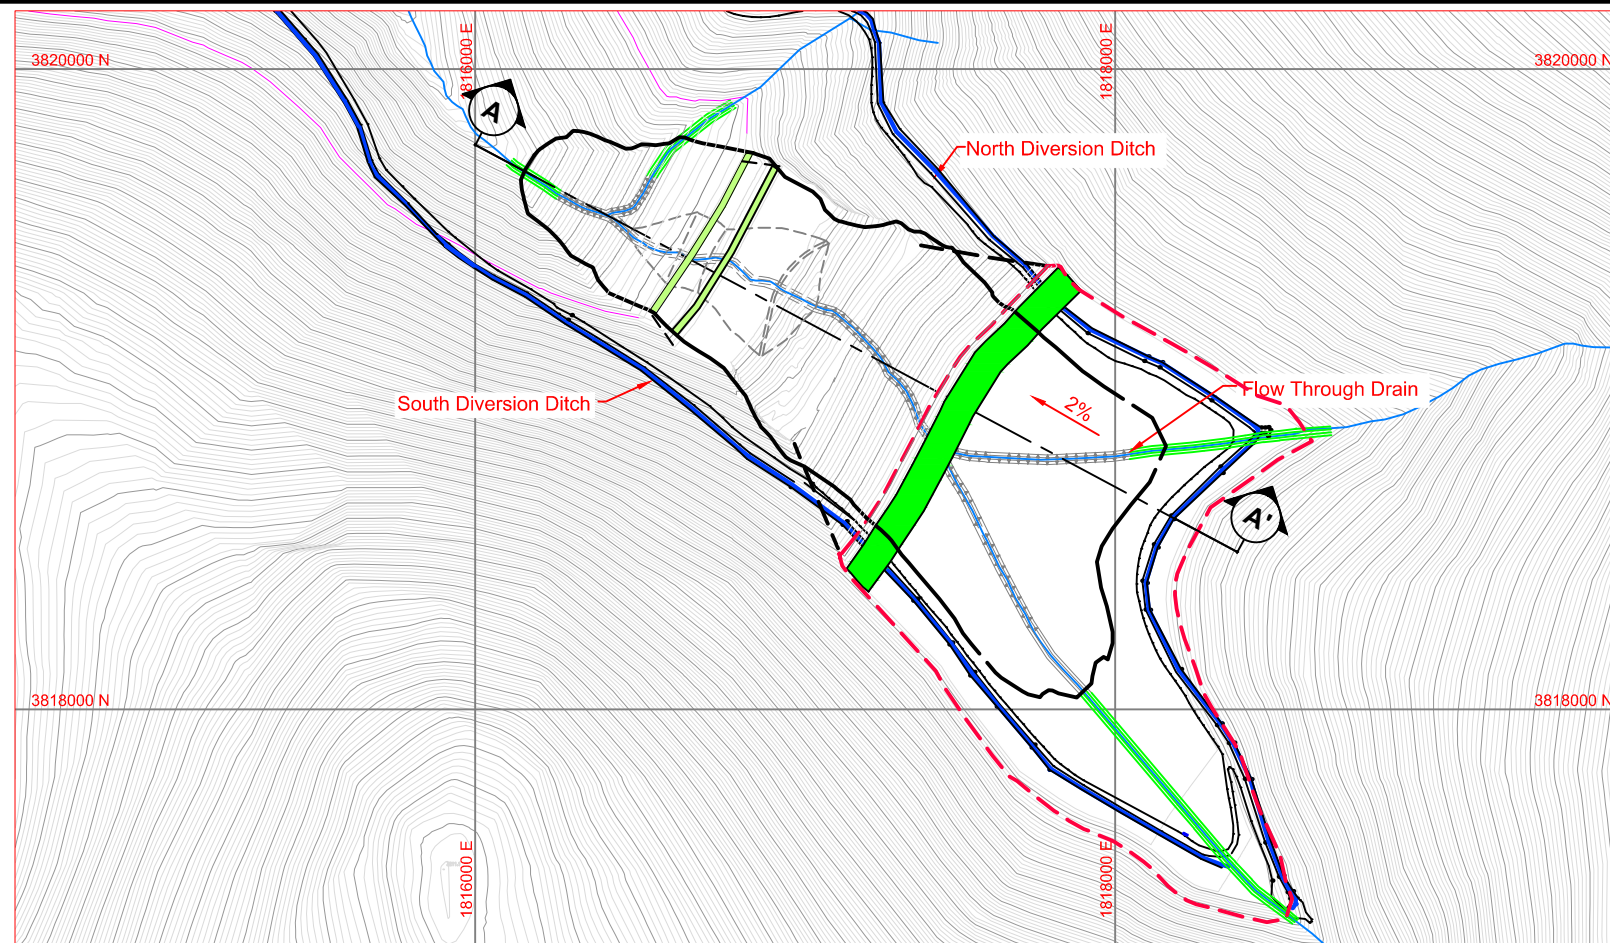


PLAN VIEW
DRY STACK STORAGE AREA

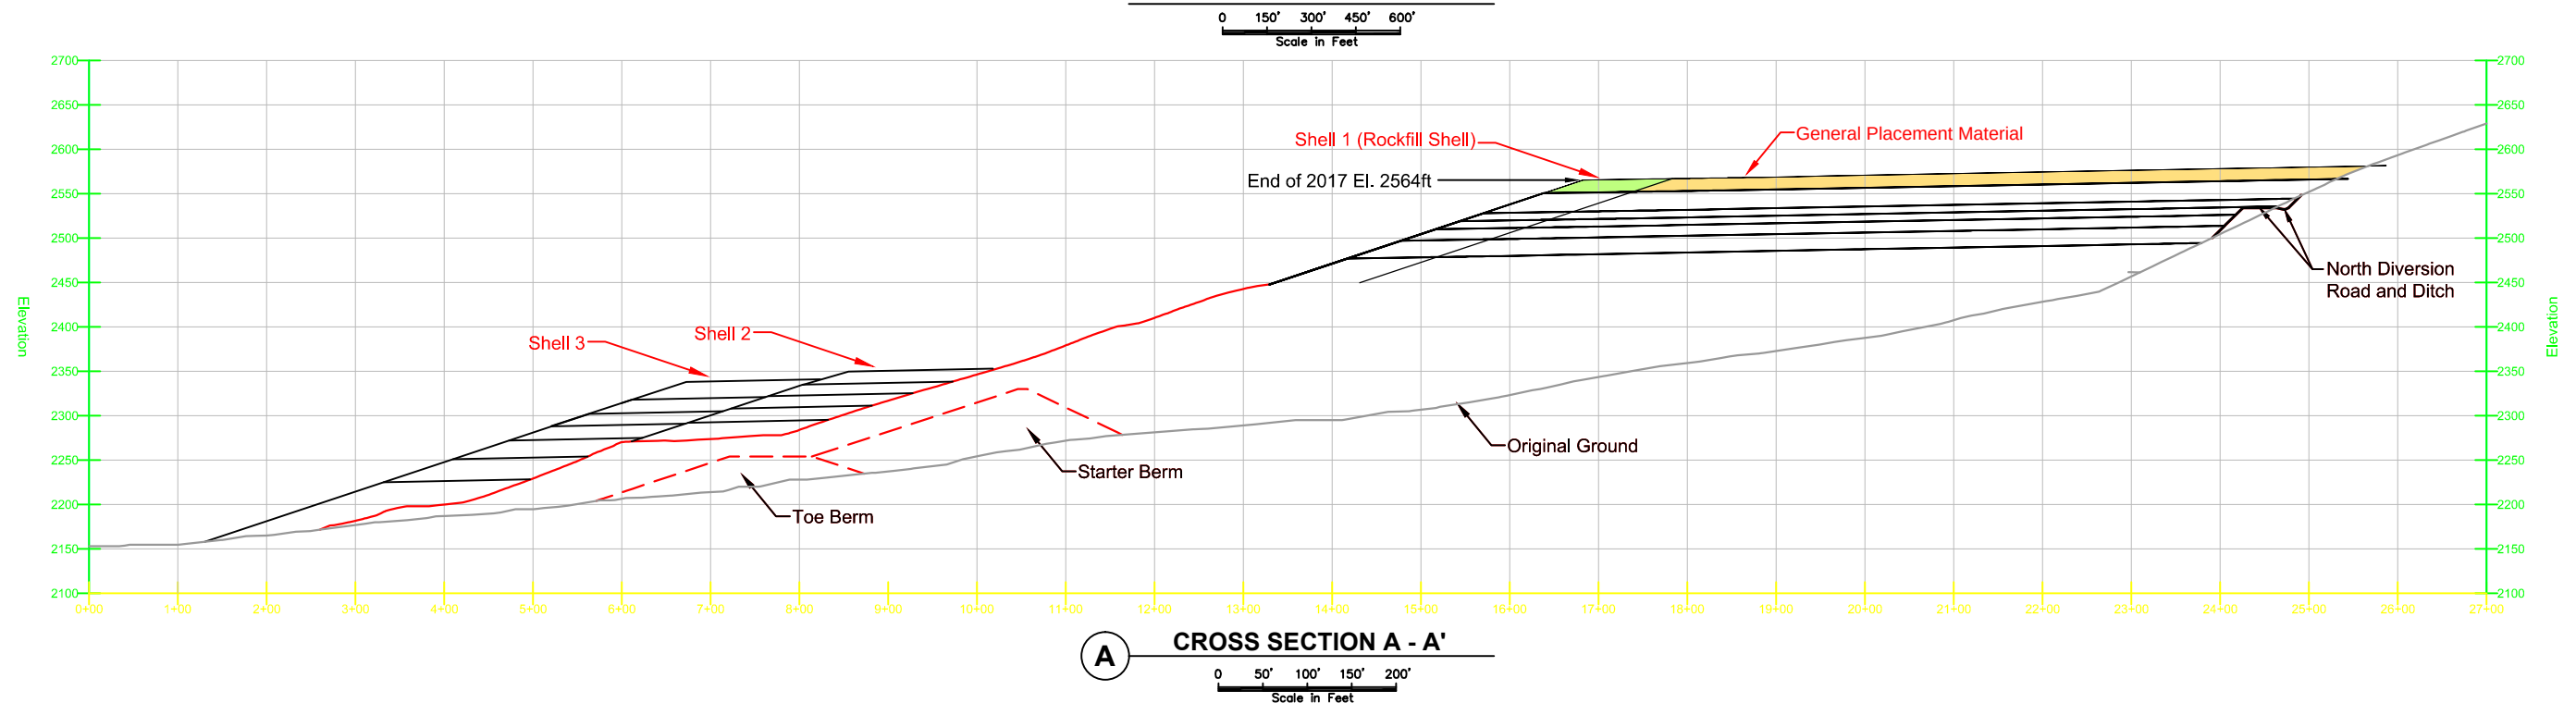
[illegible]

- Diversion Ditch
- Extent of Year 2017 Material Placement
- Rock Drain Extension Required for Year 2017
- Green Rock Outer Shell
- Dry Stack Material
- Tailings


1. Contour interval is 5ft.
2. Base contour data received from POGO mine site.

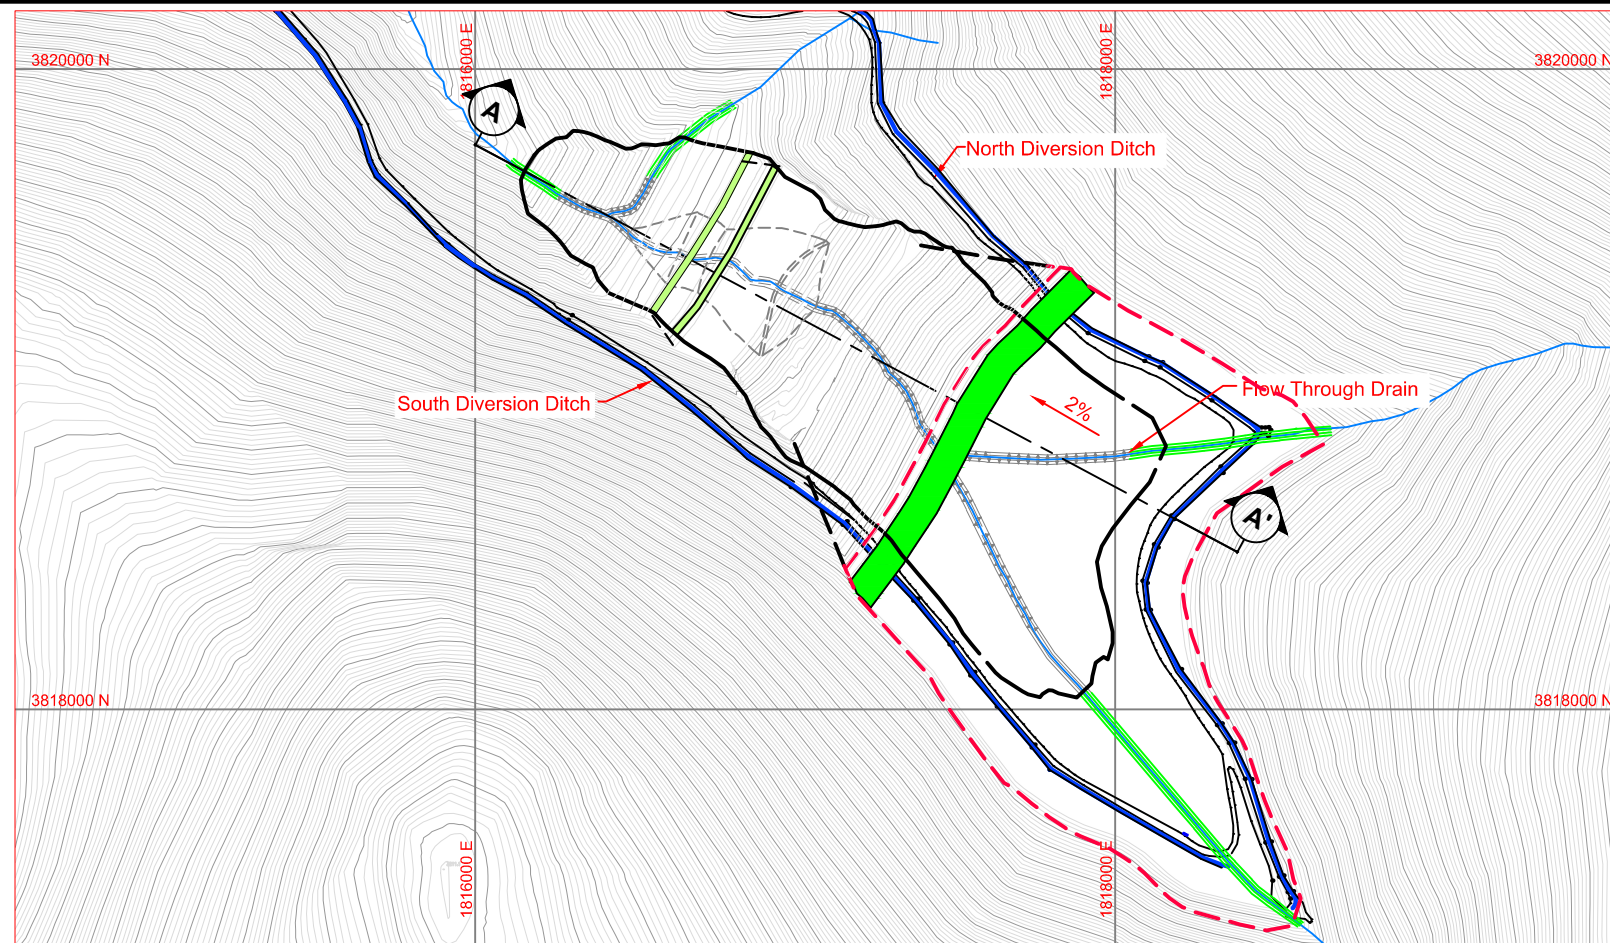

PLAN VIEW
DRY STACK STORAGE AREA

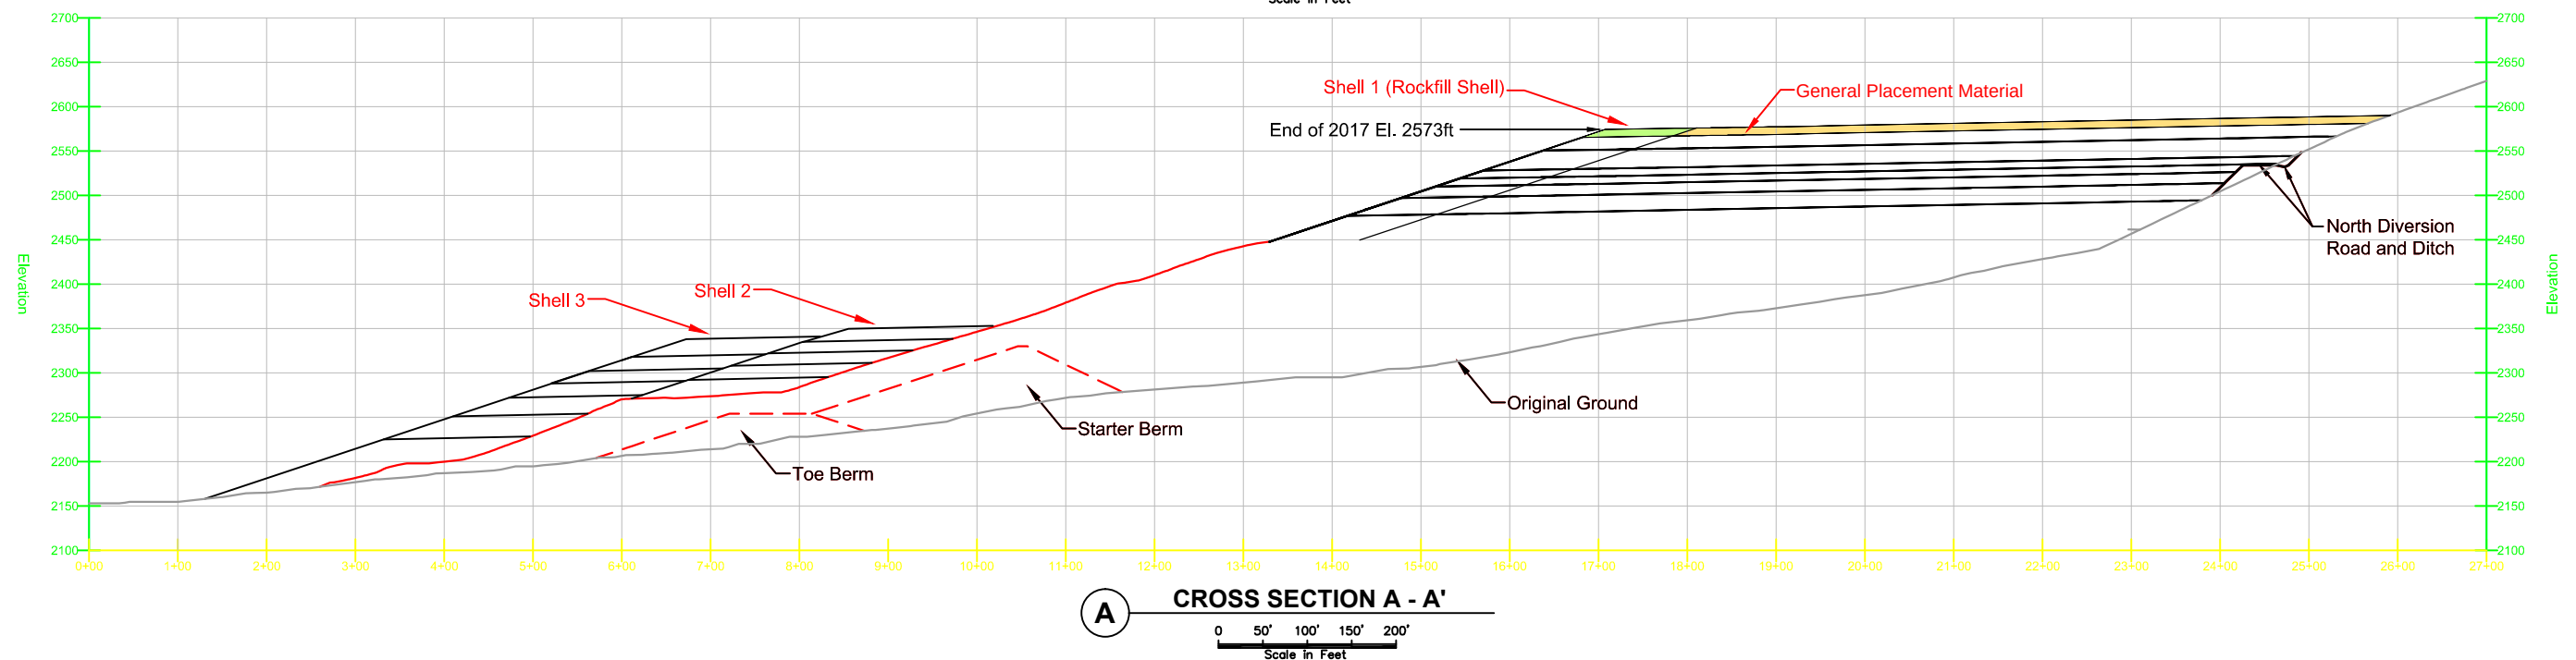


																2013 Pogo Plan of Operations																																																																																																																																																																																																																																																																																																																																																																																																																																																																																																																																																																																																																																																																																																																																																																																																																																																																																																																																																																																																																																																																																																																																																																																																																																																																																																																																																																																																																																																																																																																																																																																																																																																																																																																																																																																																																																																																																																																																																																																																																																																																																																																																																																																																																																																																																																																																																																																																																																																																																																																																																																																																																																																																																																																																																																																																																																																																																																																																																																																																																																																																																																																																																																																																																																																																																																																																																																																																																																																																																																																																																																																																																																																																																																																																																																																																																																																																																																																																																																																																																																																																																																																																																																																																																																																																																																																																																																																																																																																																																																																																																																																																																																																																																																																																																																																																																																																																																																																																																																																																																																																																																																																																																									
										DESIGN: LB DRAWN: NV REVIEWED: LB			Sumitomo Metal Mining Pogo LLC			DRAWING TITLE: Figure 7.1g Drystack Tailings Facility Plan and Section End of 2018																																																																																																																																																																																																																																																																																																																																																																																																																																																																																																																																																																																																																																																																																																																																																																																																																																																																																																																																																																																																																																																																																																																																																																																																																																																																																																																																																																																																																																																																																																																																																																																																																																																																																																																																																																																																																																																																																																																																																																																																																																																																																																																																																																																																																																																																																																																																																																																																																																																																																																																																																																																																																																																																																																																																																																																																																																																																																																																																																																																																																																																																																																																																																																																																																																																																																																																																																																																																																																																																																																																																																																																																																																																																																																																																																																																																																																																																																																																																																																																																																																																																																																																																																																																																																																																																																																																																																																																																																																																																																																																																																																																																																																																																																																																																																																																																																																																																																																																																																																																																																																																																																																																																																									
										CHECKED: - APPROVED: - DATE: Feb. 2011																																																																																																																																																																																																																																																																																																																																																																																																																																																																																																																																																																																																																																																																																																																																																																																																																																																																																																																																																																																																																																																																																																																																																																																																																																																																																																																																																																																																																																																																																																																																																																																																																																																																																																																																																																																																																																																																																																																																																																																																																																																																																																																																																																																																																																																																																																																																																																																																																																																																																																																																																																																																																																																																																																																																																																																																																																																																																																																																																																																																																																																																																																																																																																																																																																																																																																																																																																																																																																																																																																																																																																																																																																																																																																																																																																																																																																																																																																																																																																																																																																																																																																																																																																																																																																																																																																																																																																																																																																																																																																																																																																																																																																																																																																																																																																																																																																																																																																																																																																																																																																																																																																																																																															
DRAWING NO.										DRAWING TITLE										DRAWING NO.										DRAWING TITLE										NO.										DESCRIPTION										CHK'D										APP'D										DATE										PROFESSIONAL ENGINEERS STAMP										FILE NAME:										SRK JOB NO.: 1CS021.000										DRAWING NO. 7										SHEET 7 of 7										REVISION NO. A																																																																																																																																																																																																																																																																																																																																																																																																																																																																																																																																																																																																																																																																																																																																																																																																																																																																																																																																																																																																																																																																																																																																																																																																																																																																																																																																																																																																																																																																																																																																																																																																																																																																																																																																																																																																																																																																																																																																																																																																																																																																																																																																																																																																																																																																																																																																																																																																																																																																																																																																																																																																																																																																																																																																																																																																																																																																																																																																																																																																																																																																																																																																																																																																																																																																																																																																																																																																																																																																																																																																																																																																																																																																																																																																																																																																																																																																																																																																																																																																																																																																																																																																																																																																																																																																																																																																																																																																																																																																																																																																																																																																																																																																																																																																																																																																																																																																																																																																																																																																																													

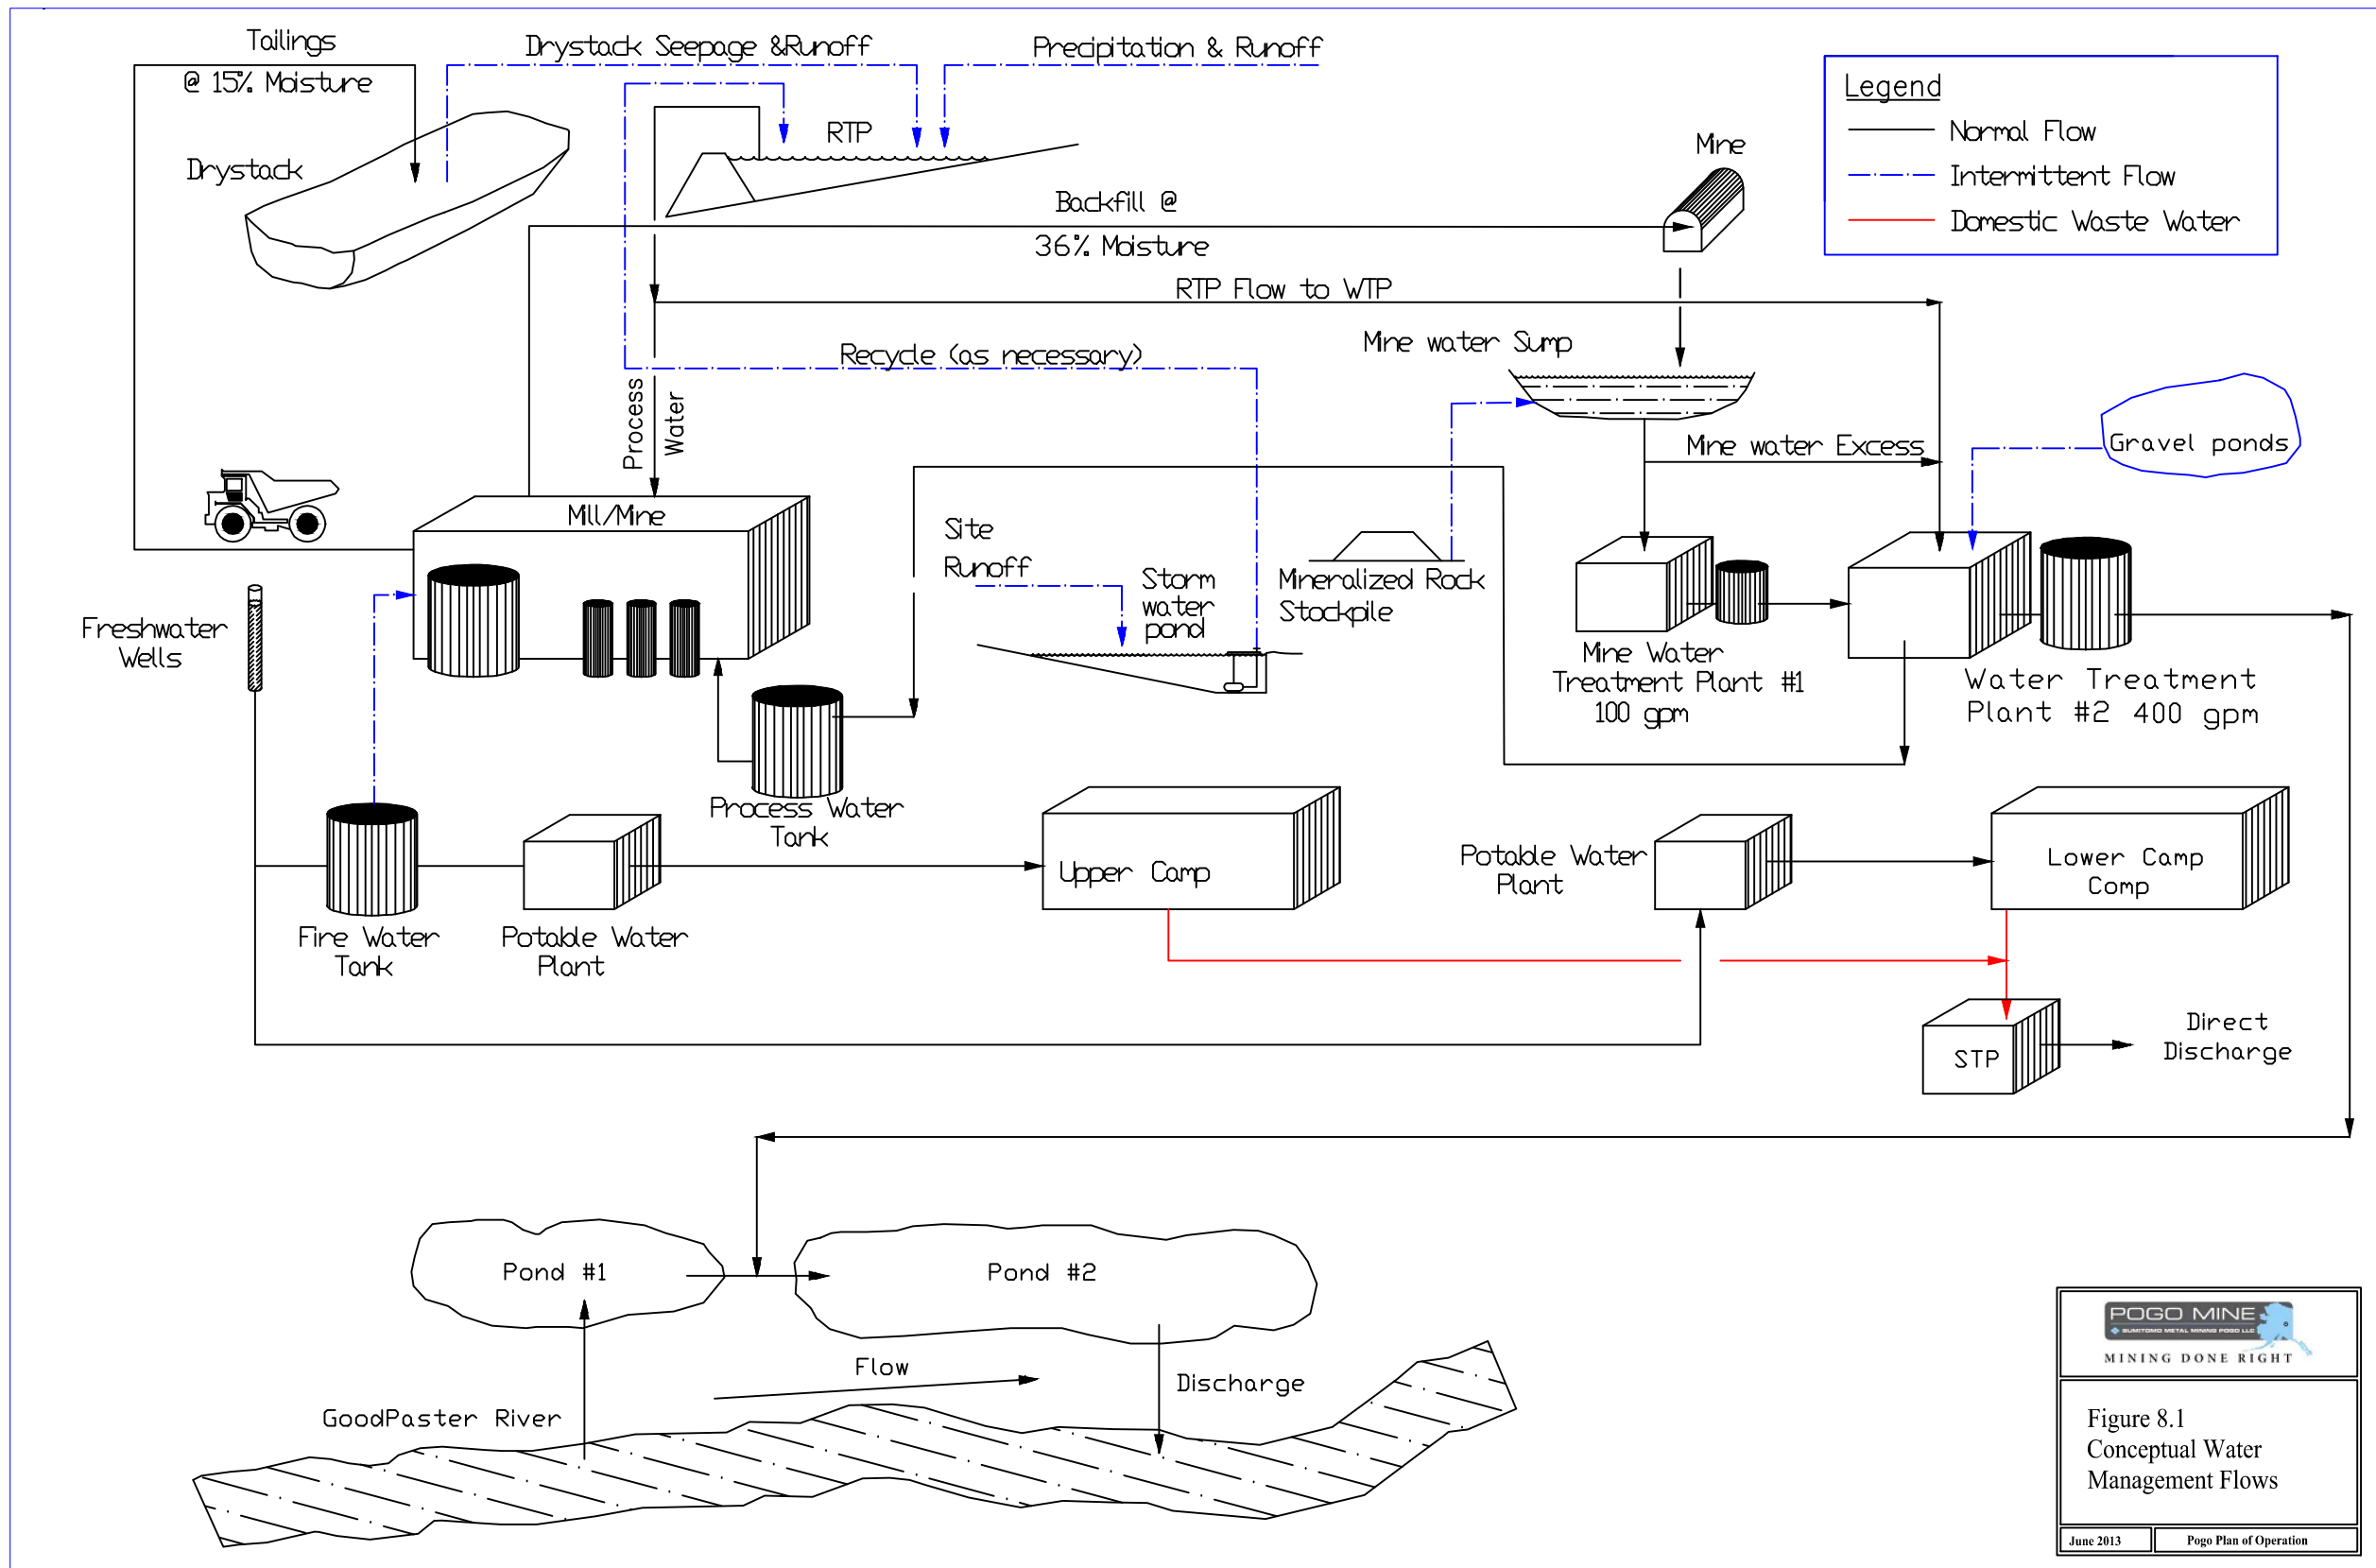


POGO MINE
MINING DONE RIGHT

Figure 8.1
Conceptual Water
Management Flows

June 2013 Pogo Plan of Operation

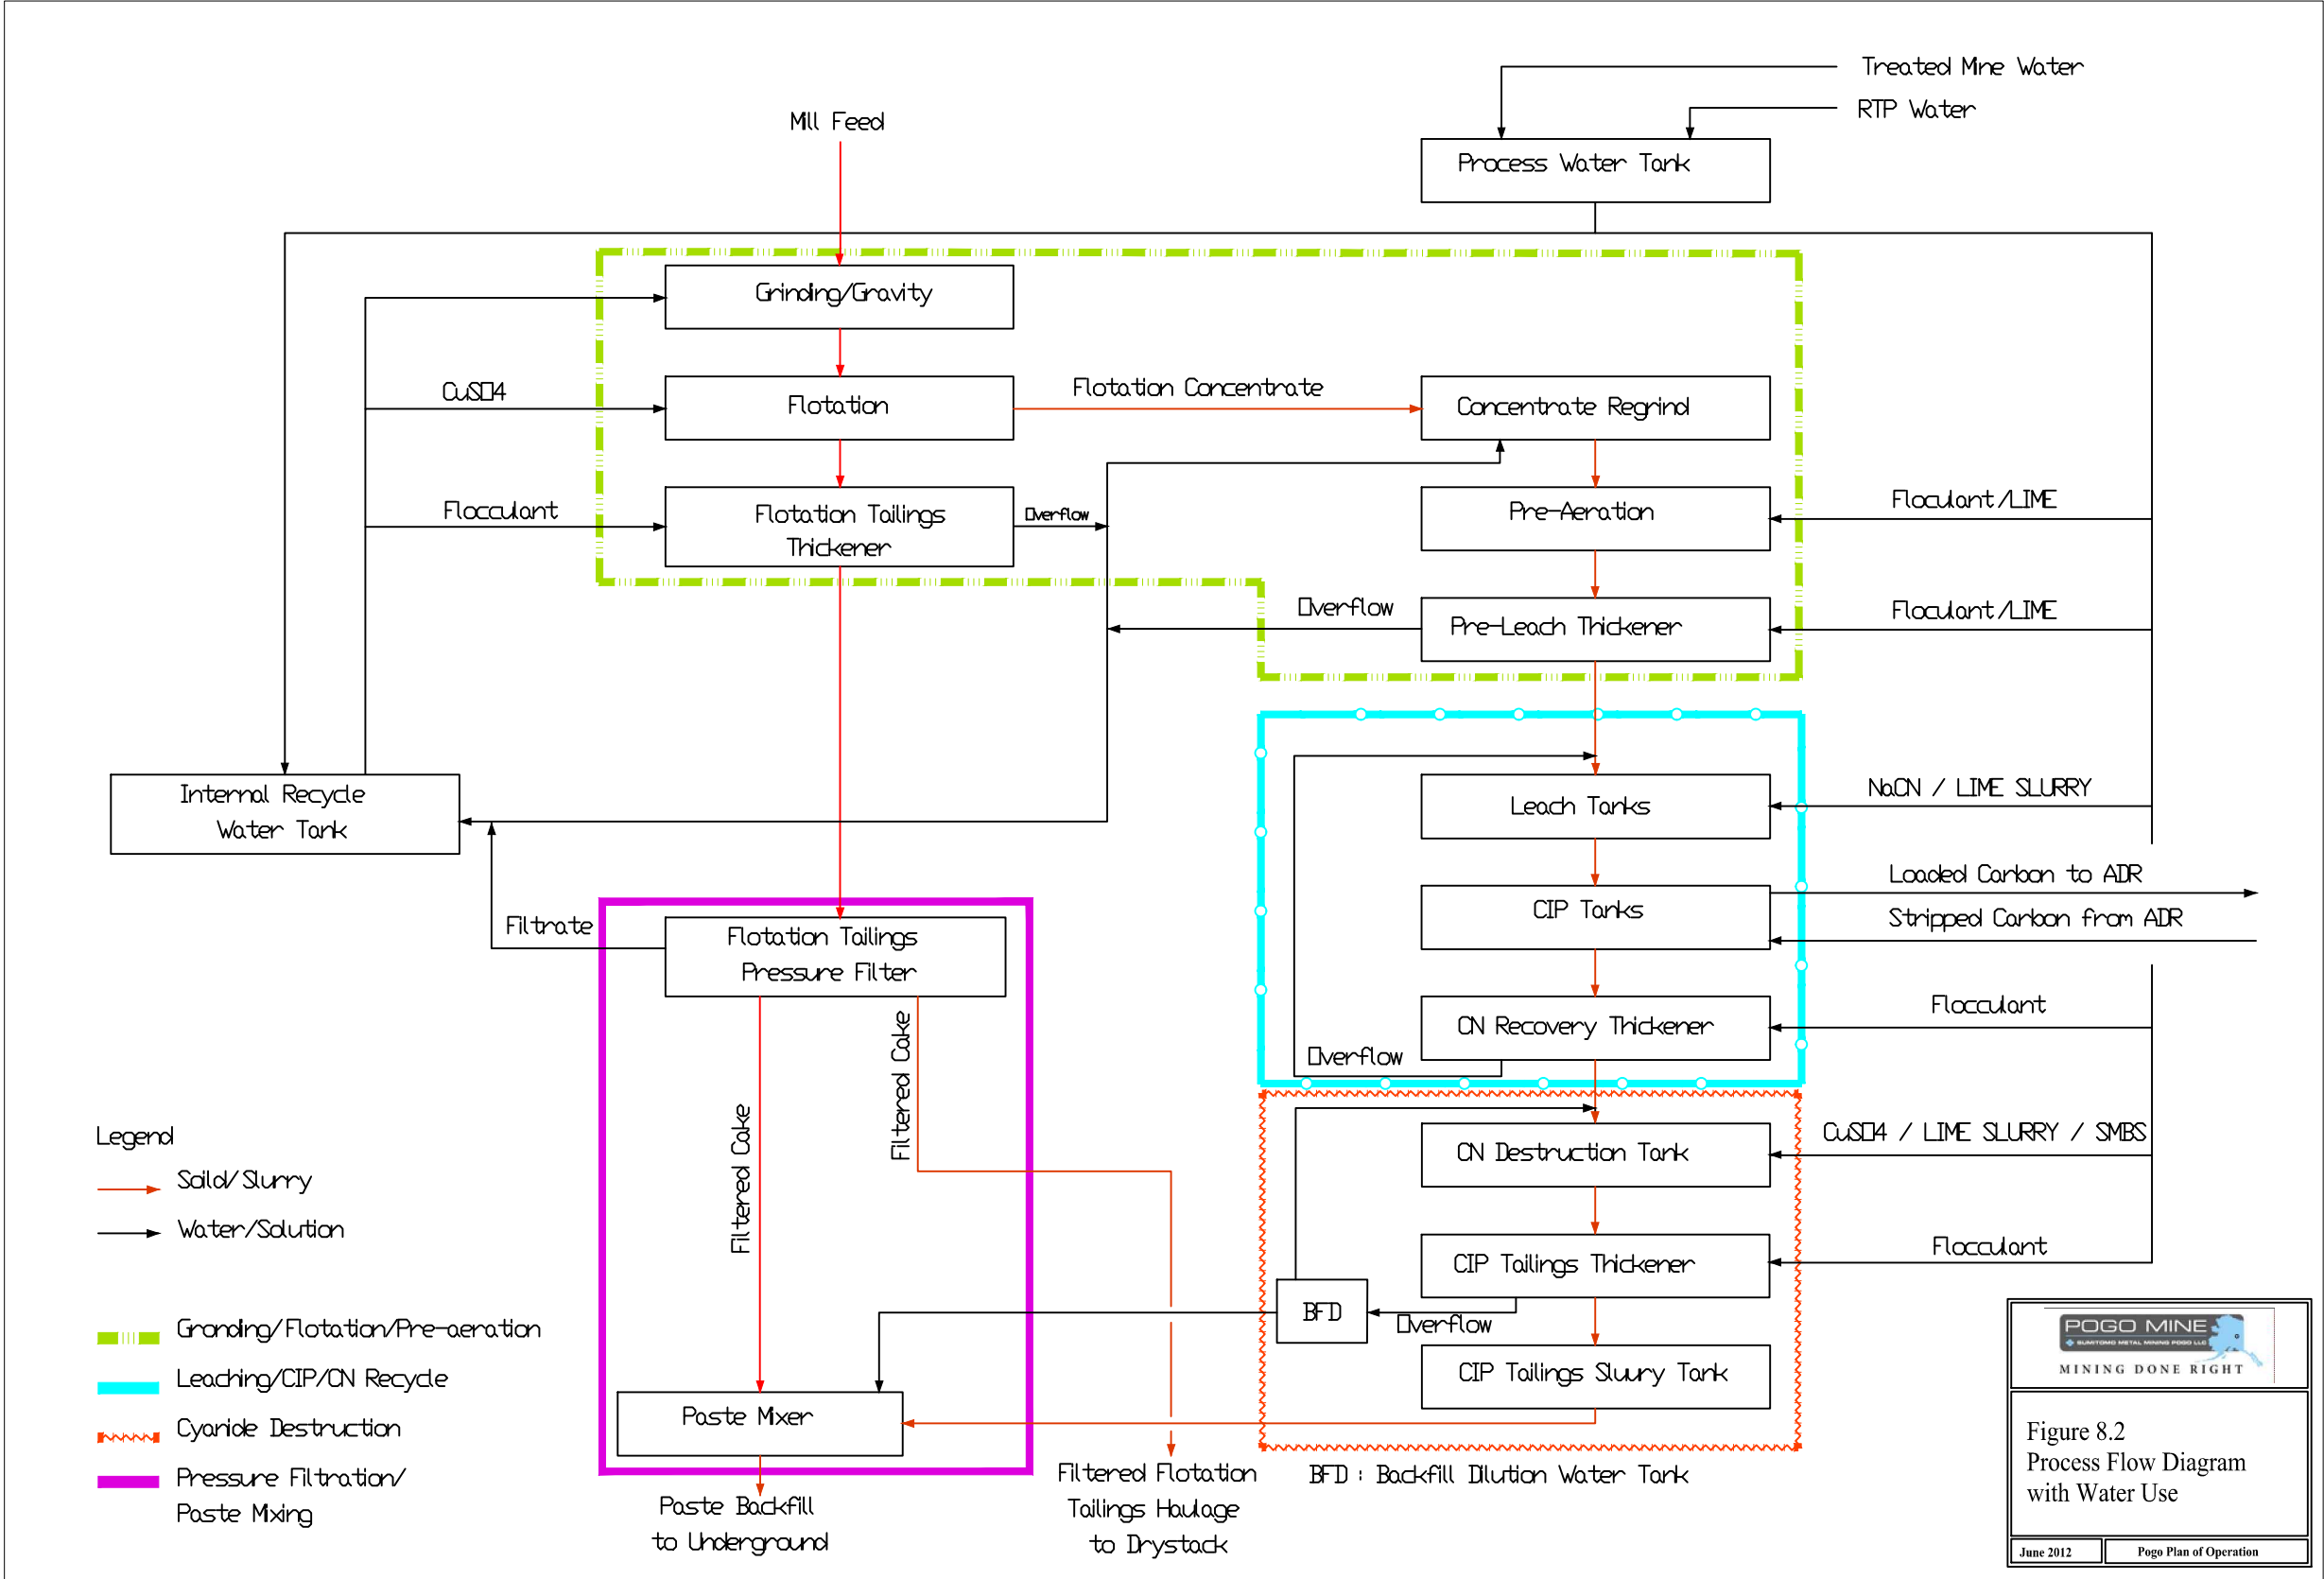

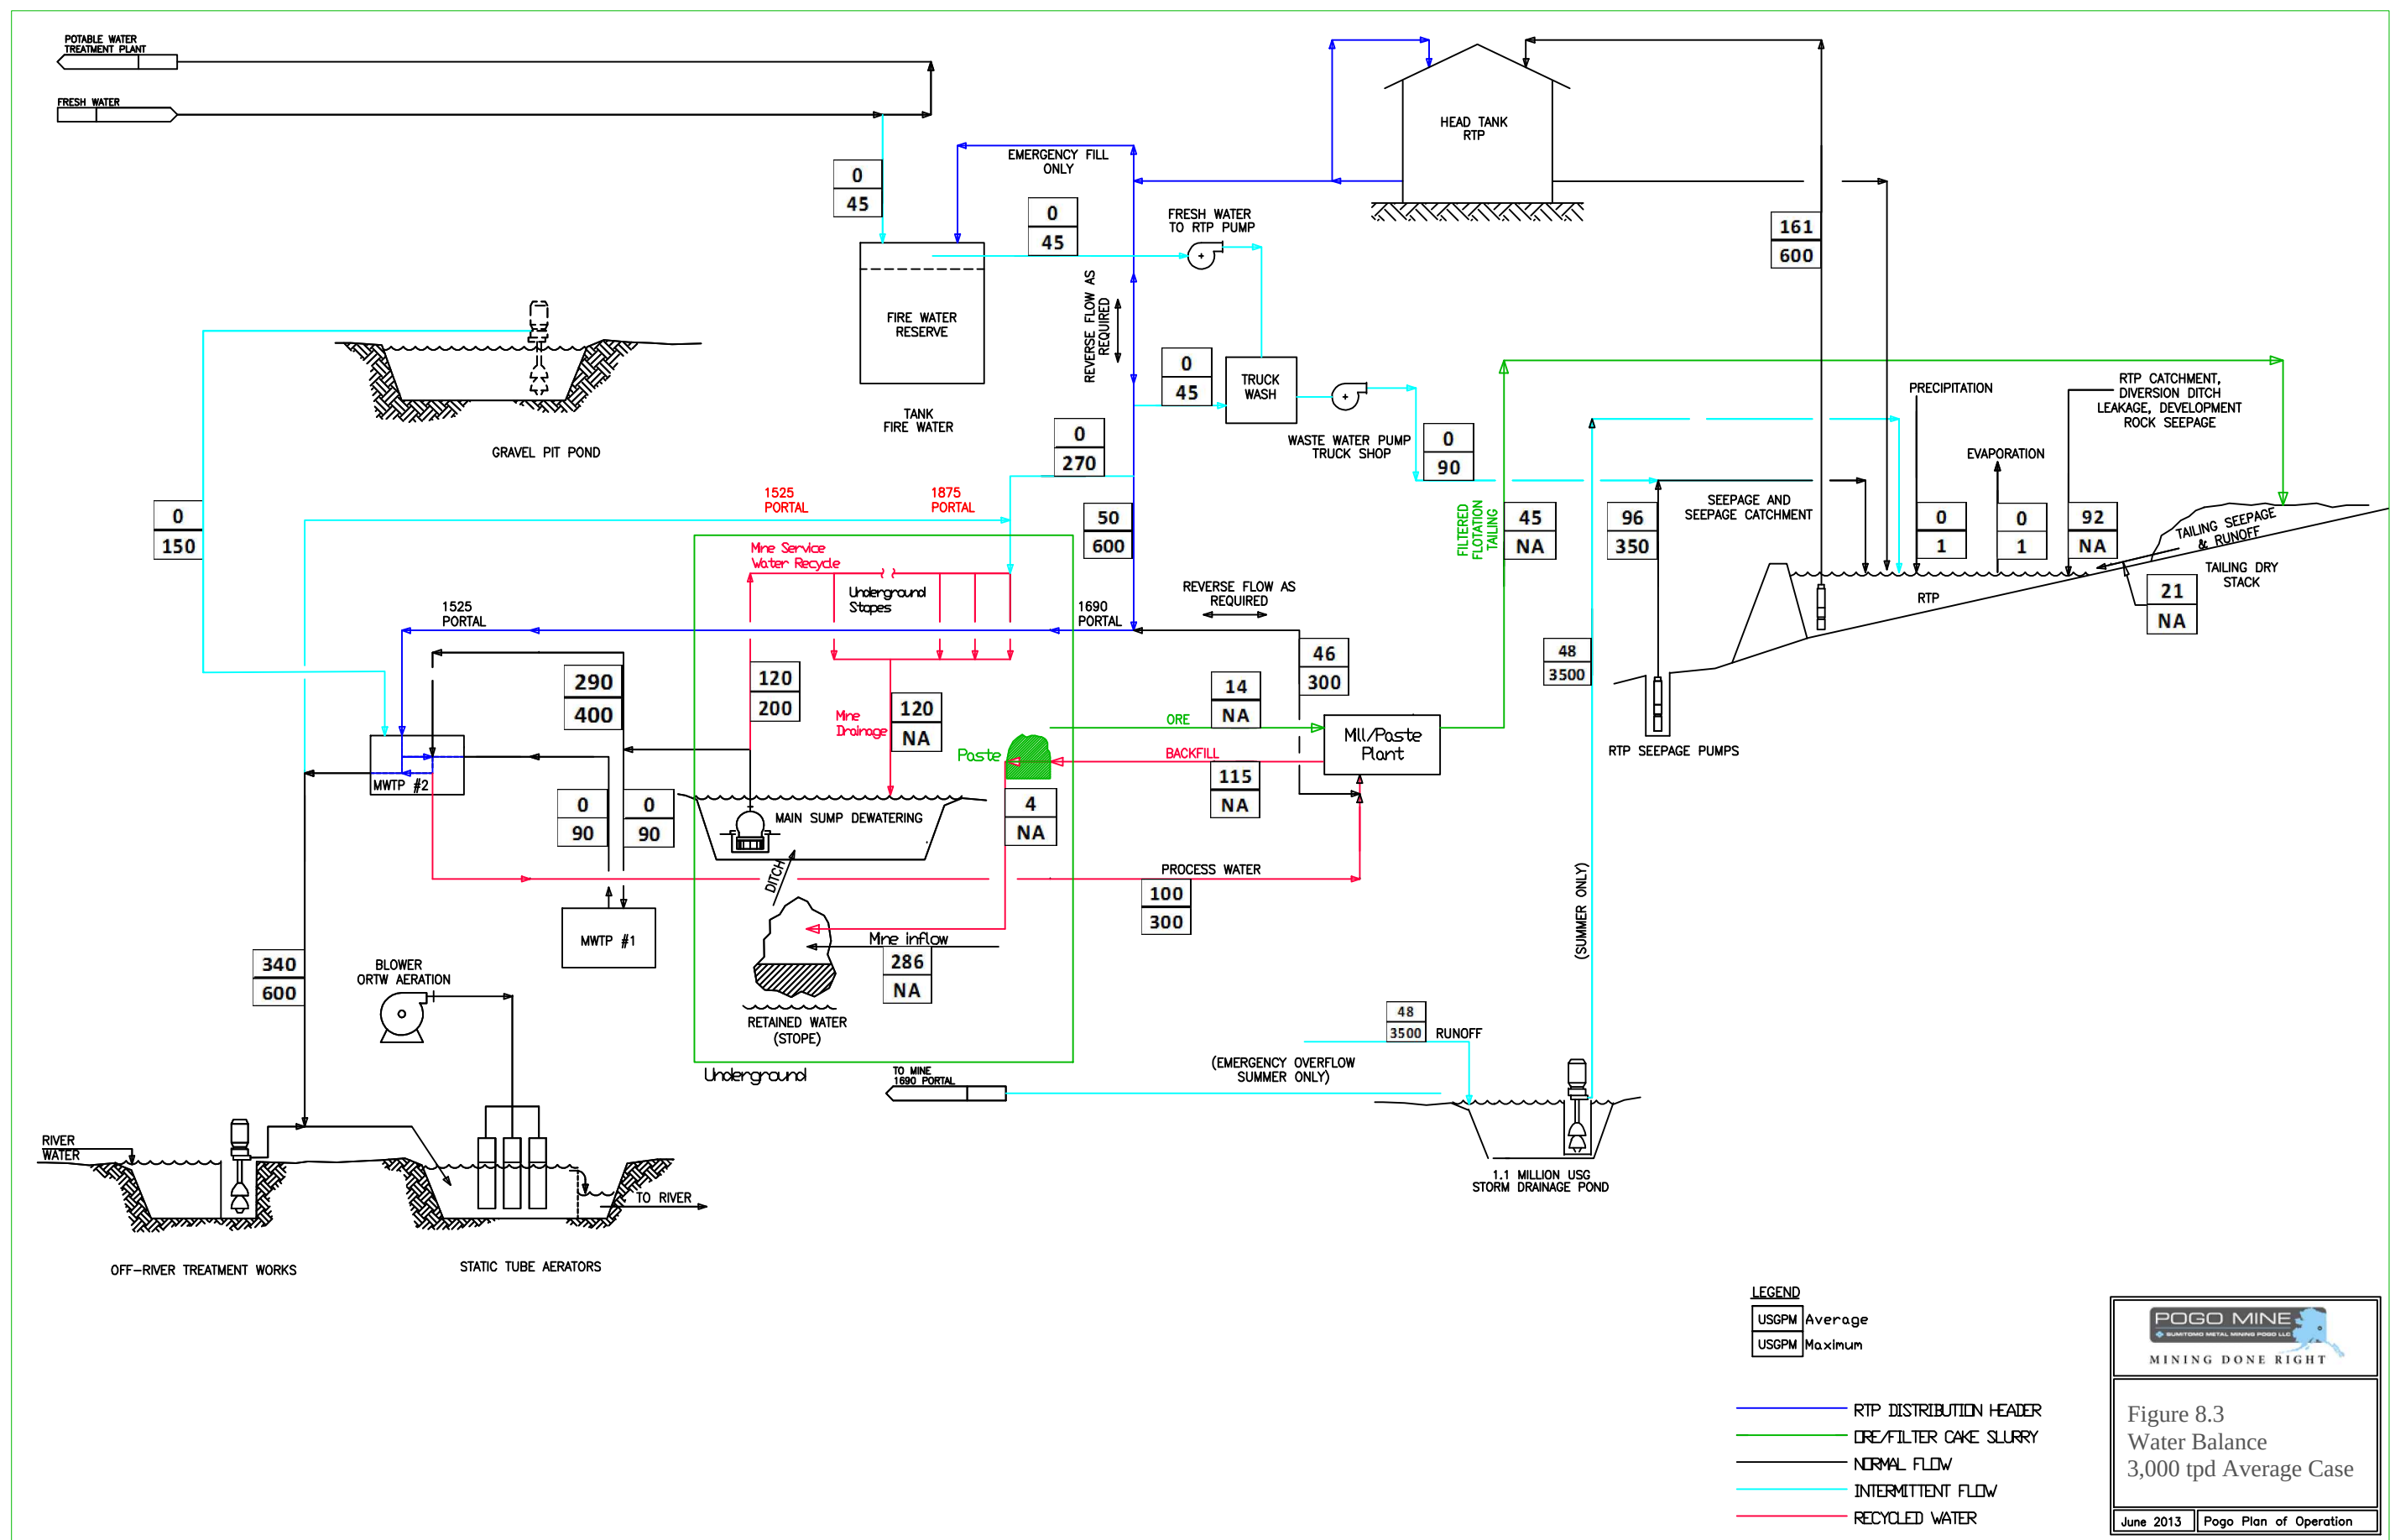

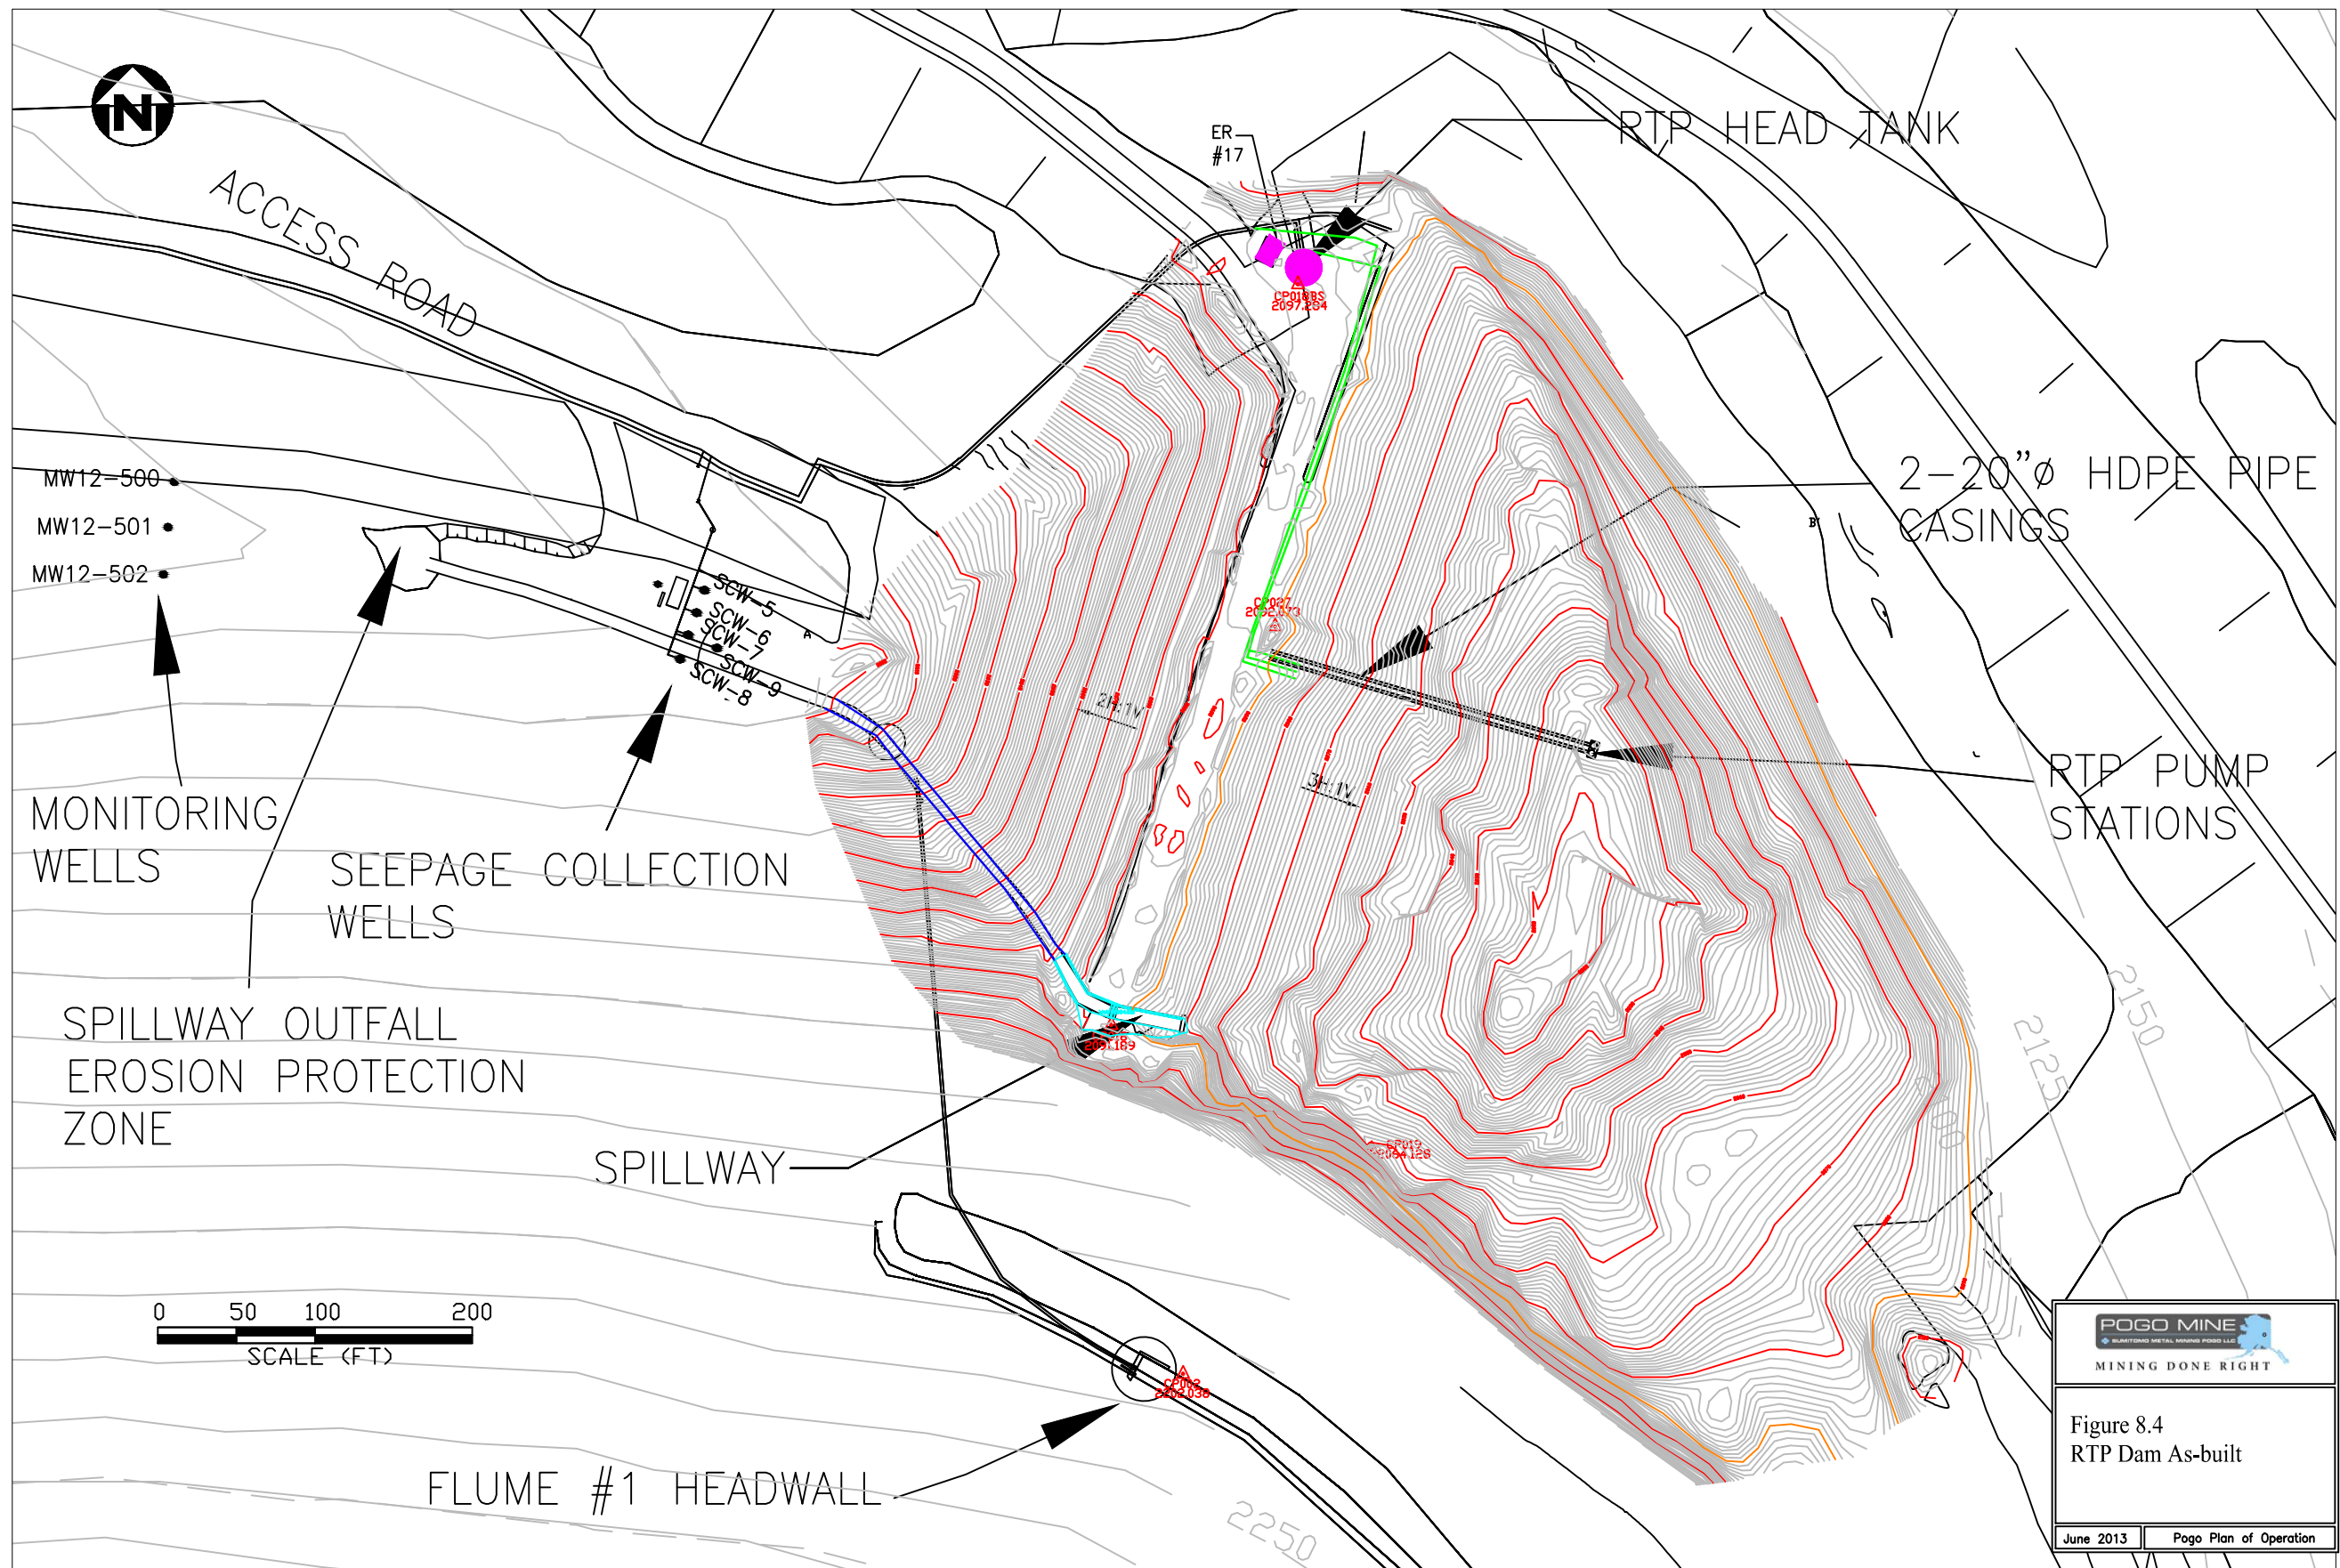


Figure 8.4
RTP Dam As-built

