

ADDENDUM TRANSMITTAL

ADDENDUM TO THE CONTRACT DOCUMENTS	Page Number 1	No. of Pages 2
Addendum No. One (1)	Date Addendum Issued: Feb. 25, 2026	
Issuing Office Alaska State Parks, Design & Construction Section 550 W. 7 th Ave., Suite 1340, Anchorage, Alaska 99501 Phone: 269-8731 Fax: 269-8907	Previous Addenda Issued None	
Project: Old Kasilof Landing SRS Facility Host Site Project No.: 73032-2	Date and Hour of Quotes Due Mar. 4th, 2026 at 2:00pm prevailing time	

NOTICE TO BIDDERS

Bidder must acknowledge receipt of this addendum prior to the hour and date set for the quotes being due by one of the following methods:

- (a) By acknowledging receipt of this addendum on the quote submitted.
- (b) By telegram or tele facsimile which includes a reference to the project and addendum number.

The bid documents require acknowledgment individually of all addenda to the drawings and/or specifications. This is a mandatory requirement and any quote received without acknowledgment of receipt of addenda may be classified as not being a responsive bid. If, by virtue of this addendum it is desired to modify a quote already submitted, such modification may be made by telegram or tele facsimile provided such a telegram or tele facsimile makes reference to this addendum and is received prior to the opening hour and date specified above.

THE PLANS ARE CLARIFIED AS FOLLOWS:

On sheet 6, detail 4/6, the tank capacity is stated as 1,500 gallons as the desired ultimate capacity. The reserve capacity, in note 5, is not in addition to the ultimate tank capacity. The high water alarm shall be set to trigger at approximately 1310 gallons, or 7/8th of the ultimate capacity of 1,500 gallons. When procuring and installing the wastewater holding tank, the contractor shall abide by all specifications in Section 626 and relevant ADEC regulations.

THE PLANS ARE MODIFIED AS FOLLOWS:

- Replace sheet 9 with modified sheet 9 (Attachment A).

The intent of these changes is to provide clarity on the electrical work and wiring design, as well as alter the AWG of the primary runs downstream of the meter to account for voltage drop.


Bidders are required to acknowledge this addendum on the proposal form or by FAX prior to the quotes being due.

Addendum Number One (1) received.

Name/Title Date

Firm

END OF ADDENDUM

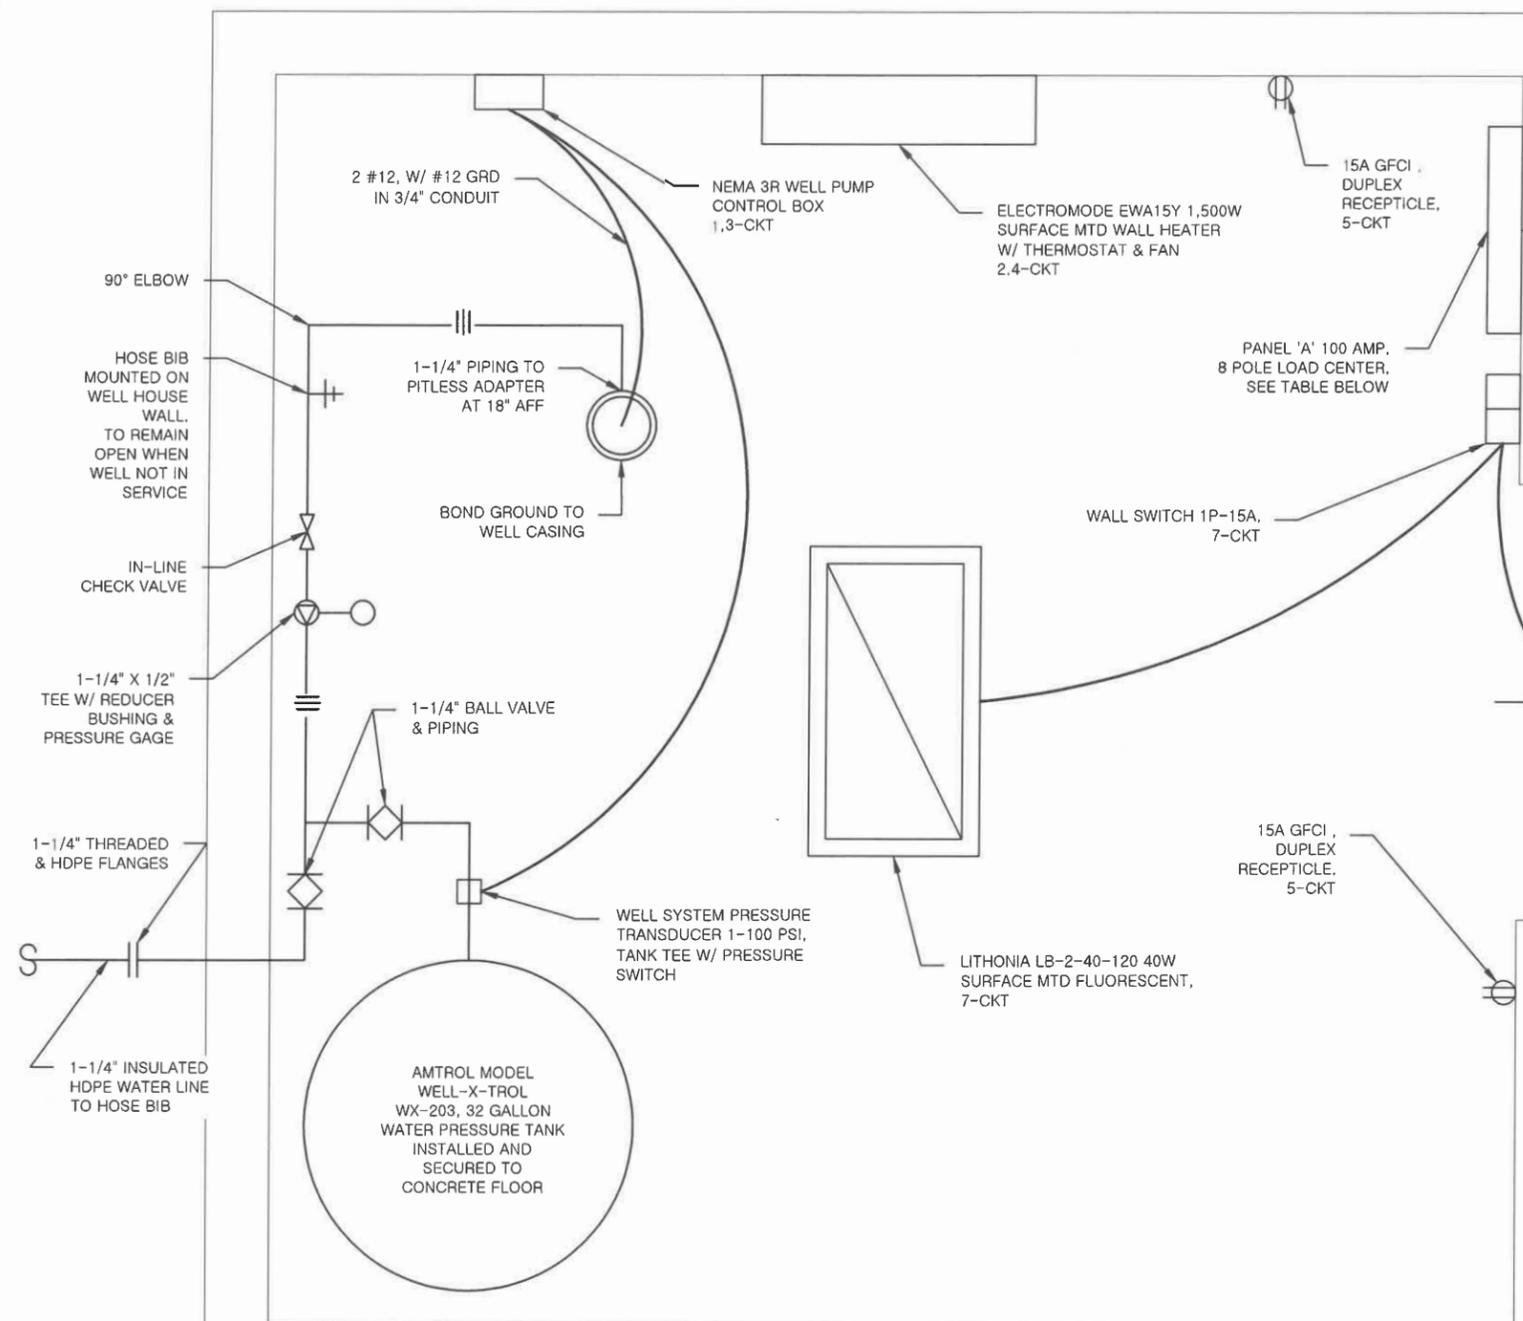


PANEL "A" - WELL HOUSE INTERIOR WALL SURFACE - VOLTAGE: 120/240V, 1PH, 3W, 100 AMP

CKT	DESCRIPTION	BREAKER	KVA		BUS	KVA		BREAKER	DESCRIPTION	CKT
			A	B		A	B			
1	WELL PUMP	15 /2	250			750		15 /2	HEATER	2
3				250			750	15 /2		4
5	OUTLET	20 /1	200					20 /1	SPARE	6
7	LIGHTS	20 /1		100				20 /1	SPARE	8
9	SPACE								SPACE	10
11	SPACE								SPACE	12

NOTE - PHASE A KVA: 1.2 & PHASE B KVA: 1.2

1 ELECTRICAL & PIPING FLOOR PLAN
SCALE: 1/2" = 1'-0"

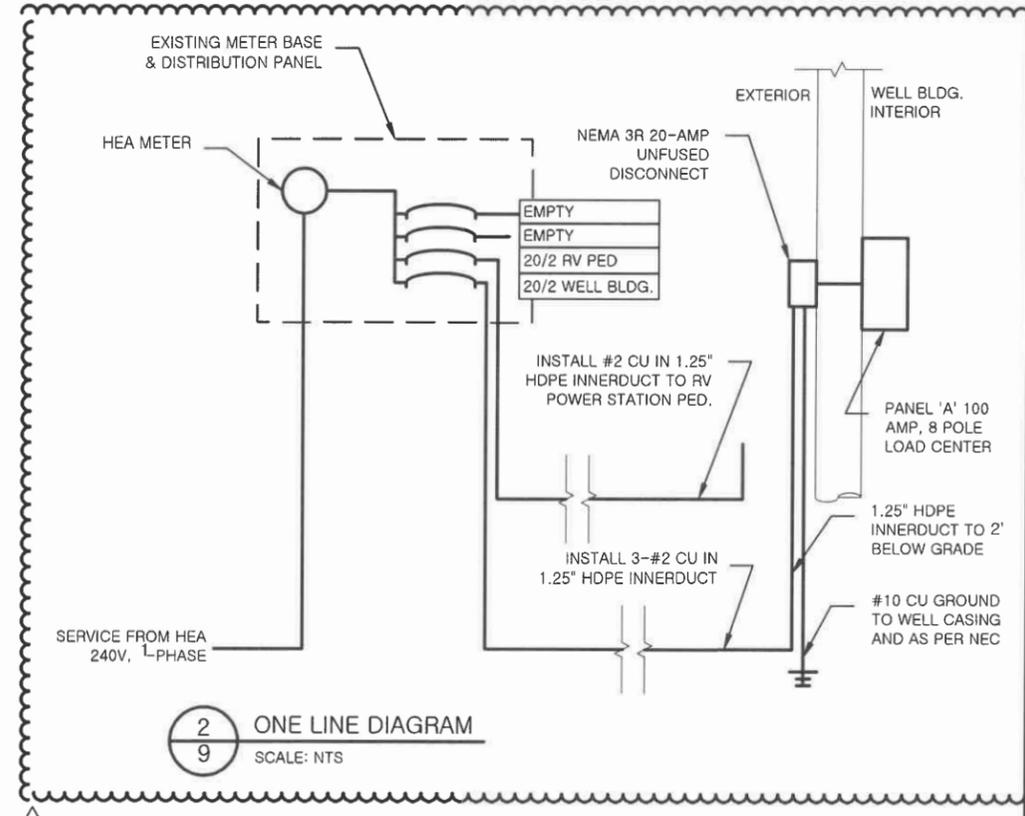

2 ONE LINE DIAGRAM
SCALE: NTS

- GENERAL ELECTRICAL NOTES:**
- ALL WORK SHALL BE IN ACCORDANCE WITH THE NATIONAL ELECTRICAL CODE (NEC) AND OTHER APPLICABLE CODES AND STANDARDS
 - WIRE SIZE SHALL BE #12 MIN. UNLESS OTHERWISE NOTED. WIRE SIZES SMALLER THAN #6 AWG SHALL BE THHN/THWN. #6 AWG WIRE & LARGER SHALL BE THW, UNLESS NOTED OTHERWISE
 - ALL #2 AWG CU WIRE SHALL BE XHHW-2
 - NEW TYPEWRITTEN PANEL DIRECTORY SHALL BE FURNISHED AFTER JOB IS COMPLETED REFLECTING AS-BUILT CONDITIONS
 - ALL ELECTRICAL WORK SHALL BE COMPLETED BY A LICENSED ELECTRICIAN, OR OTHER QUALIFIED PERSONNEL AS APPROVED BY THE ENGINEER.
 - THE RV POWER STATION PEDESTAL SHALL HAVE SUFFICIENT POWER TO FEED A SINGLE 50 AMP CIRCUIT
 - CONTRACTOR TO VERIFY POWER REQUIREMENTS ARE ADEQUATELY MET. THE ENGINEER SHALL BE INFORMED IF CHANGES TO THE ELECTRICAL DESIGN ARE NECESSARY

- GENERAL PIPING NOTES:**
- ALL WELL PIPING SHALL BE 1.25" DIA. GALVANIZED STEEL PIPE UNLESS NOTED OTHERWISE
 - WELL PUMP SHALL BE 240V, SINGLE PHASE, MINIMUM 15 GPM CAPACITY W/ TOTAL DESIGN HEAD OF 140 FEET RESIDUAL HEAD PLUS DEPTH FROM TOP OF CASING TO TOP OF WATER DRAWDOWN IN WELL.
 - ALL VALVES AND HOSE BIBS TO BE MIN. CLASS 125 BRASS. THREADED BALL, CHECK, AND GATE VALVES AS NOTED.
 - WELL CONTROL BOX SHALL BE NEMA 3R AND INCLUDE CAPACITOR START, RESETTABLE OVERLOAD RELAY, PRESSURE SWITCH RELAY, AND GROUND LUGS.

NO.	REVISION	DATE	NOTES
1	ADDENDUM 1	2/25/2026	CHANGES TO WIRING PLAN AND CLARITY

STATE OF ALASKA, DEPARTMENT OF NATURAL RESOURCES
PLANS DEVELOPED BY: DIVISION OF PARKS AND OUTDOOR RECREATION
 550 W 7TH AVE. SUITE 1340, ANCHORAGE, AK 99501 - 907.269.8731

WELL HOUSE PIPING & ELECTRICAL SCHEMATIC

OLD KASLOF LANDING SRS FACILITY HOST SITE PROJECT No. 73032-2

PREPARED: DKM
 DRAWN: DKM
 REVIEWED: RCS
 DATE: 02/2026

SHEET 9 OF 11 SHEETS