

TRANSMITTAL FORM

ADDENDUM TO THE CONTRACT DOCUMENTS	Page Number 1	No. of Pages 4
Addendum No. One (1)	Date Addendum Issued: February 26, 2026	
Issuing Office Alaska State Parks, Design & Construction Section 550 West 7 th Avenue, Suite 1340 Anchorage, Alaska 99501 Phone: (907) 269-8731 Fax: (907) 269-8901	Previous Addenda Issued None.	
Project: Potter Marsh Facility Improvements Project No.: 91032-2	Date & Hour of Quotes Due: March 5, 2:00 PM prevailing time	

NOTICE TO BIDDERS

Bidder must acknowledge receipt of this addendum prior to the hour and date set for the quotes being due by one of the following methods:

- (a) By acknowledging receipt of this addendum on the quote submitted.
- (b) By telegram or telefacsimile which includes a reference to the project and addendum number.

The bid documents require acknowledgment individually of all addenda to the drawings and/or specifications. This is a mandatory requirement and any quote received without acknowledgment of receipt of addenda may be classified as not being a responsive bid. If, by virtue of this addendum it is desired to modify a quote already submitted, such modification may be made by telegram or telefacsimile provided such a telegram or telefacsimile makes reference to this addendum and is received prior to the opening hour and date specified above.

The Plans are modified as follows:

- Replace Sheet 13 with modified Sheet 13 (Reference Addendum No. 1 – Attachment A)

The Special Provisions are modified as follows:

- Replace Page 27-28 with modified Page 27-28 (Reference Addendum No. 1 – Attachment B)


Bidders are required to acknowledge this addendum on the proposal form
or by FAX prior to the quotes being due.

Addendum Number One (1) received.


Name/Title Date

Firm


END OF ADDENDUM

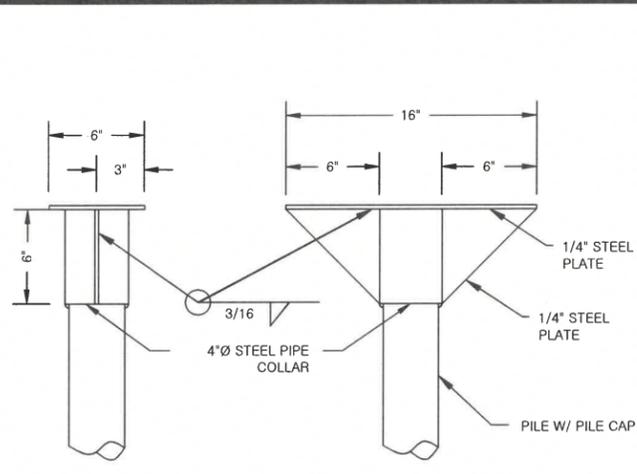


1
13 PILE CAP DETAIL
WOODEN BOARDWALK

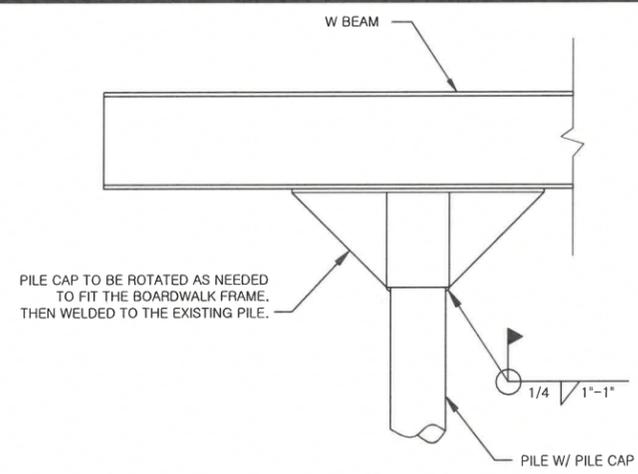


2
13 BEAM TO PILE CAP DETAIL
WOODEN BOARDWALK

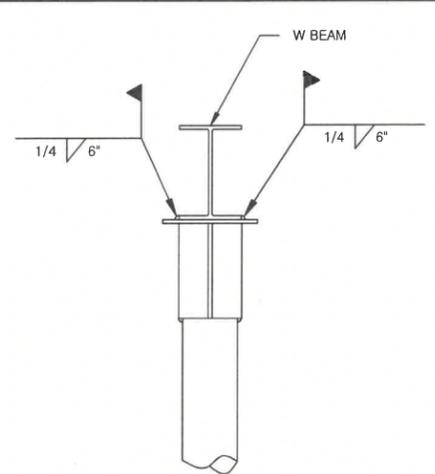

3
13 PILE CAP TO BEAM CONNECTION
WOODEN BOARDWALK

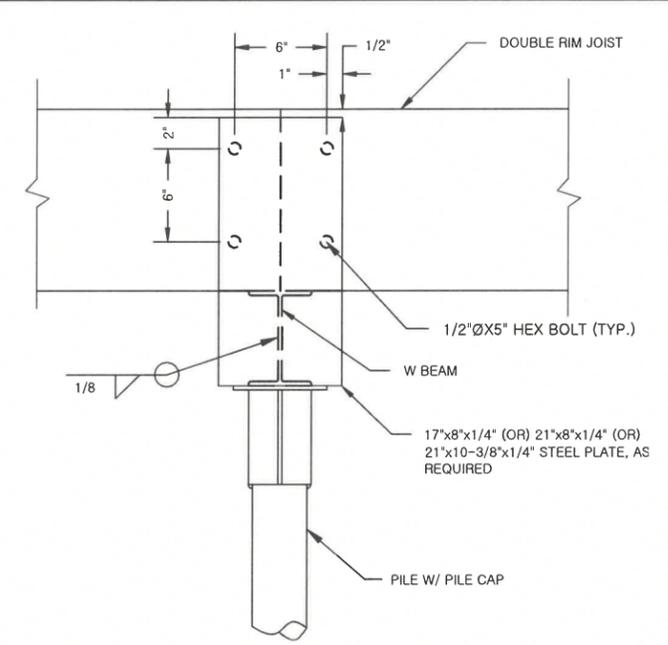


4
13 BEAM TO RIM JOIST
WOODEN BOARDWALK

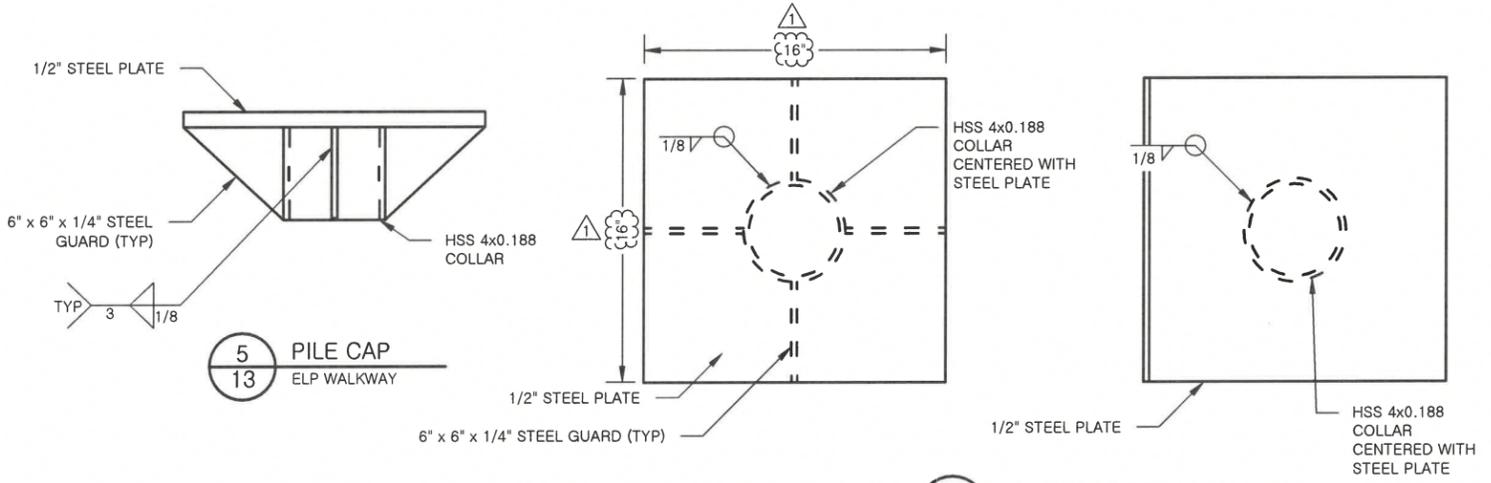


5
13 PILE CAP
ELP WALKWAY


6
13 PILE CAP DETAIL
ELP WALKWAY

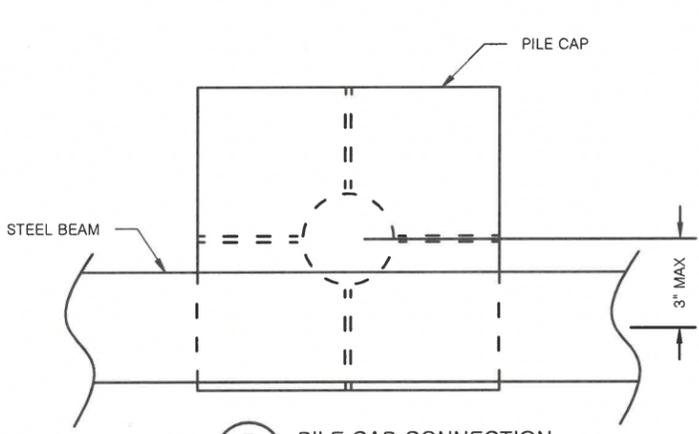

7
13 PILE CAP CONNECTION
ELP WALKWAY

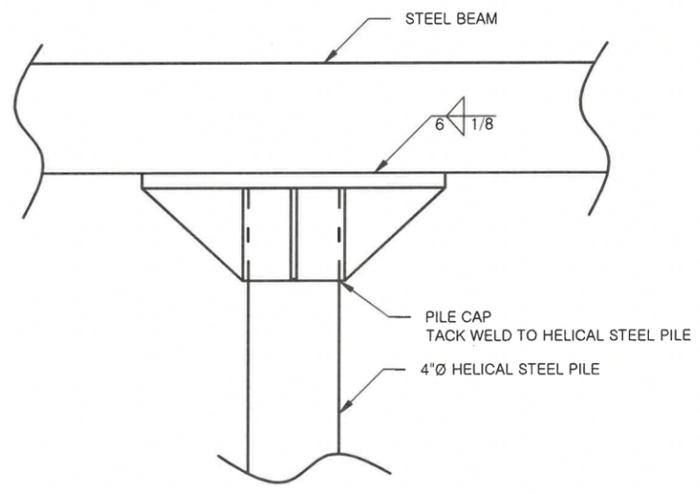

8
13 PILE CAP CONNECTION
ELP WALKWAY

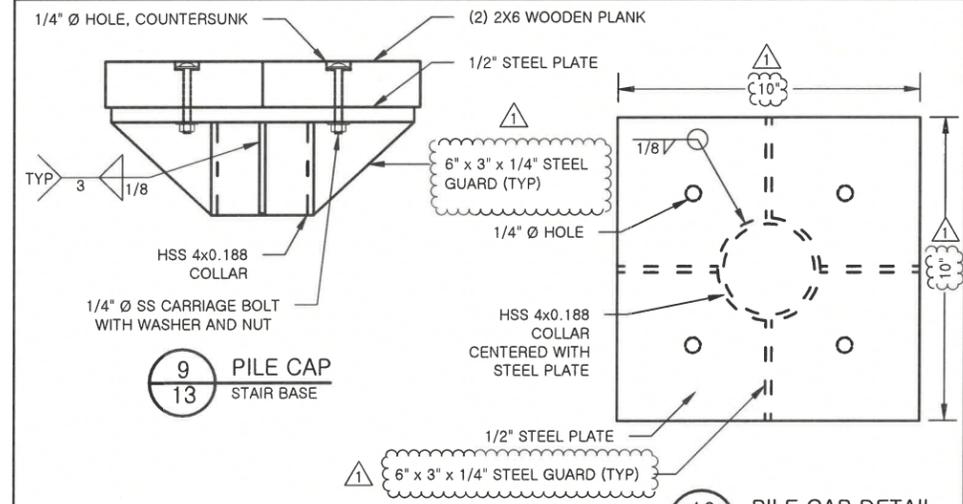

9
13 PILE CAP
STAIR BASE

10
13 PILE CAP DETAIL
STAIR DETAIL

NOTES:

- THE PILE DESIGN LOADS (UNFACTORED):
DEAD LOAD = 16 PSF
LIVE LOAD = 100 PSF
SNOW LOAD = 70 PSF
- PILES SHALL BE DRIVEN WITH AN ENGINEER APPROVED PILE DRIVER.
- ALL WELDING SHALL CONFORM TO THE REQUIREMENTS OF THE AWS STRUCTURAL WELDING CODE, AWS D.1 PUBLISHED BY THE AMERICAN WELDING SOCIETY.
- PILES SHALL BE DRIVEN TO A MINIMUM DEPTH OF 25' AND HAVE AN ULTIMATE BEARING CAPACITY OF 16,000 LBS.
- PILES AND PILE CAP MATERIAL SHALL BE HOT-DIP GALVANIZED.
- W BEAMS SHALL BE W6X12

NO.	REVISION	DATE	NOTES
1	ADDENDUM 1	2/26/2026	DIMENSION CORRECTION



STATE OF ALASKA, DEPARTMENT OF NATURAL RESOURCES
 PLANS DEVELOPED BY: DIVISION OF PARKS AND OUTDOOR RECREATION
 550 W 7TH AVE. SUITE 1340, ANCHORAGE, AK 99501 - 907.269.8731
 POTTER MARSH FACILITY IMPROVEMENTS
 PROJECT NO. 91032-2



PREPARED: AWH
 DRAWN: AWH
 REVIEWED: RCS
 DATE: FEB 2026

SHEET
13
 OF 17 SHEETS

PILE CONNECTION DETAILS

622-2.09 PAINT. Unless otherwise specified, use the following paint types and colors, or approved equals:

1. Solid Oil Stain. Exterior oil/alkyd flat finish stain, color "Russet". DF7XX as manufactured by Fuller O'Brien / Devoe Products, Sun-Proof Solid Alkyd/Oil Stain (77-1354) as manufactured by Pittsburgh Paint Company, Behr Plus 10 Solid Stain, Rural Manor II Solid Color Stain (714401x) as manufactured by Rodda Paint Co., or approved equivalent. Submit color samples of proposed substitutions for approval.
2. Semi-Transparent Oil Stain. Exterior alkyd based stain, color Sherwin Williams "SW 3507 Riverwood", Behr Superdeck "#1907 Canyon Brown", or PPG Architectural Finishes Olympic "Russet".
3. Clear Oil Stain. Non-pigmented penetrating exterior alkyd base stain formulated for water repellency.
4. Metal Primer Paint. As recommended by enamel paint manufacturer.
5. Enamel Paint. Exterior alkyd base gloss enamel. Color to match solid oil stain color.
6. Above Ground Wood Preservative. Brown preservative with active ingredient of minimum 9.08 percent copper naphthenate (equivalent to minimum 1 percent metallic copper). Color to be approved by Engineer.
7. Below Ground Wood Preservative. Preservative with active ingredient of minimum 16 percent copper naphthenate (equivalent to minimum 2 percent metallic copper).
8. End Cut Preservative for Treated Wood. Brown preservative with active ingredient of minimum 10 percent copper naphthenate (equivalent to minimum 1 percent metallic copper). Color to match preservative pressure treatment color.

Paint that has been frozen or is out of date shall be replaced at no additional cost to the Department.

622-2.10 ELP WALKWAY. Conform to the plans and specifications.

622-2.11 FIBERGLASS GRATING. Corrosion resistant, slip resistant, fire retardant, minimum ~~40%~~ 60% open area, ADA compliant, pultruded fiberglass grating with UV protection. Fiberglass grating shall be 1 1/2 inch thick grating, dark grey in color, and have a maximum deflection of 0.223 inches when spanned 36 inches and loaded at 500 pounds per square feet. Attach grating to substructure w/ clips & stainless self drilling & tapping screws provided by manufacturer.

SPECIAL PROVISIONS

Potter Marsh
Facility Improvements
Project No. 91032-2

The following are approved manufacturers with product series:

1. Fibergrate Safe-T-Span
Industrial Grating Series ~~I4015 I6010~~
5151 Beltline Rd.
Ste 1212 Dallas, TX 75254
<http://www.fibergrate.com>

2. Seasafe GatorDeck
GatorDeck Pultruded Grating Selection ~~I-4015 I-6010~~
209 Glaser Dr.
Lafayette, LA 70508
<http://www.seasafe.com>

3. McNichols Fiberglass Grating
Duragrid Series ~~MS-I-4015 MS-I-6010~~
3400-B Industry Drive East
Fife, WA 98424
<http://www.mcnichols.com>

For other equal manufacturers, submit for approval by the Engineer.

622-2.12 INTERPRETIVE BRACKET. Paint steel brackets after fabrication. Provide one pin-in-head torque machine bolt driver per sign.

622-2.13 SPOTTING SCOPE. Public use commercial grade binoculars with weatherproof housing and base. Viewer head removable from column for storage by unlocking pedestal cap barrel lock. No coin chute shall be ordered or provided, special instructions must be given to manufacturer to set the scope to operate with coin chute removed. The binoculars shall have the following characteristics of the Model Mark III Binoculars as manufactured by See Coast Manufacturing Company, Inc. or approved equal:

Height	60 Inches
Weight	95 Pounds
Castings	356 Aluminum Alloy
Column	4-1/2 Inch Diameter Aluminum Stanchion
Base	ADA Compliant Dual Base
Binoculars Width	12 Inches
Binoculars Length	22 Inches
Housing Movement	360° Rotation, 40° Up, and 40° Down
Power / Field of View	10X, 366' at 1,000 Yards
Coin Chute	None
Timing Mechanism	None
Color	Gray

SPECIAL PROVISIONS

Potter Marsh
Facility Improvements
Project No. 91032-2