

New Owner: Tim Shay?

STATE OF ALASKA
DEPARTMENT OF NATURAL RESOURCES
Division of Geological & Geophysical Surveys

14438

Drilling Permit No. _____
A.D.L. No. _____

LOCATION OF WELL (Please complete either 1a, 1b or 1c.)

1a. Borough MAT_SU	Subdivision	Lot	Block	1b. Vectors. 330' Full S.W. 1/4 Sec. 2	Section No. 2	Township N 18	Range 1	E ☒	Meridian S.M., PALMER
------------------------------	-------------	-----	-------	--	-------------------------	-------------------------	-------------------	--	---------------------------------

1c. DISTANCE AND DIRECTION FROM ROAD INTERSECTIONS	3. OWNER OF WELL: MYERS CONSTRUCTION Address: CHUGIAK AK.
Street Address and Area of Well Location	

2. WELL LOG	Material Type	Feet Below Surface		4. WELL DEPTH: (final) 150 ft.	5. DATE OF COMPLETION 1 - 20 - 87
		Top	Bottom		
	SOIL	0	2	6. ☒ Cable tool ☐ Rotary ☐ Driven ☐ Dug	
	GRAVEL SILT BOULDERS	2	60	☐ Auger ☐ Jetted ☐ Bored ☐ Other:	
	cobbles silt	80	100	7. USE: ☒ Domestic ☐ Public Supply ☐ Industry	
	gravel silt H ₂ O	100	103	☐ Irrigation ☐ Recharge ☐ Commercial	
	sandstone H ₂ O	103	150	☐ Test Well ☐ Other:	
				8. CASING: ☐ Threaded ☒ Welded	
				diam. 6 in. to 100 ft. Depth Weight 17 lbs./ft.	
				diam. _____ in. to _____ ft. Depth Stickup _____ ft.	
				9. FINISH OF WELL: open	
				Type: _____ Diameter: 6	
				Slot/Mesh Size: _____ Length: _____	
				Set between _____ ft. and _____ ft.	
				Backfilling _____ Gravel pack _____	
				10. STATIC WATER LEVEL: 87 ft. 1/20/87	
				☐ Above or ☐ Below land surface Date	
				Equipment used: _____	
				11. PUMPING LEVEL below land surface and YIELD	
				145 ft. after _____ hrs. pumping 1.5 g.p.m.	
				_____ ft. after _____ hrs. pumping _____ g.p.m.	
				12. GROUTING Well Grouted: ☐ Yes ☒ No	
				Material: ☐ Neat Cement ☐ Other: _____	
				13. PUMP: (if available) HP 1 1/2	
				Length of Drop Pipe _____ ft. capacity _____ g.p.m.	
				☒ Subm. ☐ Jet ☐ Centrifical ☐ Other	
				14. REMARKS:	

RECEIVED
FEB 2 1987

Environmental Conservation

16. WATER WELL CONTRACTOR'S CERTIFICATION:

This well was drilled under my jurisdiction and this report is true to the best of my knowledge and belief;

GENE SKYLES WELL DRILLING

A16951

Registered Business Name

Contract License Number

Address: **P.O. BOX 671473, CHUGIAK, AK.**

Signed: **Gene Skyles**
Authorized Representative

Date: **Jan 21, 1987**




14438

RECEIVED
DEC 24 1986

Environmental Conservation

SAVED
STARKS

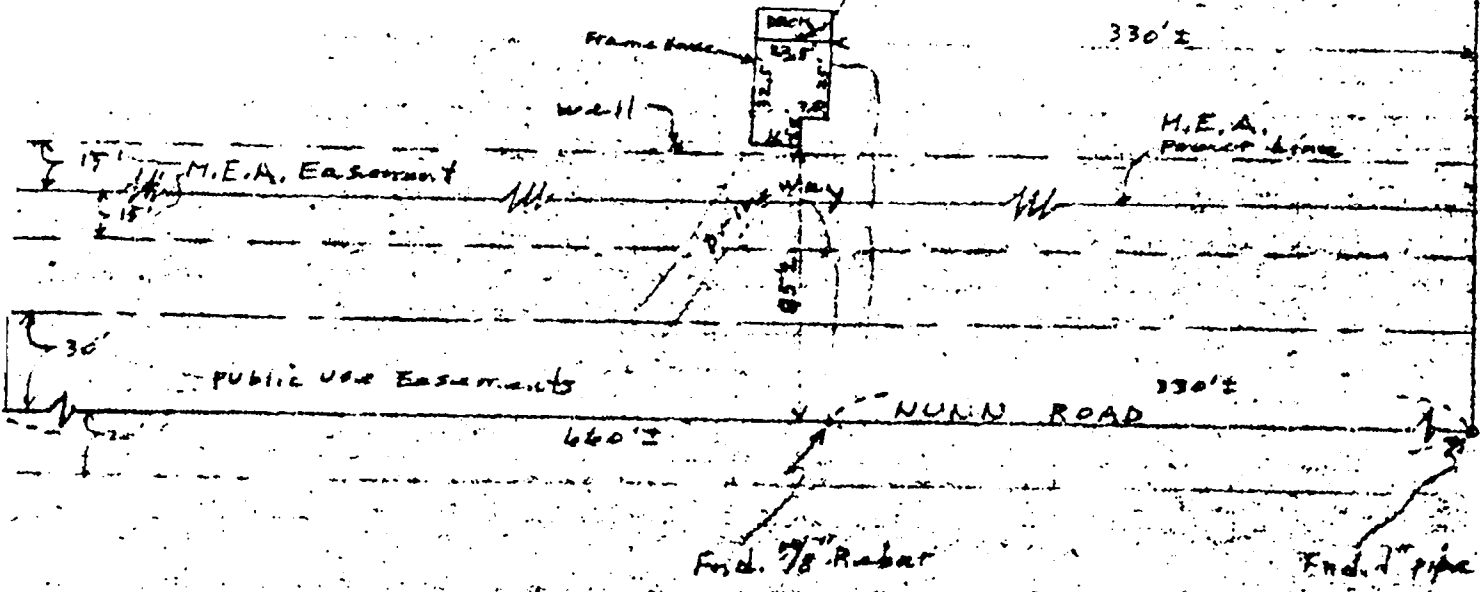

AS-BUILT


I hereby certify that I have surveyed the following described property: SE 1/4 SE 1/4 SE 1/4

NW 1/4 Section 2, T18N, R1E, S14

Anchorage Recording Precinct, Alaska, and that the improvements situated thereon are within the property lines and do not overlap or encroach on the property lying adjacent thereto, that no improvements on property lying adjacent thereto encroach on the premises in question and that there are no roadways, transmission lines or other visible easements on said property except as indicated hereon.

Dated at Eagle River, Alaska
this 5th day of DEC. 1986

SCALE: 1\"/>

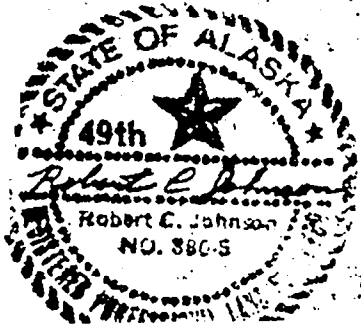

SA 18-1-28D