

Allen Ploring/P. Etherington
Lot 12, B10, Devon Wood Subd. **WELL DRILLERS REPORT**
SE SE SW SW Sec. 27, T18N, R1W, S1M (N02-W63)
Please complete this form in its entirety

Log No. 15133
Permit No.
Basin.

1. OWNER Rick Beckstrand ADDRESS P.O. Box 872941 WASILLA

Lot - 3415. Selden Rd -
2. LOCATION 1/4 1/4 Sec. T. N/S R. E. Count
PERMIT NO.

3.	TYPE OF WORK				4.	PROPOSED USE				5.	TYPE WELL				
	New Well	☒	Recondition	☐		Domestic	☒	Irrigation	☐	Test	☐	Cable	☐	Rotary	☒
	Deepen	☐	Other	☐		Municipal	☐	Industrial	☐	Stock	☐	Other	☐		

6. LITHOLOGIC LOG

Material	Water Strata	From	To	Thickness
Over burden		0	3	3
clay/gravel				
with sand streaks		3	25	22
Hard pack gravel		25	90	65
Sand / med gravel		90	100	10
	10			

8. WELL CONSTRUCTION

[illegible]

Surface seal: Yes ☐ No ☐ Type.....

Depth of seal.....feet

Gravel packed: Yes ☐ No ☐

Gravel packed from.....feet to.....feet

Perforations:

Type perforation.....
Size perforation.....

From feet to feet
 From feet to feet
9. WATER LEVEL

Static water level 75 Feet below land surface
Flow 20 G.P.M.
Water temperature ° F. Quality

10. DRILLERS CERTIFICATION

This well was drilled under my supervision and the report is true to the best of my knowledge.

Name Erny Helban

Address P.O. Box 872073 Las Vegas

Nevada contractor's license number A 15455

Nebraska driller's license number.....

Signed X. B. Holcha

Date 6-28-85

7. WELL TEST DATA

Pump RPM	G.P.M.	Draw Down	After Hours Pump
20	gal min		
	<u>H.I.R. tested</u>		


BALLER TEST

G.P.M. Draw down.....feethours
G.P.M. Draw down.....feethours
G.P.M. Draw down.....feethours

USE ADDITIONAL SHEETS IF NECESSARY

3B-1-27


15133

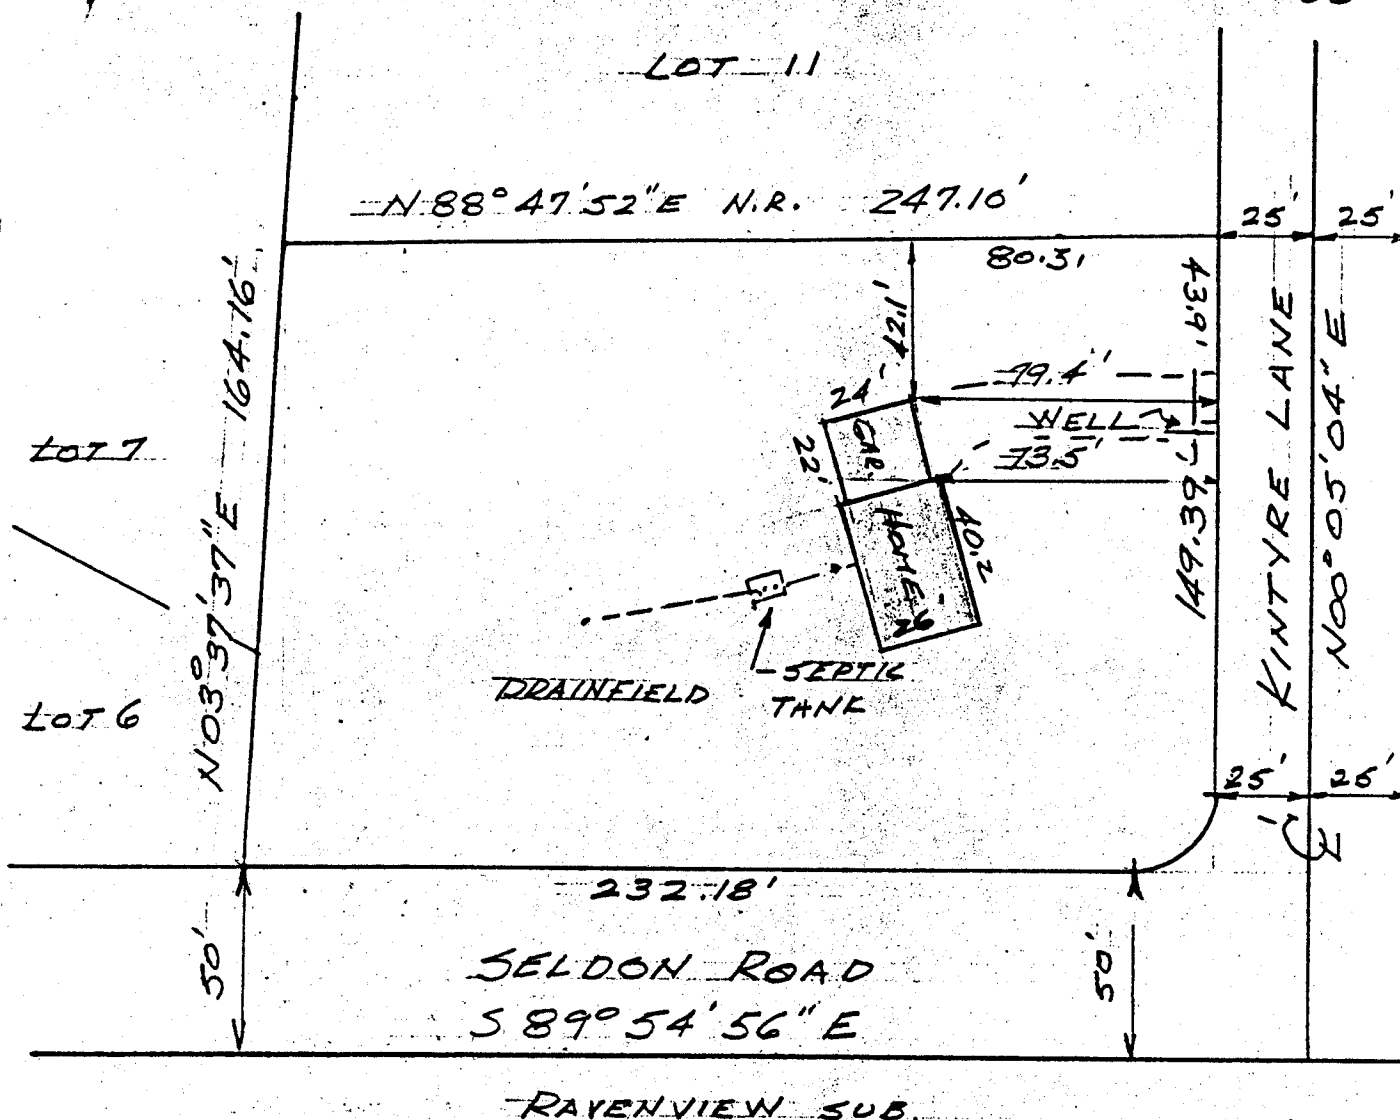

RAVENVIEW SUB.

AS-BUILT SURVEY

I hereby certify that I have made a survey of the above described property and that the improvements situated thereon are within the boundaries of said tract and do not overlap or encroach on the property lying adjacent thereto and that the improvements on the property lying adjacent thereto do not encroach on the premises in question and that there are no roadways, transmission lines, or other visible easements on said property, except as indicated hereon.

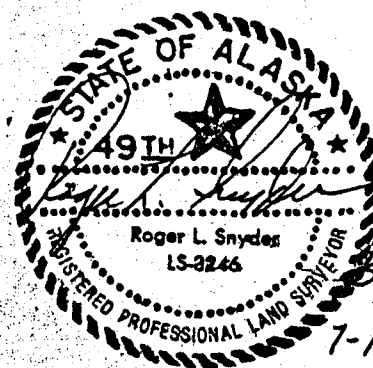

SB18-1-27

SCALE 1" = 40'

7-12-85

ALASKAN ENERGY SURVEY

AS BUILT SURVEY

LOT 12 - BLOCK 10

DEVON WOOD # 2