

LeRoy & Desiree Faller
SW SW NW SW Sec. 22
T17N, R2E, SM (N24-W78)

WATER WELL RECORD

STATE OF ALASKA

DEPARTMENT OF NATURAL RESOURCES

Division of Geological & Geophysical Surveys

LOCATION OF WELL (Please complete either 1a, 1b or 1c.)

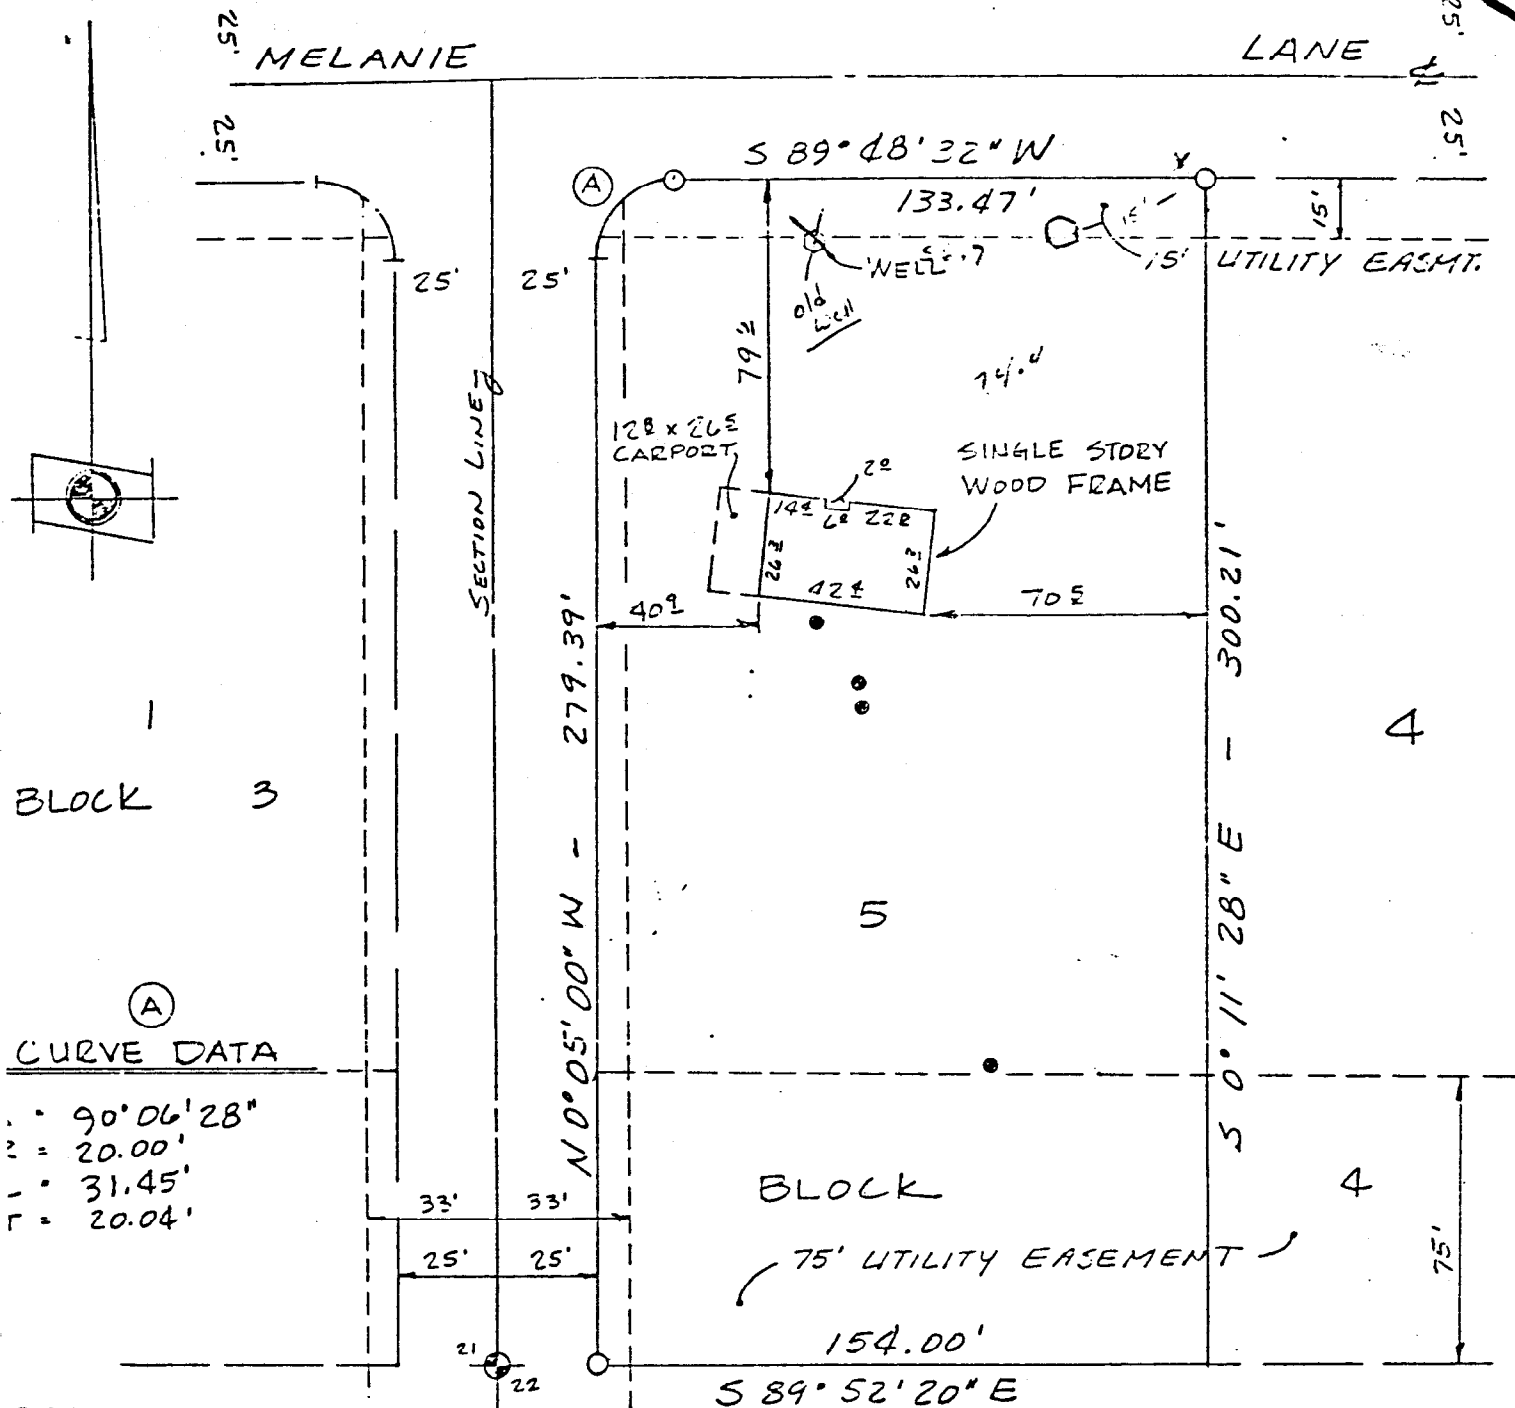
Drilling Permit No.

A. D. L. No.

[illegible]

6/3246 149 05 05 02
USGS Local No. 5A17-2-22 C8CC 2-14

16726

**AS-BUILT CERTIFICATE:**

I hereby certify that I have surveyed the above property and that no encroachments exist except as noted.

EXCLUSION NOTE:

It is the responsibility of the owner to determine the existence of any easements, covenants, or restrictions which do not appear on the recorded subdivision plat. Under no circumstances should any data herein be used for construction or for establishing boundary or fence lines.

I HEREBY CERTIFY THAT THE INFORMATION SHOWN HEREON IS TRUE AND CORRECT AND HAS BEEN ESTABLISHED BY ACCEPTABLE SURVEYING TECHNIQUES.

DRAWN BY **AKC****LEGEND**CHECKED BY **AKC**

SCALE 1" = 50'

- WELL
- SEPTIC RISER
- FOUND 1/2" REBAR

SA 17-2-22 OK 2-14