
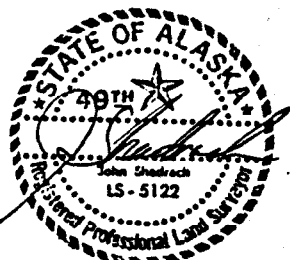


*Guide for Using the Hydrogeologic Classification System for Logging Water Well Boreholes by Thomas M. Hanna NGWA Press

SA 18-2-31 DCAC

18131

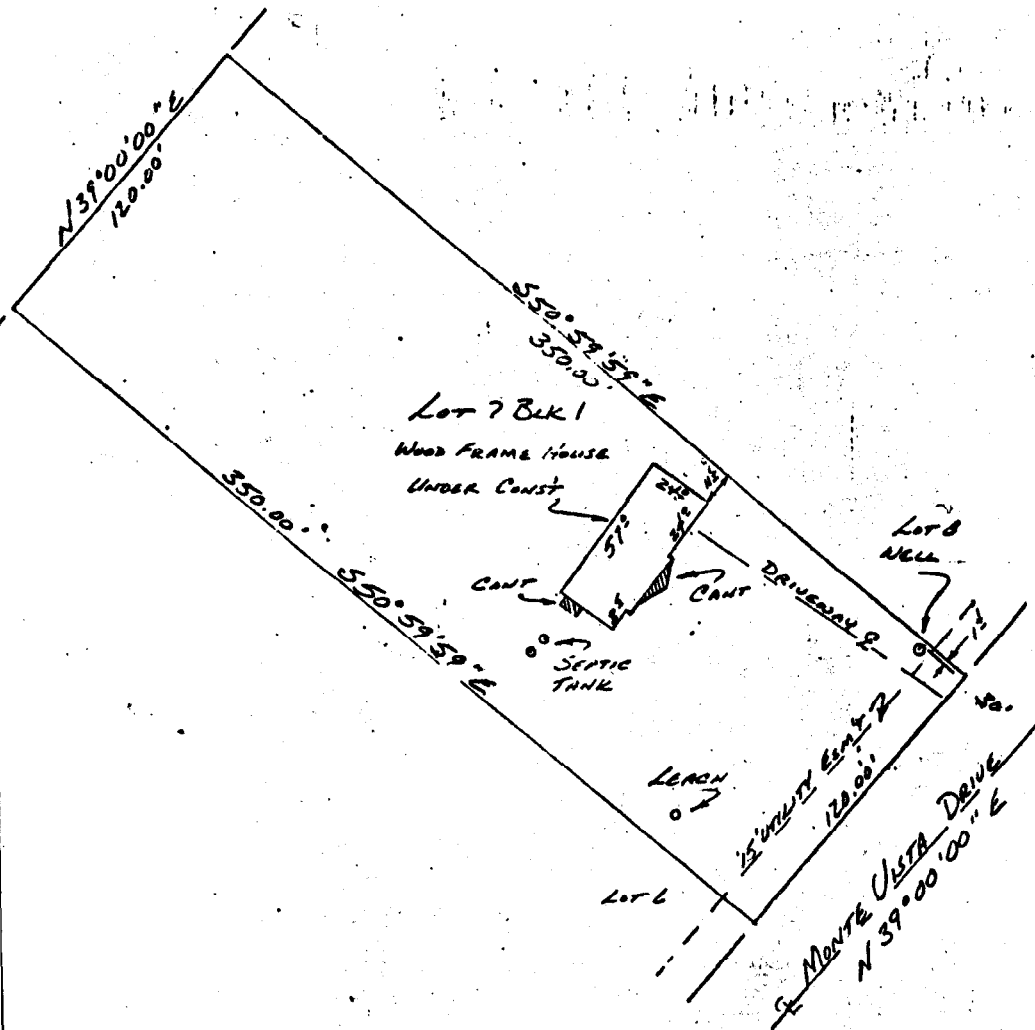

AS BUILT SURVEY

SURVEYOR:

JOHN SHADRACH, R.L.S.

P.O. BOX 1497 WASILLA, ALASKA 99687

DESCRIPTION: Lot 7 Blk 1.

DATE:

MONTE VISTA

10-14-86

SCALE:

DRAWN BY:

BOOK No.

1"=50'

JS

86-9 Pg 12

SA 18-a-31 DCAC

PREPARED FOR:

STEVE ORR