

ALASKA DEPARTMENT OF ENVIRONMENTAL CONSERVATION

Inspection Report For On-Site Individual
Sewage And Water Systems

GENERAL INFORMATION

Legal Description: LOT 8, BLOCK 2 KING RAPID SUBD
Directions to Site: OFF END OF FUNNY RIVER ROAD ON SALMON RUN DR
Applicant Name, Address, and Telephone: RICK HOAG, Box 1173
SOLDOTNA, AK 99669 - WK - 262-4441 EXT. 270
Realtor and Firm: LEO. OBERTS, KENAI
Lending Institution: FIRST NAT. BANK ANCH. ALASKA DEPT.
Lot Owner: RICK HOAG General Contractor: MY SELF
Lot Size: 200' x 470' House Type: LOG 24' x 30' No. of Bedrooms: 2

SITE DATA

WELL

Well Driller: ART GILBERT AK-DRILLING Date: OCT. 1978
Depth: 90' Depth to Water: 85' Yield: 11 GPM Size Casing: 6"
(Attach Well Log if Available) Well type: DRILLED
Date Water Sample Taken: 8-8-79 Results: _____


DISPOSAL SYSTEM

Sewage Sys. Installer: MYSELF Date: SEPT 78
Sewer-Septic Tank Type: CONC. Size: 6' x 5'
Absorption Sys. Type: CRIB Size: 6' x 6' x 6'
Pipe Type: 4" ABS Size: 4"
Soils-General Profile: 1' TOP SOIL, 2' SAND, GRAVEL 1" SIZES

SKETCH

Include a site diagram to show the spatial relationship of the on-site water and sewer facilities to the property lines, house foundation, driveway, roads, adjacent property developments, etc. (Use other side if necessary)

SALMON RUN DRIVE

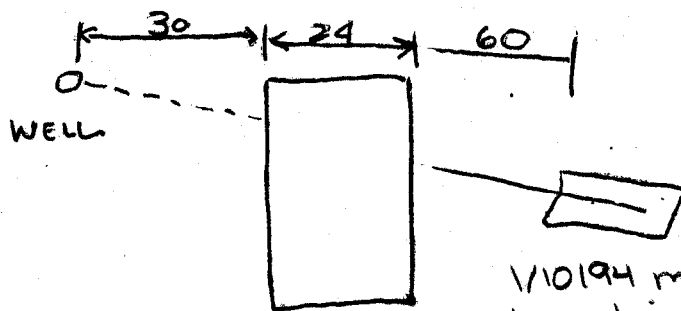

MR. FRANK CULLU

LOT 3 BLK. 1
king salmon sub

Funny River

10-28-84

1/10194 mb
Location
Questionable
Doh has ACAD

LOCAL NO. SB 5-8-20 ACBCI-5
SITE ID 603043/50430501