

STARISKI WELL DRILLING

P.O. BOX 722

HOMER, ALASKA 99603

235-6448

22959

WELL CONSTRUCTION LOG

Driller Coon Type of rig 22 W Date well completed SEP 17 95Well Owner Peter Debbie McKay Nearest community NikiskiWell location: (address & legal description) Lot 2 Block 1 Location sketch or remarks
Huhndorf Subdivision Chinook RdDepth of well 147 ft. Casing: length 147 ft. diam 6 in.Static water level 90 ft. (above below) land surface. Date: SEP 17 95Finish of well: (open-end, screen, perforated, open-hole, other) _____

Describe intervals and size: _____



Well yield tested by (pumping, bailing, air) at 10+ gal/min.for 1 hours with _____ ft. of drawdown from static level.

DRILLER'S MATERIAL LOG

Depth below land surface in feet	Give description of strata penetrated (size of material, color, hardness of drilling, and water content)
<u>0</u> to <u>107</u>	<u>Sand + Gravel</u>
<u>107</u> to <u>146</u>	<u>Clay</u>
<u>146</u> to <u>147</u>	<u>Sand + Gravel</u>
_____ to _____	_____
_____ to _____	_____
LOCAL NO. SB-11-150CCR
SITE ID _____

NK 11

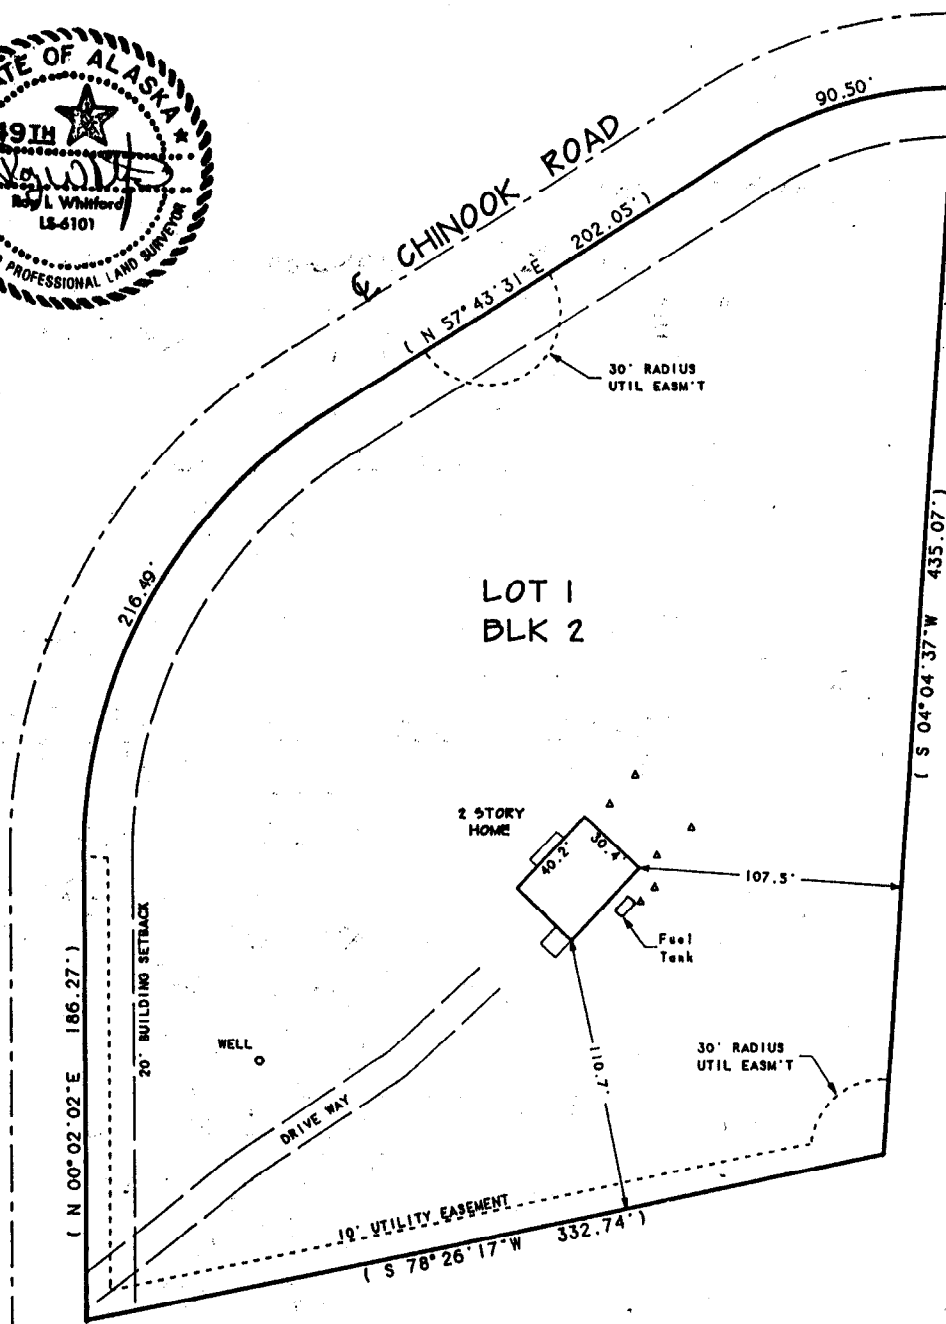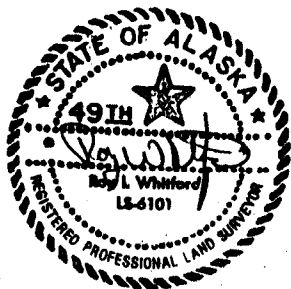

AS-BUILT SURVEY

I hereby certify that I have surveyed the following described property:

LOT 1, BLK TWO - HUHENDORF SUBD.

and that no encroachments exist except as indicated.

EXCLUSION NOTE: It is responsibility of the owner to determine the existence of any easements, covenants, or restrictions which do not appear on the recorded subdivision plat. Under no circumstances should any data hereon be used for construction or for establishing boundary or fence lines.

LEGEND

- Fnd. Mon.
- Fnd. Rebar
- Well
- △ Septic Vent
- () Record Data



SCALE
1" = 60'

Date: 9/29/95

Job No.: 95-1711

Revised: _____

WHITFORD SURVEYING
1902 Wyatt Way
Kenai, Alaska 99611

SB 8-11-15 DCB

NK 11