

\*Guide for Using the Hydrogeologic Classification System for Logging Water Well Boreholes by Thomas M. Hanna NGWA Press

COOK INLET DRILLING  
PO BOX 224  
ANCHOR PT., AK 99556  
235-8017 or 567-3907

LICENSE #AA20462


Driller: Gary Sonnichsen Type of Rig: Cable Tool Date Well Completed: 9/27/95  
Well Owner: Calm Construction/Chris Newby Nearest Community: Homer  
Well Location: Beinap Subdivision Diamond View Estates Unit 2 L 53  
Depth of Well: 46 ft. Casing: length 42 ft. diam 6 in. steel  
Static Water Level: 22 ft. below land surface.  
Finish of Well: open-hole  
Describe intervals and size: \_\_\_\_\_  
Well yield tested by pumping at 10 gal/min.  
Remarks: Use: Domestic Grouted: Bentonite Driveshoe: Yes

# DRILLER'S MATERIAL LOG

[illegible]

LOCAL NO. SC 6-14-4 DDDP

23197

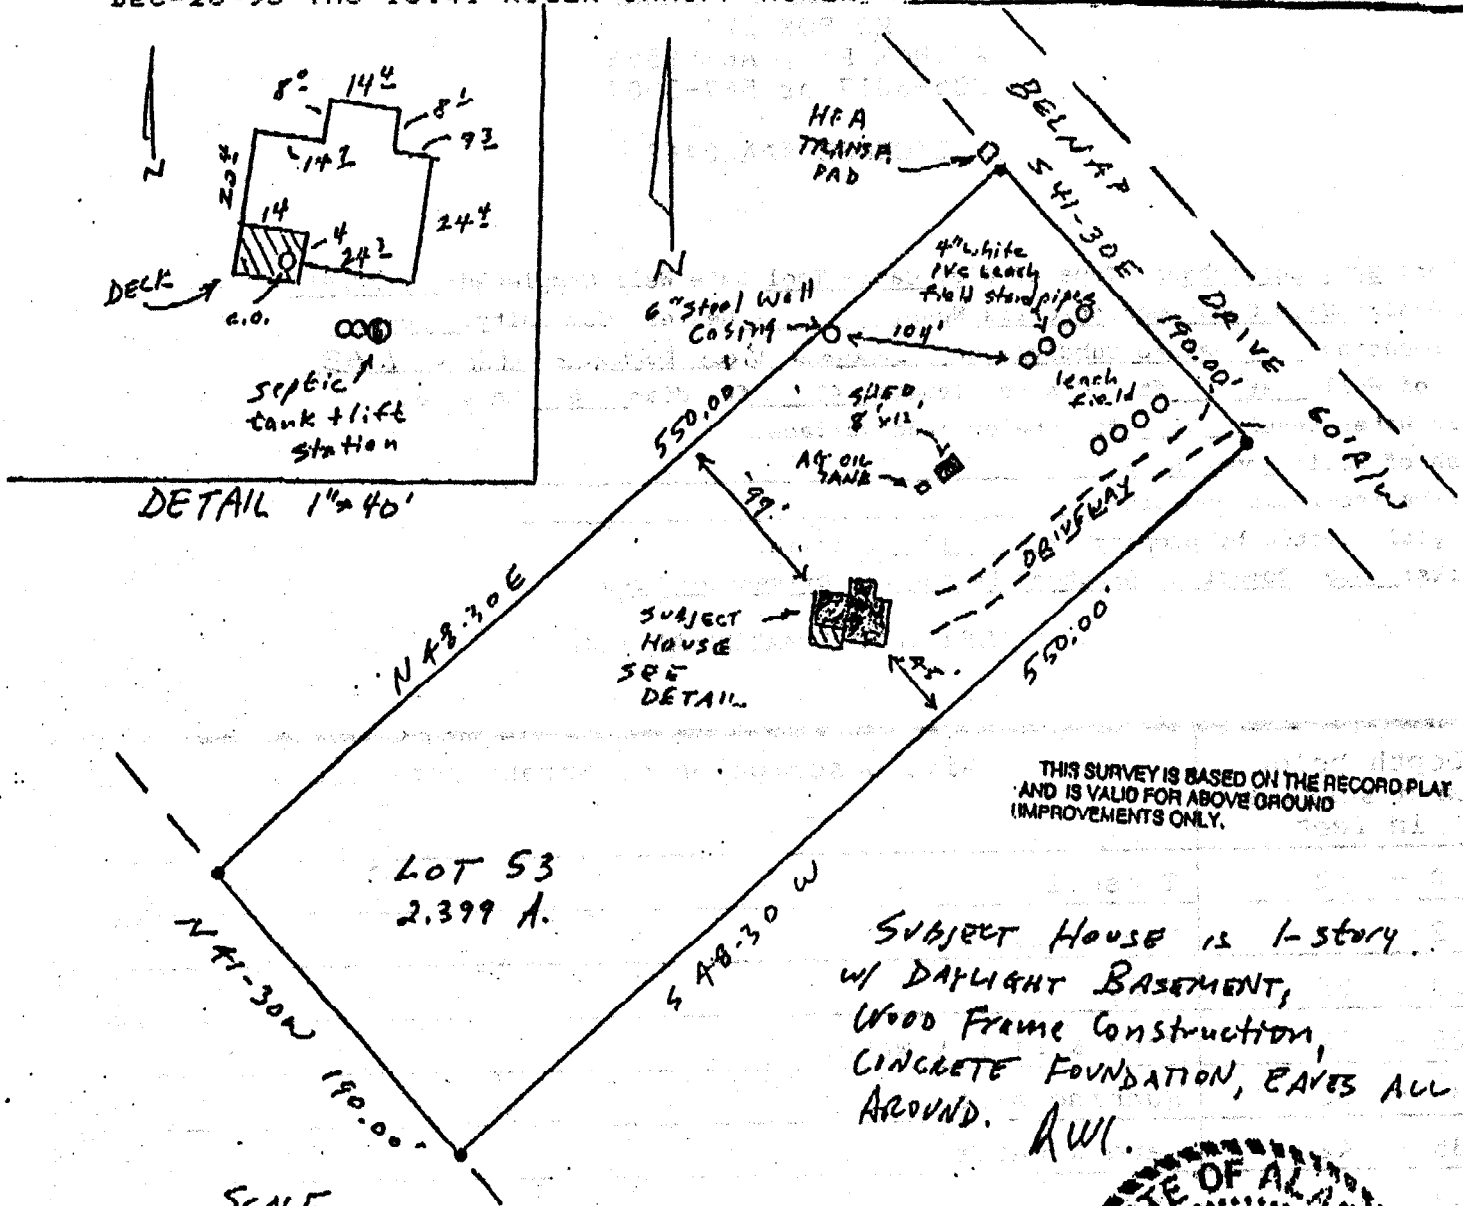

DETAIL 1"=40'

LOT 53  
2.399 A.

SCALE  
1"=100'

THIS SURVEY IS BASED ON THE RECORD PLAT  
AND IS VALID FOR ABOVE GROUND  
IMPROVEMENTS ONLY.

SUBJECT HOUSE IS 1-STORY  
W/ DAYLIGHT BASEMENT,  
WOOD FRAME CONSTRUCTION,  
CONCRETE FOUNDATION, EAVES ALL  
AROUND. A.W.I.

**ASBUILT SURVEY**

LOT 53 DIAMOND VIEW ESTATES  
UNIT 2

AS SHOWN ON PLAT 83-115 IIRD


LOCATED IN THE SE 1/4 SE 1/4  
S 4, T6S, R14W, SM  
HOMER RECORDING DISTRICT  
THIRD JUDICIAL DIST.  
ALASKA

CLIENT: CALM - NEWBY  
HOMER, ALASKA

SURVEYOR: ROGER IMHOFF  
POB 2588  
HOMER, AK 99603

DATE 12-28-95.

DRWN: RWI

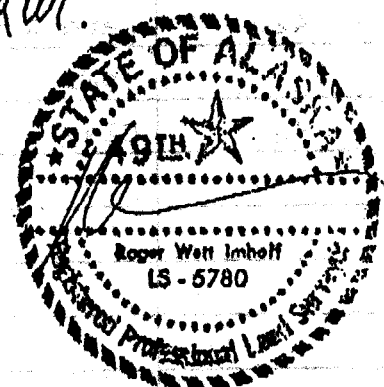

I HEREBY CERTIFY THAT I HAVE SURVEYED  
THE FOLLOWING PROPERTY AND THAT NO VISIBLE  
ENCROACHMENTS EXIST EXCEPT AS SHOWN:

LOT 53 DIAMOND VIEW ESTATES UNIT 2

EXCLUSION NOTE: IT IS THE RESPONSIBILITY  
OF THE OWNER TO DETERMINE THE EXISTENCE  
OF ANY EASEMENT, COVENANT OR RESTRICTION  
NOT SHOWN ON THE RECORDED SUBDIVISION  
PLAT. UNDER NO CIRCUMSTANCES SHOULD ANY  
DATA HEREON BE USED FOR CONSTRUCTION OR  
FOR ESTABLISHING THE LOCATION OF FENCE OR  
BOUNDARY LINES.

SC 6-14-4 000B