

*Guide for Using the Hydrogeologic Classification System for Logging Water Well Boreholes by Thomas M. Hanna NGWA Press


Darc
 ENTERPRISES

WELL DRILLING

Licensed Bonded Insured

(907) 283-4745

 404 BAKER STREET
 POST OFFICE BOX 158
 KENAI, ALASKA 99611-0158

July 31, 1995

1996 owner: Mida, Mike & Denise

 Denny Downs Construction
 10819 Spur Hwy Box 129
 Kenai, Ak. 99611

Dear Mr. Downs:

The following is the well log for the well drilled July 22, 1995, at Lot 9 Block 1 Diamond Willow Estates:

0 - 3	tundra and clay soil
3 - 10	silty sand
10 - 28	silty gravel
28 - 47	gravelly clay
47 - 69	silty sand
69 - 82' 2"	water in silty sand

set .012 screen at 82' 2"; surged and bailed 15 min.
 set 1/2hp Gould pump at 73-1/2'; pumped @ 15 gpm &
 in 5 minutes water was clean
 pumped 4 hours to test well
 water static: 58-1/2'
 pull down to 64' @ 15 gpm; instant recovery

Thank you for giving us this opportunity to be of service.

Yours truly,


Darc Enterprises

Caren Ann Bennett

RDB/cab

 LOCAL NO. SB 5-11-24 B D A A
 SITE ID _____
 KR19

Scale: 1" = 50'

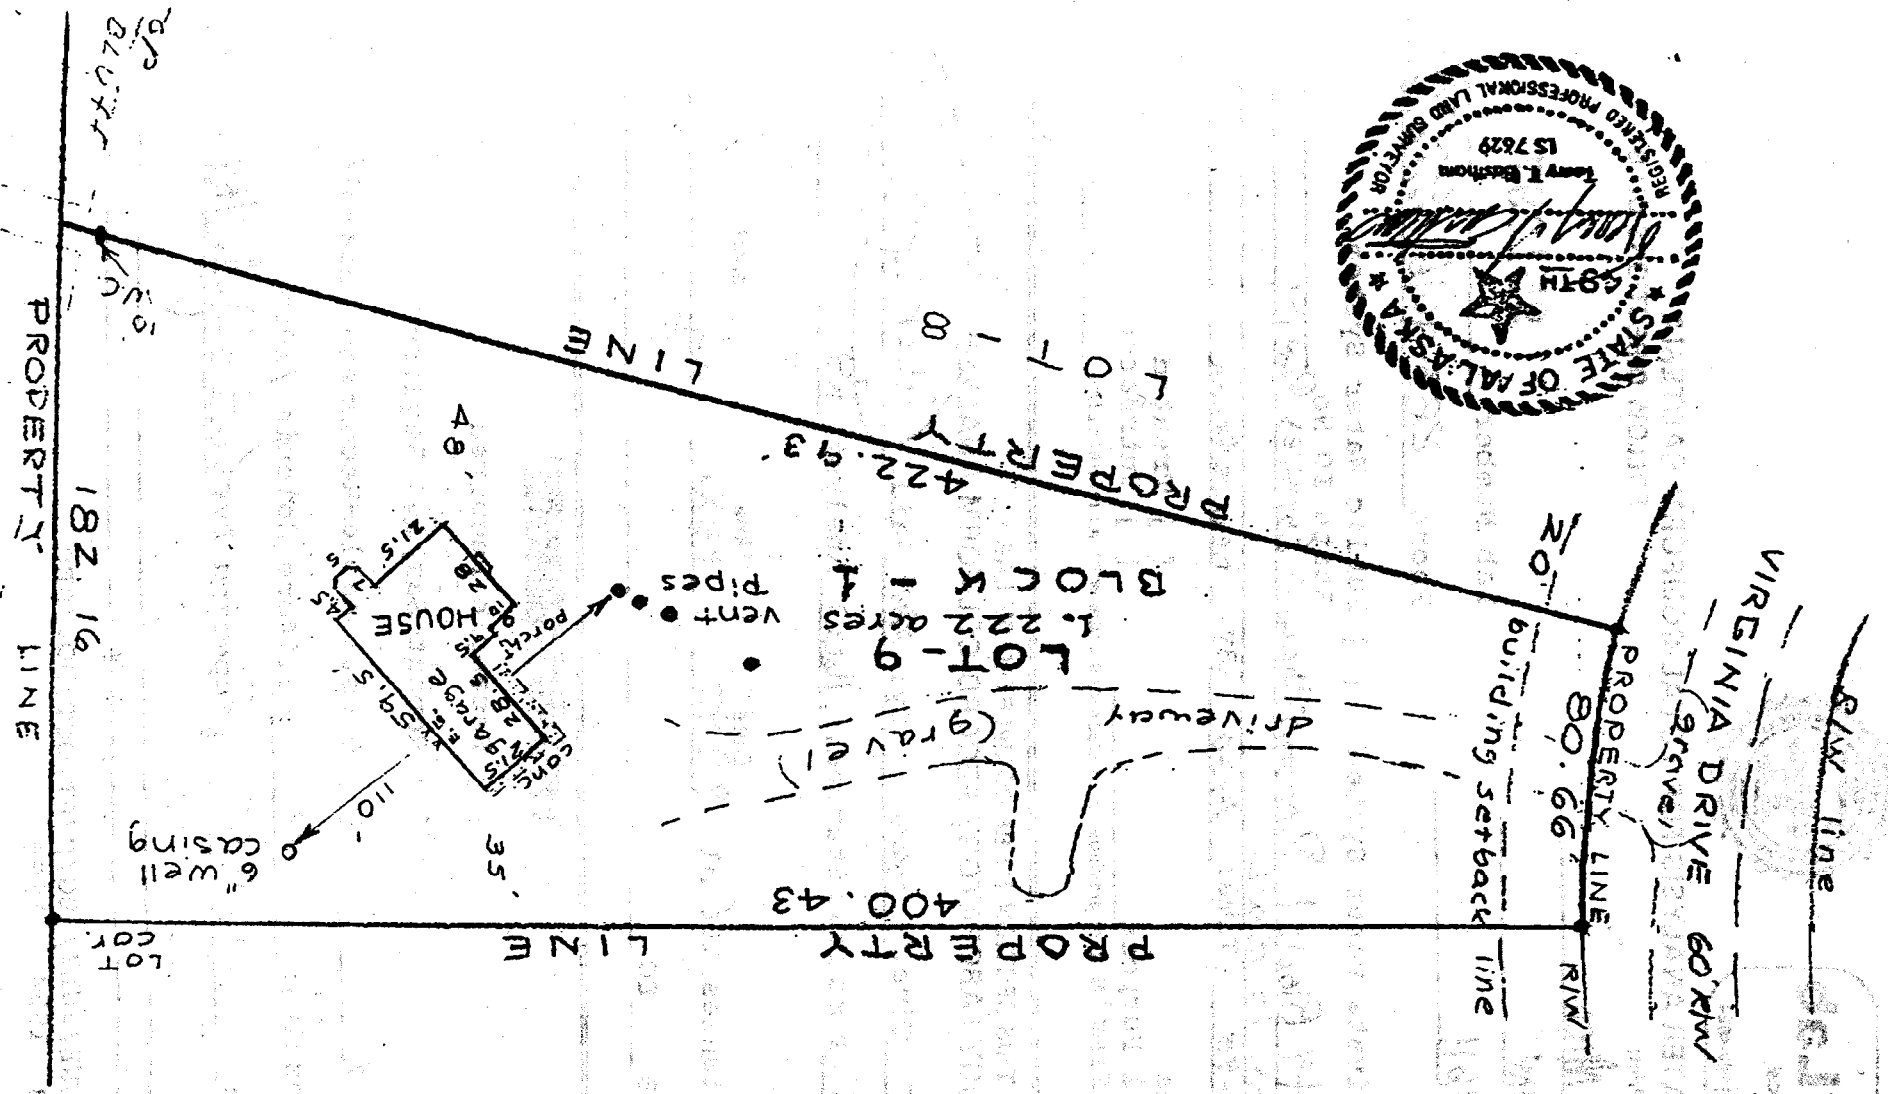

CERTIFICATION: I HEREBY CERTIFY THAT I HAVE SURVEYED THE LOCATION OF THE IMPROVEMENTS ON LOT-9 BLOCK-1 OF DIAMOND WILLOW ESTATES SUBDIVISION- PART ONE (PLAT NO. 75-68) KENAI RECORDING DISTRICT, AK.

1. SAID IMPROVEMENTS ARE WITHIN THE PROPERTY LINES AS SHOWN HEREON

2. NO IMPROVEMENTS ON THE ADJOINING PROPERTY ENCRACH ON LOT-9

3. NO ROADWAYS, TRANSMISSION LINES, OR OTHER VISIBLE EVIDENCE OF EASEMENTS CROSS LOT-9.

AS-BUILT SURVEY BY: TERRY EASTHAM PLS 7629
 PO BOX 2891, SOLDOTNA, AK 99669 Ph 262-1951

Jan, 14, 1996

585-11-24BDAA