



*Guide for Using the Hydrogeologic Classification System for Logging Water Well Boreholes by Thomas M. Hanna NGWA Press

IV. DIAGRAM OF SYSTEM(S) INSTRUCTIONS FOR DIAGRAM

- In a plan view, locate and identify each of the following:
 - Well
 - All Structures
 - Septic Tank
 - Soil Absorption System (Include dimensions)
 - Surface Water
 - Sources of contamination
 - Property Line
 - Closest septic tank on an adjacent property
 - Closest edge of an absorption field on adjacent property
 - All cleanouts and monitor tubes
- Show distances between the well and each of the other items listed in 1.
- Show distances between water bodies and each of the other items listed in 1.
- In a cross section view of the soil absorption area, identify each component and show the depth (thickness) of the following:
 - Soil Cover
 - Absorption Material
 - Water Table
 - Bedrock
 - Discharge pipes

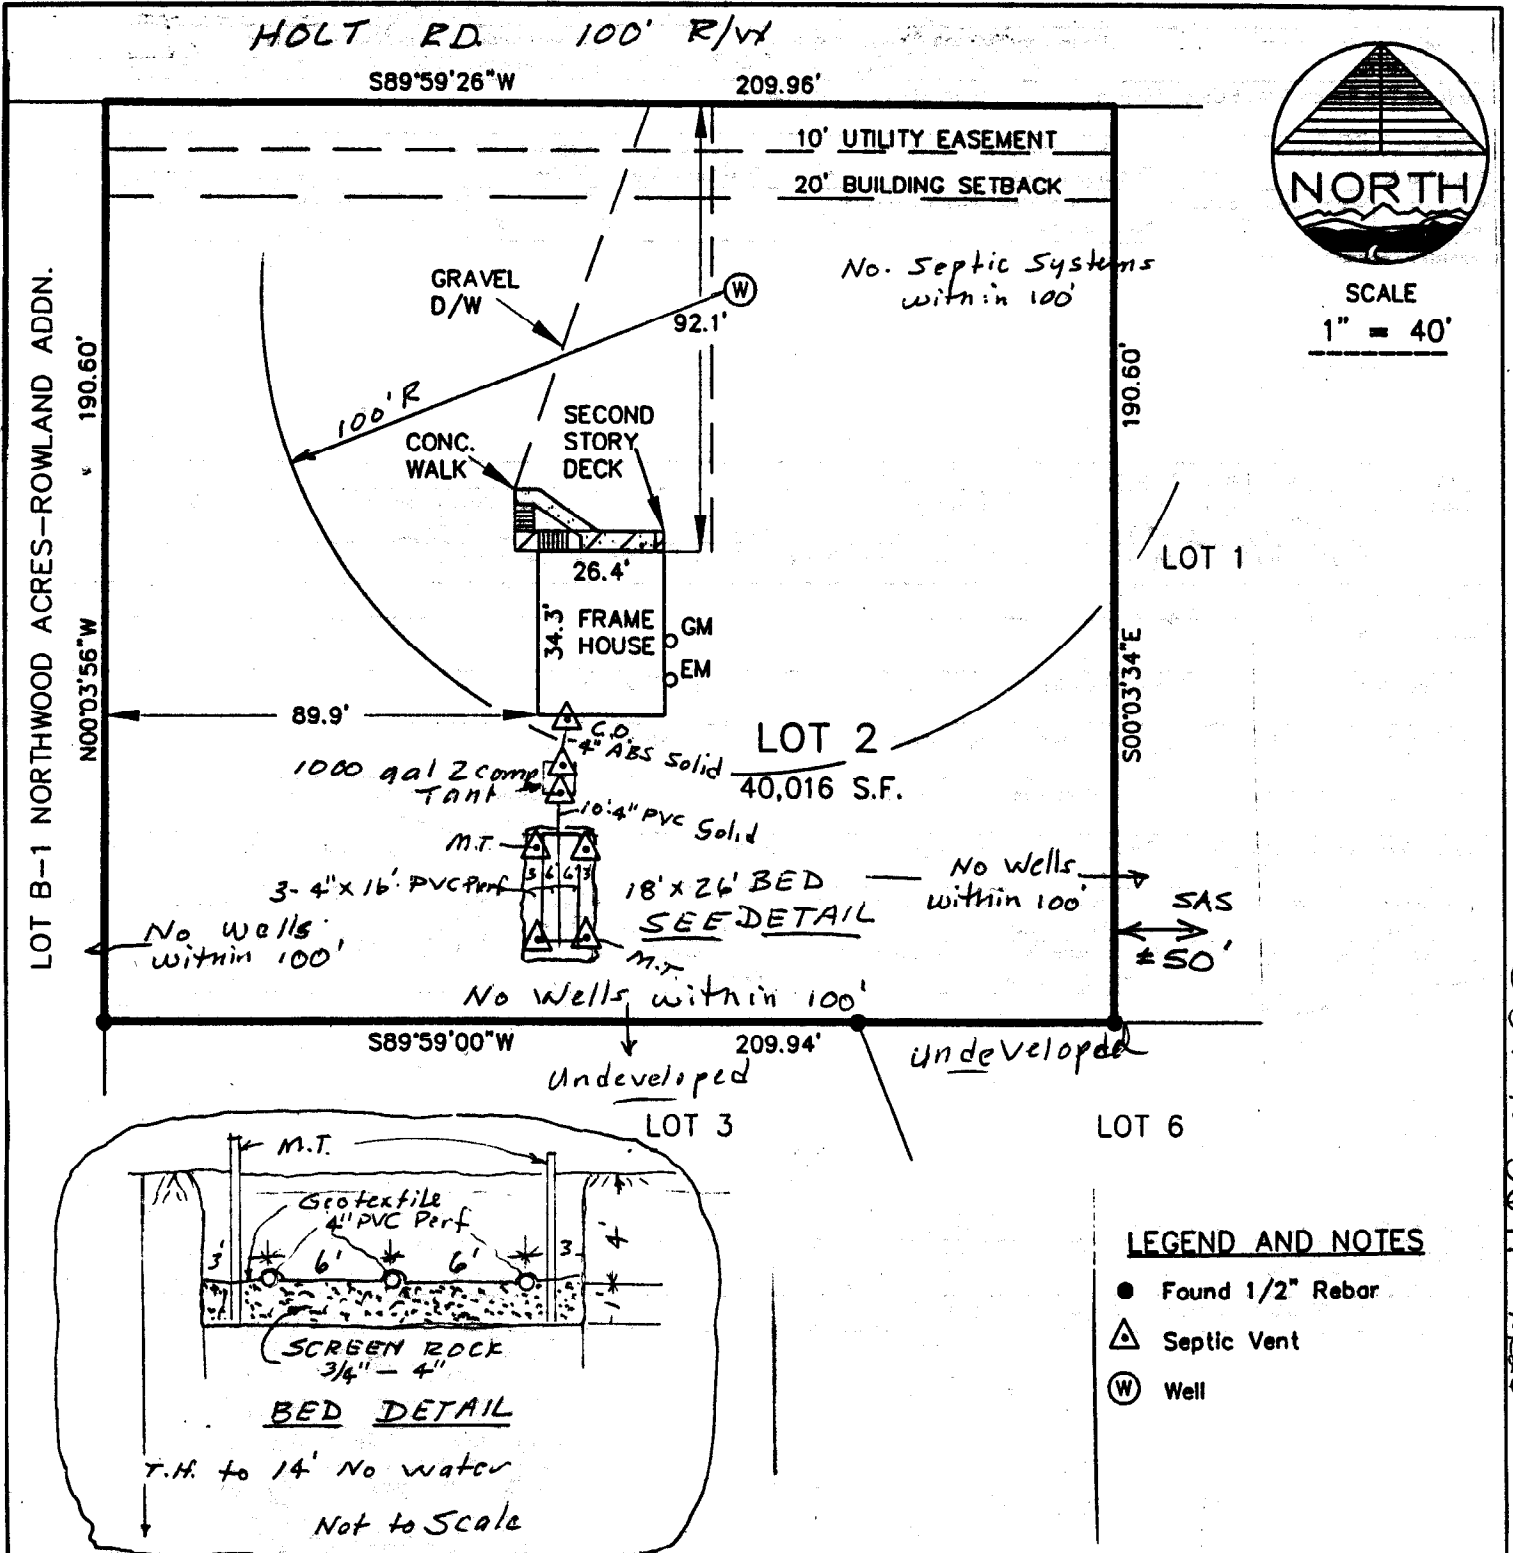

23480

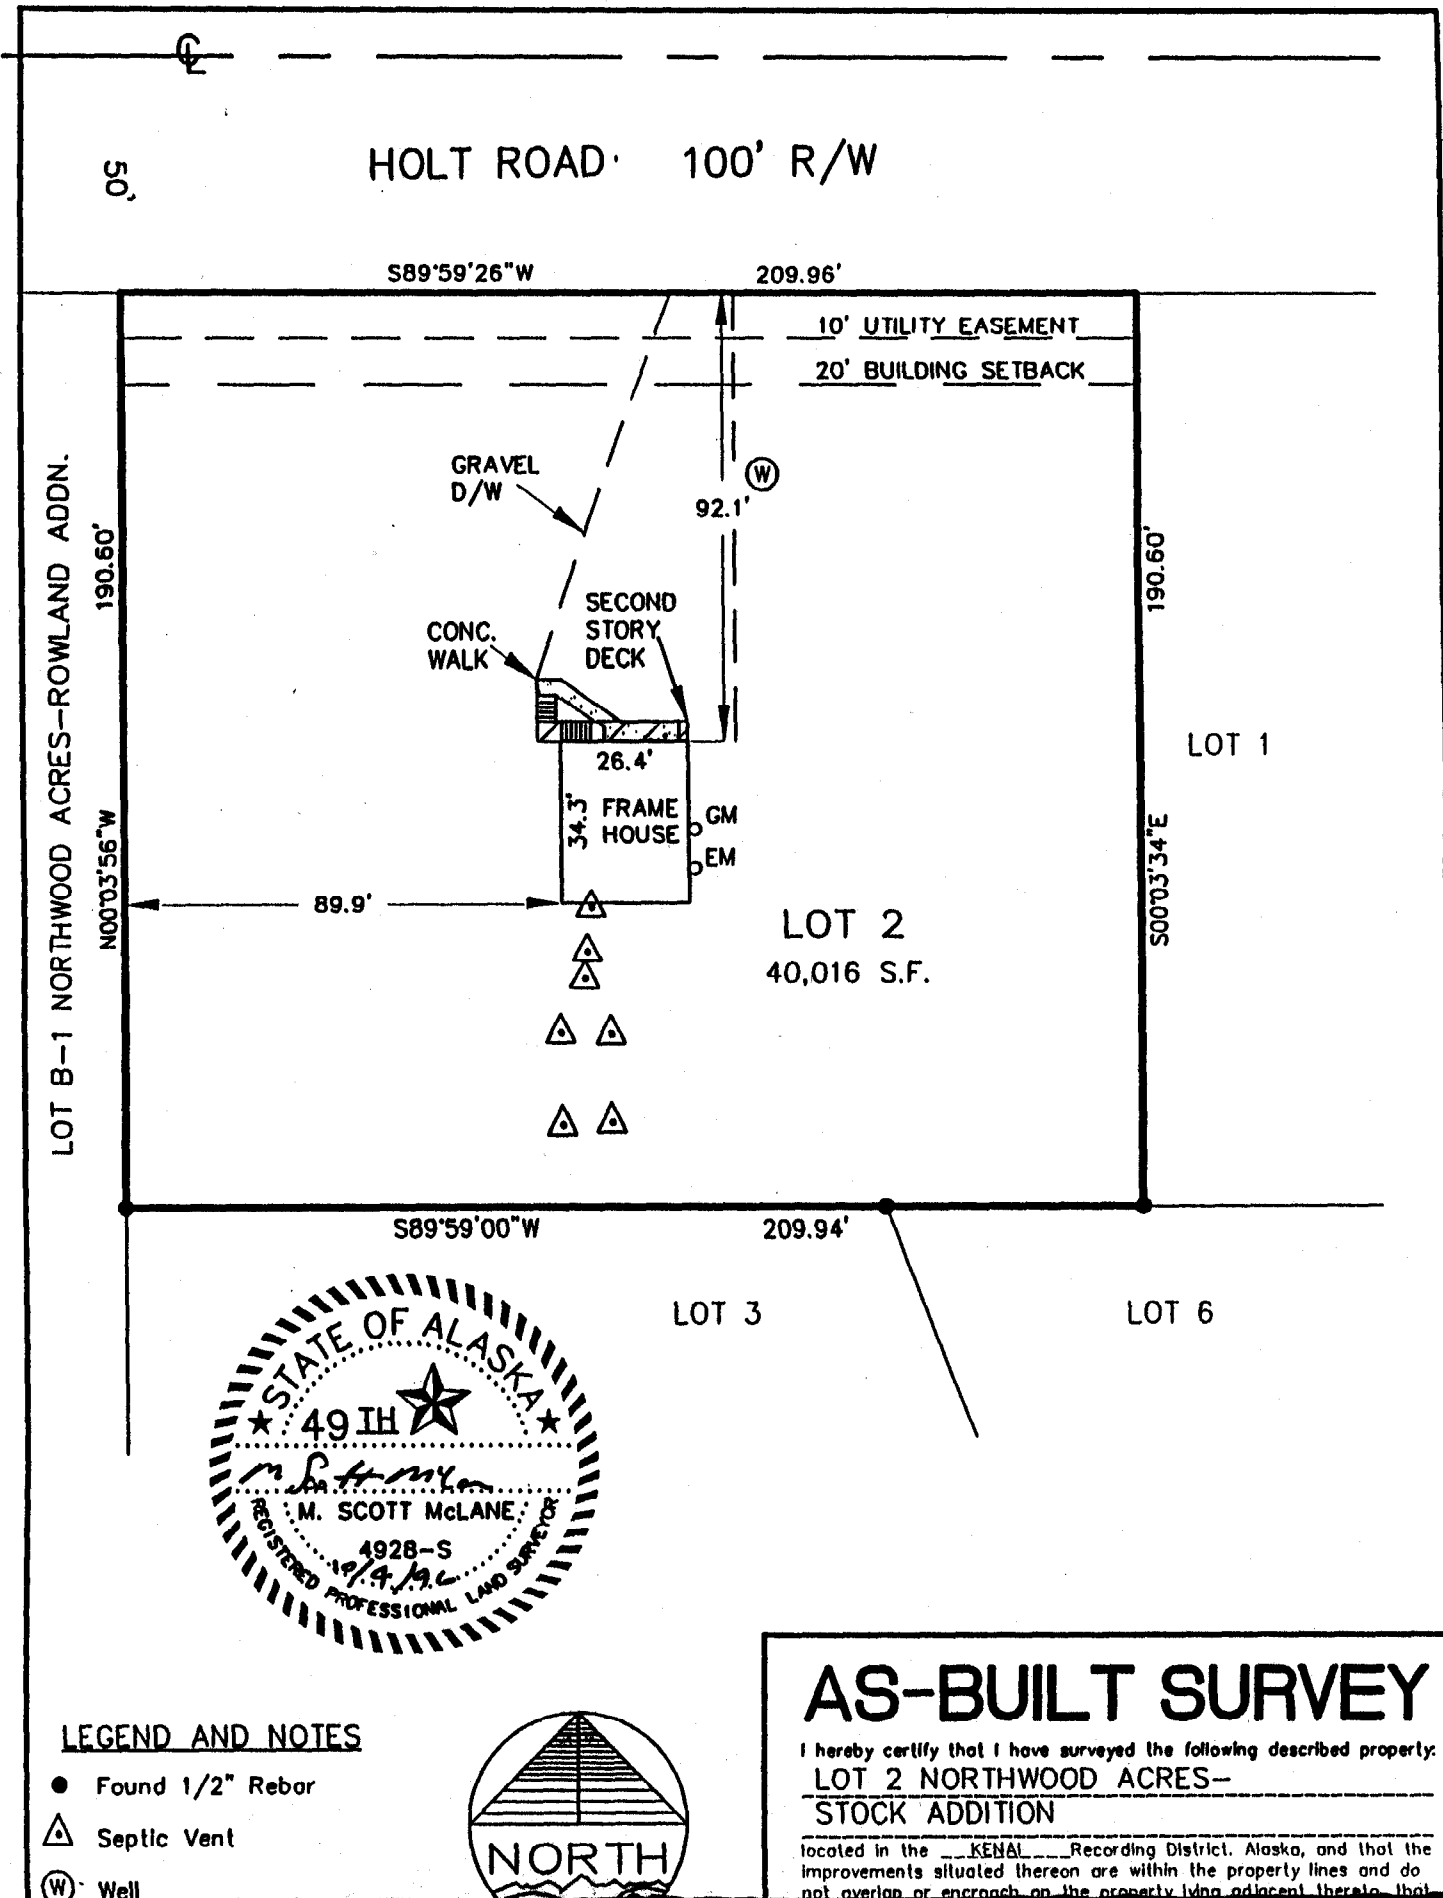

SB7-12-36A NK26