

*Guide for Using the Hydrogeologic Classification System for Logging Water Well Boreholes by Thomas M. Hanna NGWA Press

23481

SB 7-12-36 A

966096

23481

IV. DIAGRAM OF SYSTEM(S) INSTRUCTIONS FOR DIAGRAM

1. In a plan view, locate and identify each of the following:


- a) Well
- b) All Structures
- c) Septic Tank
- d) Soil Absorption System (Include dimensions)
- e) Surface Water
- f) Sources of contamination
- g) Property Line
- h) Closest well on adjacent property
- i) Closest septic tank on an adjacent property
- j) Closest edge of an absorption field on adjacent property
- k) All cleanouts and monitor tubes

2. Show distances between the well and each of the other items listed in 1.


3. Show distances between water bodies and each of the other items listed in 1.

4. In a cross section view of the soil absorption area, identify each component and show the depth (thickness) of the following:


- a) Soil Cover
- b) Absorption Material
- c) Water Table
- d) Bedrock
- e) Discharge pipes

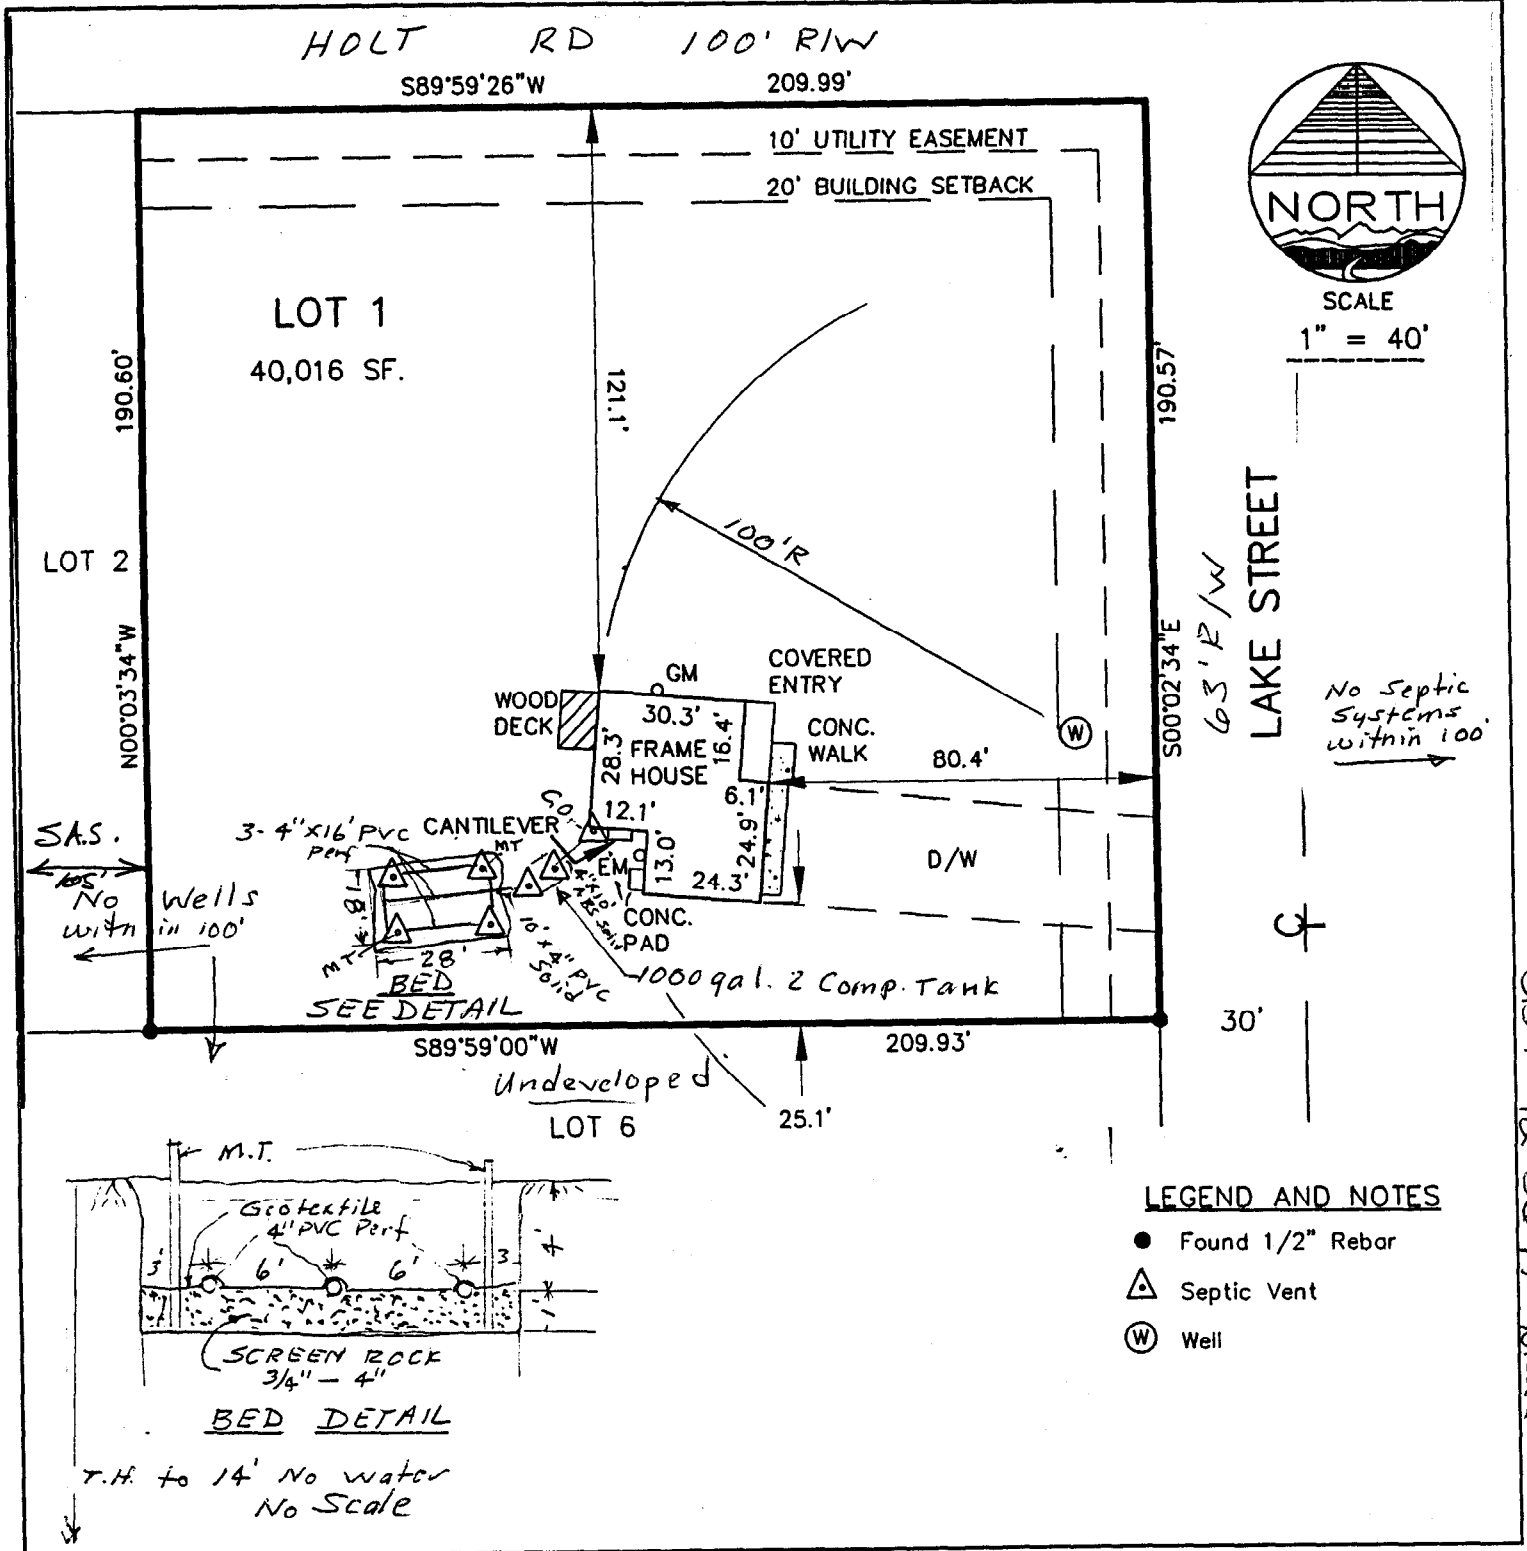

23481

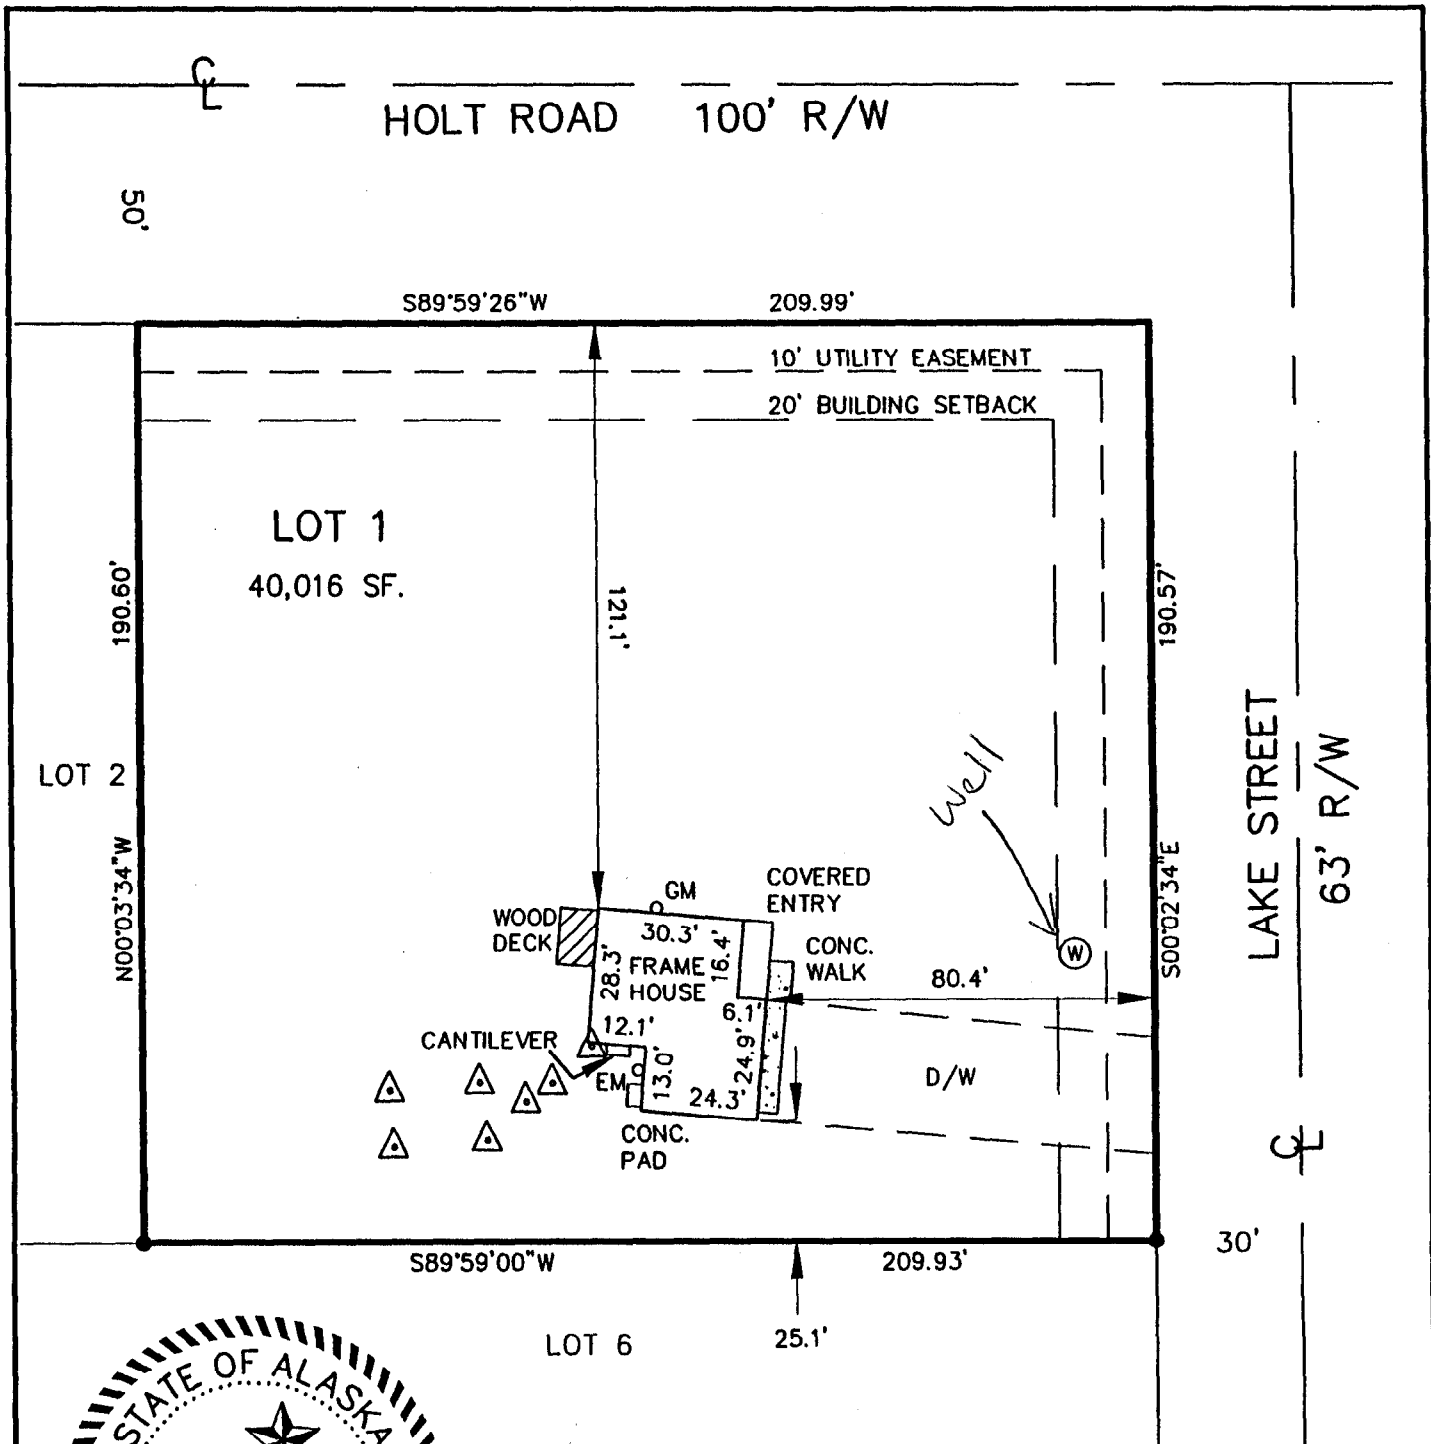

SB7-12-36 A
NK 26

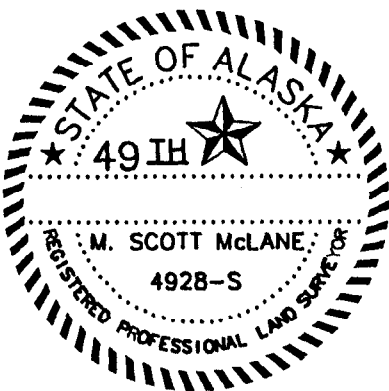

LEGEND AND NOTES

● Found 1/2" Rebar

△ Septic Vent



AS-BUILT SURVEY

I hereby certify that I have surveyed the following described property:
LOT 1 NORTHWOOD ACRES SUBDIVISION
STOCK ADDITION

located in the KENAI Recording District, Alaska, and that the improvements situated thereon are within the property lines and do