

WELL LOG

907-262-7580

8-15-96

LEVAH REV. BOROUGH

OWNER: KEITH PROBLEY

TRACT D PAULINE HANSON ESTATE 1990 ADDITION

DEPTH

[illegible]

Depth of Hole 98'
Depth of Casing 95'
Date of Completion 8-15-96

Method of Drilling

☒ Cable Tool ☐ air rotary
☐ other

Well Completion

☐ perforated ☐ open end
☒ liner ☐ screen ☐ open hole
 size 5 in length 7 ft slot $\frac{5}{32}$
☒ liner ☐ screen set to

static level 38' ft

full recovery 2 min.

Pump 5 Draw Down

Pump set _____

Drop Pipe ☐ galv. ~~2~~ poll

Remarks

Well log data developed from owners data.

SC2-13-16BBB

13-782	500 SHEETS, FILLER	5 SQUARE
42-381	50 SHEETS EYE-EASE	5 SQUARE
42-382	100 SHEETS EYE-EASE	5 SQUARE
42-389	200 SHEETS EYE-EASE	5 SQUARE
42-392	100 RECYCLED WHITE	5 SQUARE
42-399	200 RECYCLED WHITE	5 SQUARE

Made in U.S.A.



PAULINE HANSON ESTATES, 1990 ADDITION (HR Plat 90-27) TRACT D AS-BUILT SURVEY


Located in the NW1/4 Section 16, T2S R13W, SM, Nintchik, Alaska
Homer Recording District

Prepared For
Keith Presley
P.O. Box 39370
Nintchik, Ak 99639


Prepared by
Johnson Surveying
Box 27
Clam Gulch, Ak 99568



SCALE 1" = 50' AREA = 10259 acres 27 Nov. 1996

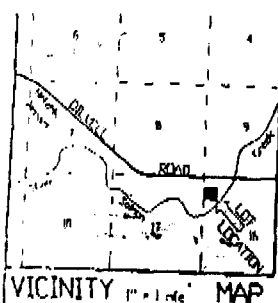

VICINITY 1" = 1 mile MAP

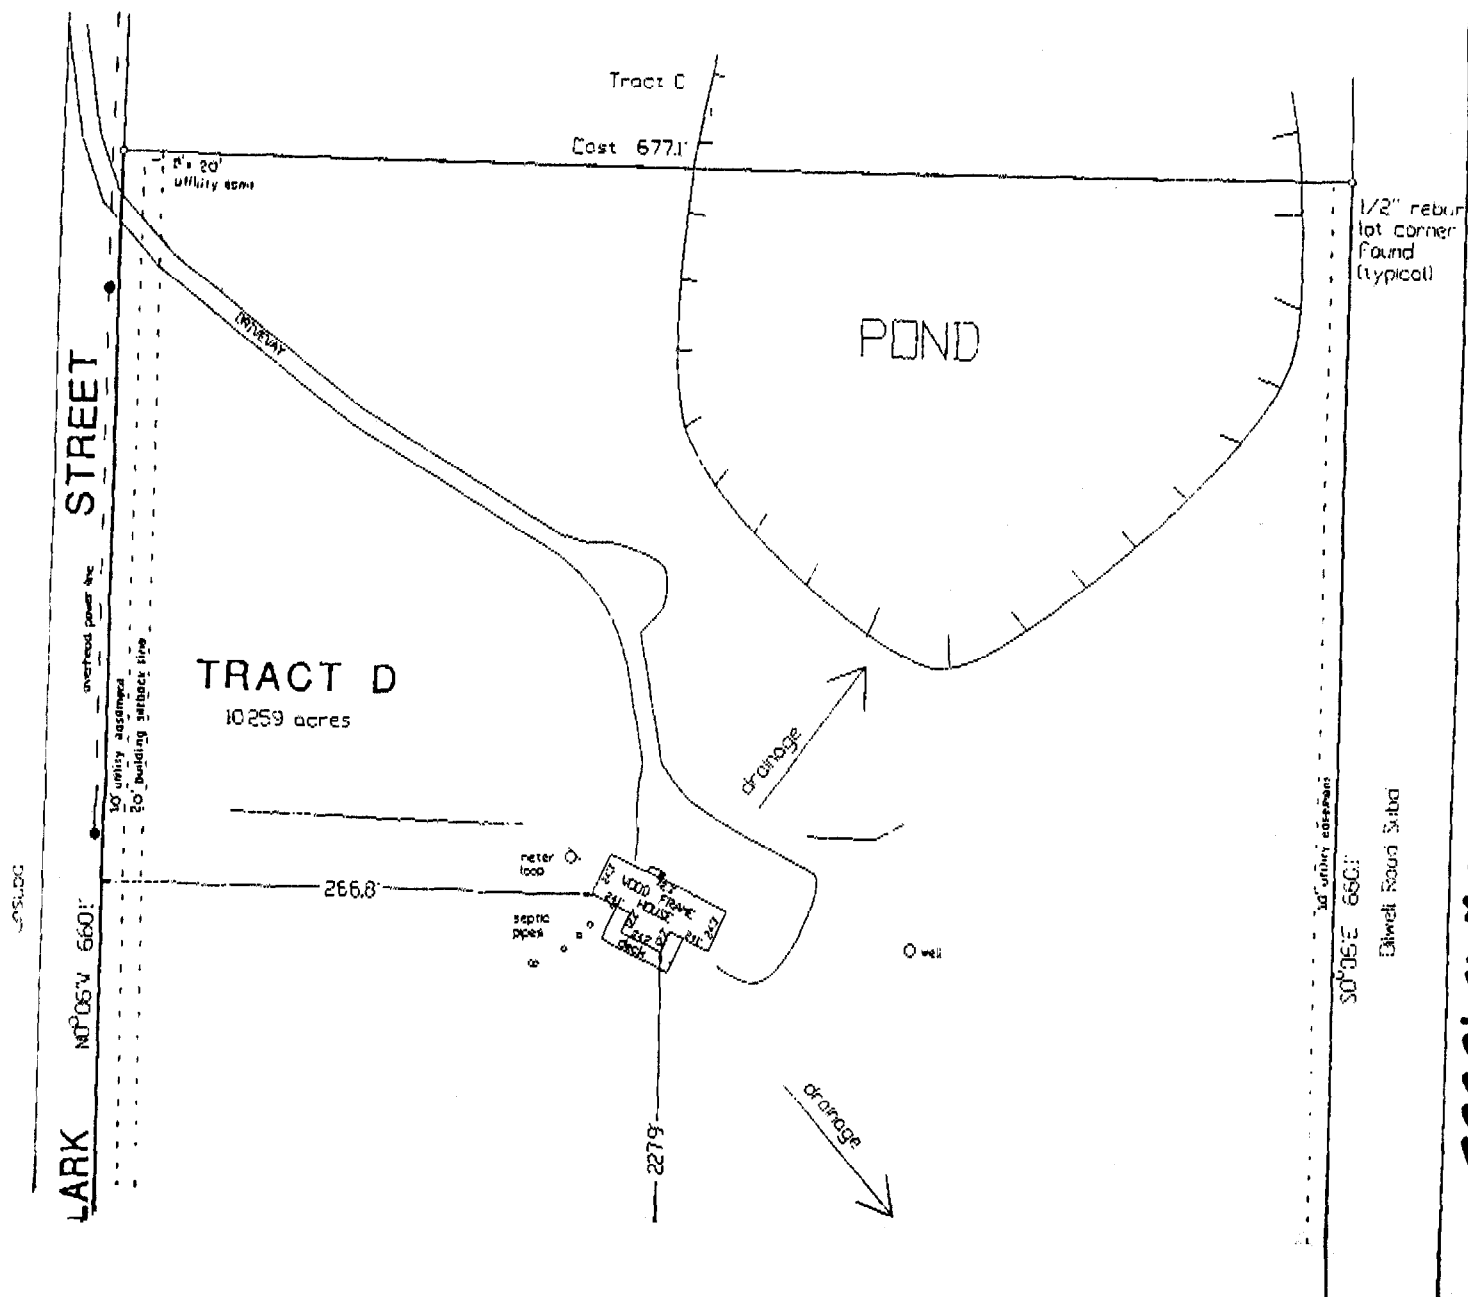

SC 2-12-16 BBB