

21A

SB 5-9-13 AACB

BILLY SPIRES

DRAKE DITMAN,

6-8-89

WELL LOG FOR WELL LOCATED ON LOT TWO BLOCK TWO MOOSE RIVER
ESTATES SUBDIVISION.

0'	--	10'	CLAY
10'	--	30'	SAND
30'	--	45'	SILT SAND AND GRAVEL
45'	--	60'	GRAVEL AND SAND
60'	--	79'	GRAVEL AND WATER

SET 6" CASING 75'

TYPE OF CASING 6" X .250 STEEL

NO SCREEN NEEDED, STATIC WATER 73'

1/2 HP. SUBMERSIBLE PUMP SET 40'

PUMPED WELL FOR FOUR HRS AT 10 GAL. PER MINUTE.

Billy Spires

SB 5-9-13 AACB

23712

STATE OF ALASKA


REGISTERED PROFESSIONAL LAND SURVEYOR

Terry T. Eastham

LS 7629

1. SAID IMPROVEMENTS ARE WITHIN THE PROPERTY LINES AS SHOWN HEREON.
2. NO IMPROVEMENTS ON THE ADJOINING PROPERTY ENCROACH ON LOT-2.
3. NO ROADWAYS, TRANSMISSION LINES OR OTHER VISIBLE EVIDENCE OF EASEMENTS CROSS LOT -2.

AS-BUILT SURVEY BY: TERRY T EASTHAM RLS 7629
AUGUST 5, 1997 PO BOX 2891, SOLDOTNA, AK.
262-1951

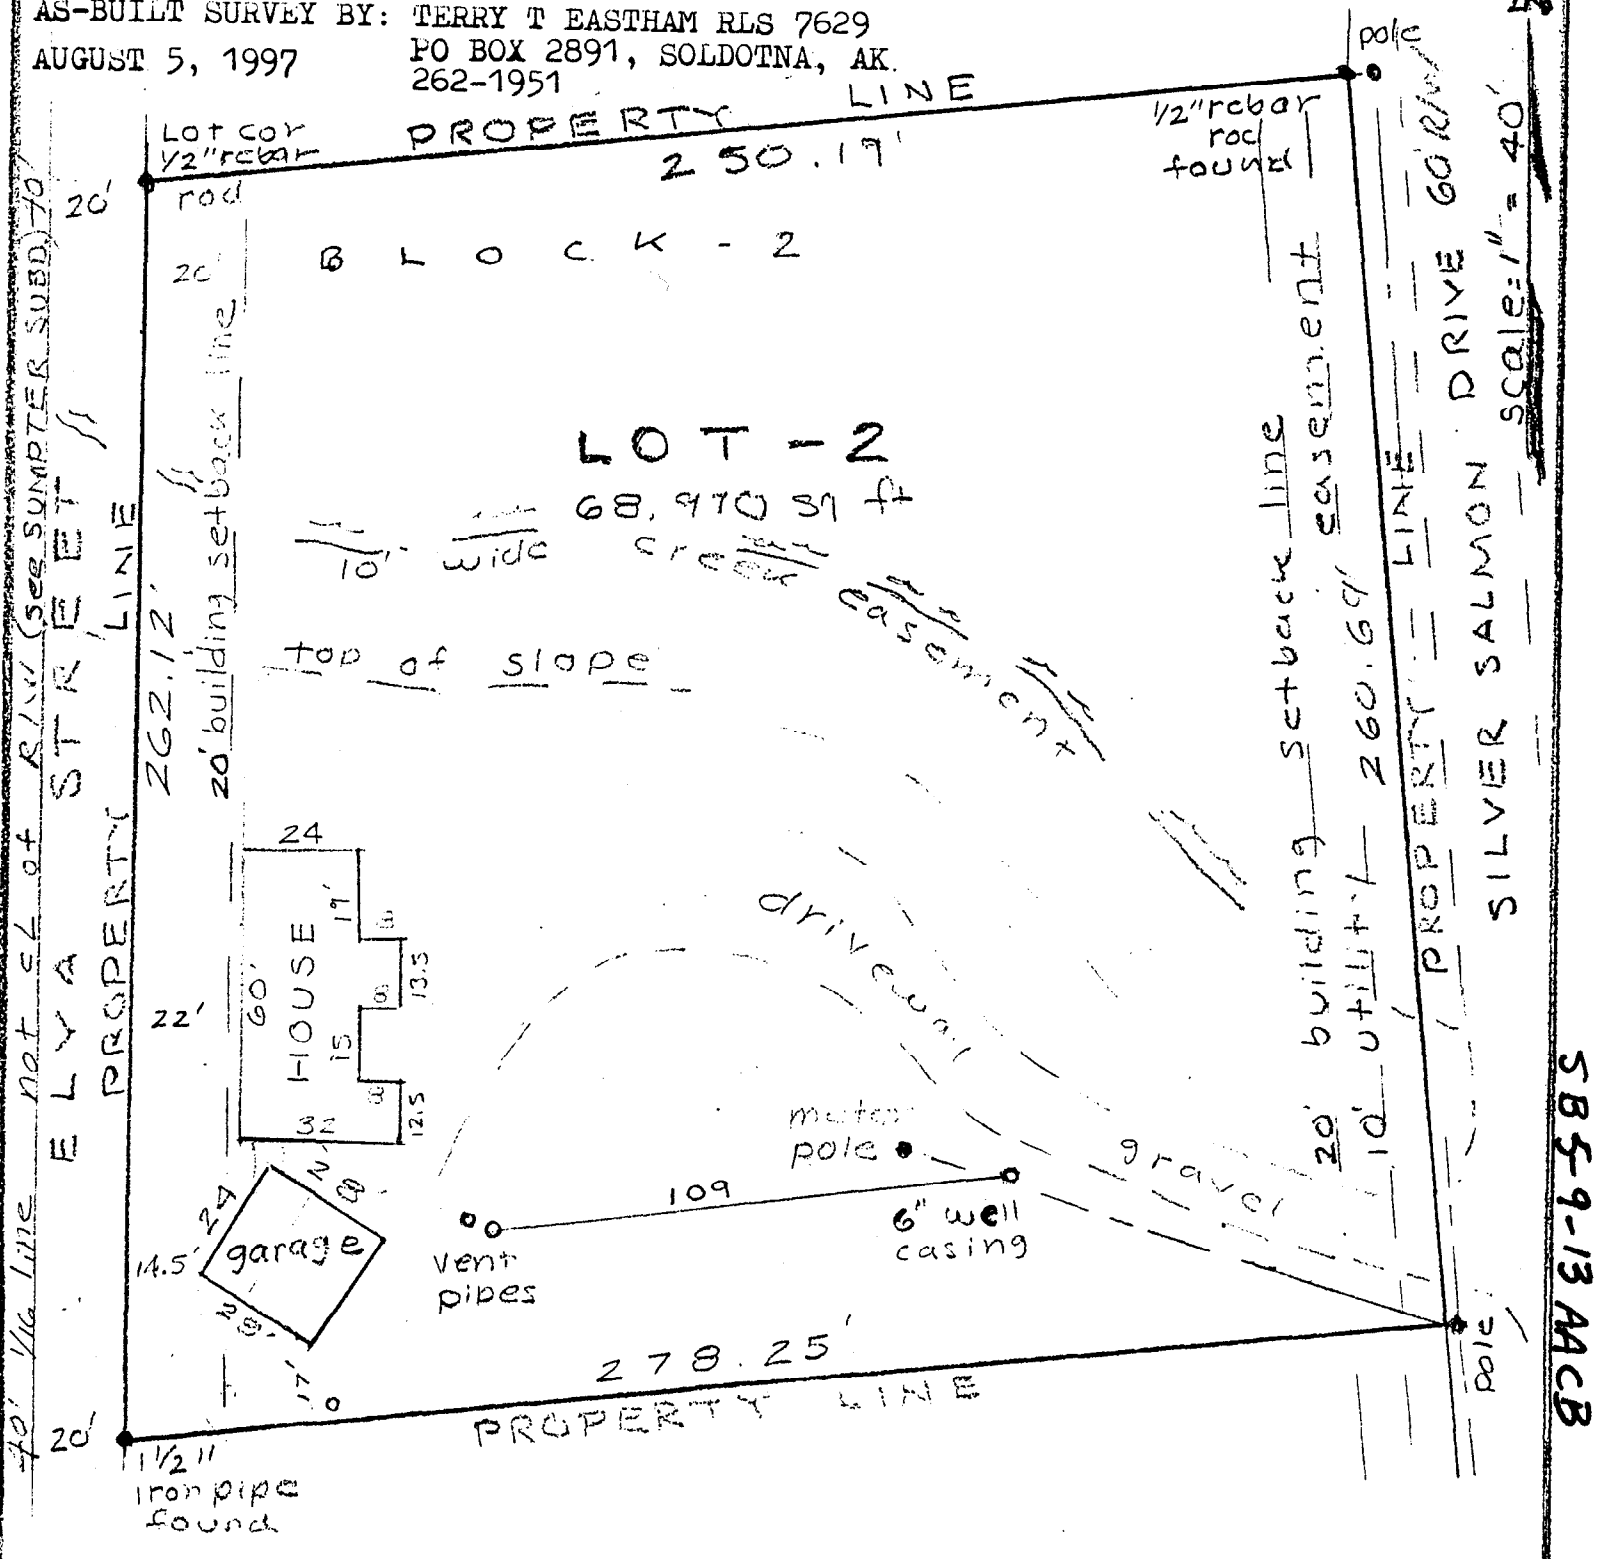

5B5-9-13 AACB