

*Guide for Using the Hydrogeologic Classification System for Logging Water Well Boreholes by Thomas M. Hanna NGWA Press

24109

WE SERVE

JAY WILLIAMS DRILLING CO.

P.O. BOX 874747 - WASILLA, ALASKA 99687

LOCAL NO. SA 17-1-8BA0A

ALL ALASKA

WASILLA, AK
376-3199

CHUGIAK, AK
688-3199

OWNER OF LAND Violet Aldridge
ADDRESS P.O. Box 876483 Wasilla Ak. 99687
WELL - SITE Lot 1 Blk. 6 Brentwood Subd.
DATE - STARTED 6-30-97
DATE - ENDED 7-2-97

DEPTH OF WELL 88 ft.
STATIC LEVEL OF WATER FT. 46 ft
DRAW DOWN FT. 84 ft.
GALS. PER HR. 1200 Visual Estimate
KIND OF CASING 88 ft. 6 in. A-53 B A.S.T.M.

KIND OF FORMATION:


FROM 0 FT. TO 2 FT. Stub Up
FROM 2 FT. TO 3 FT. Overburden
FROM 3 FT. TO 17 FT. Gravel & Sand
FROM 17 FT. TO 29 FT. Brown Sand
FROM 29 FT. TO 51 FT. Gravel
FROM 51 FT. TO 77 FT. Silty Gravel
FROM 77 FT. TO 88 FT. Water Gravel
FROM FT. TO FT.
FROM FT. TO FT.
MISCL. INFORMATION: No warranty or no warranties implied

DRILLER'S NAME Jay Williams

24109

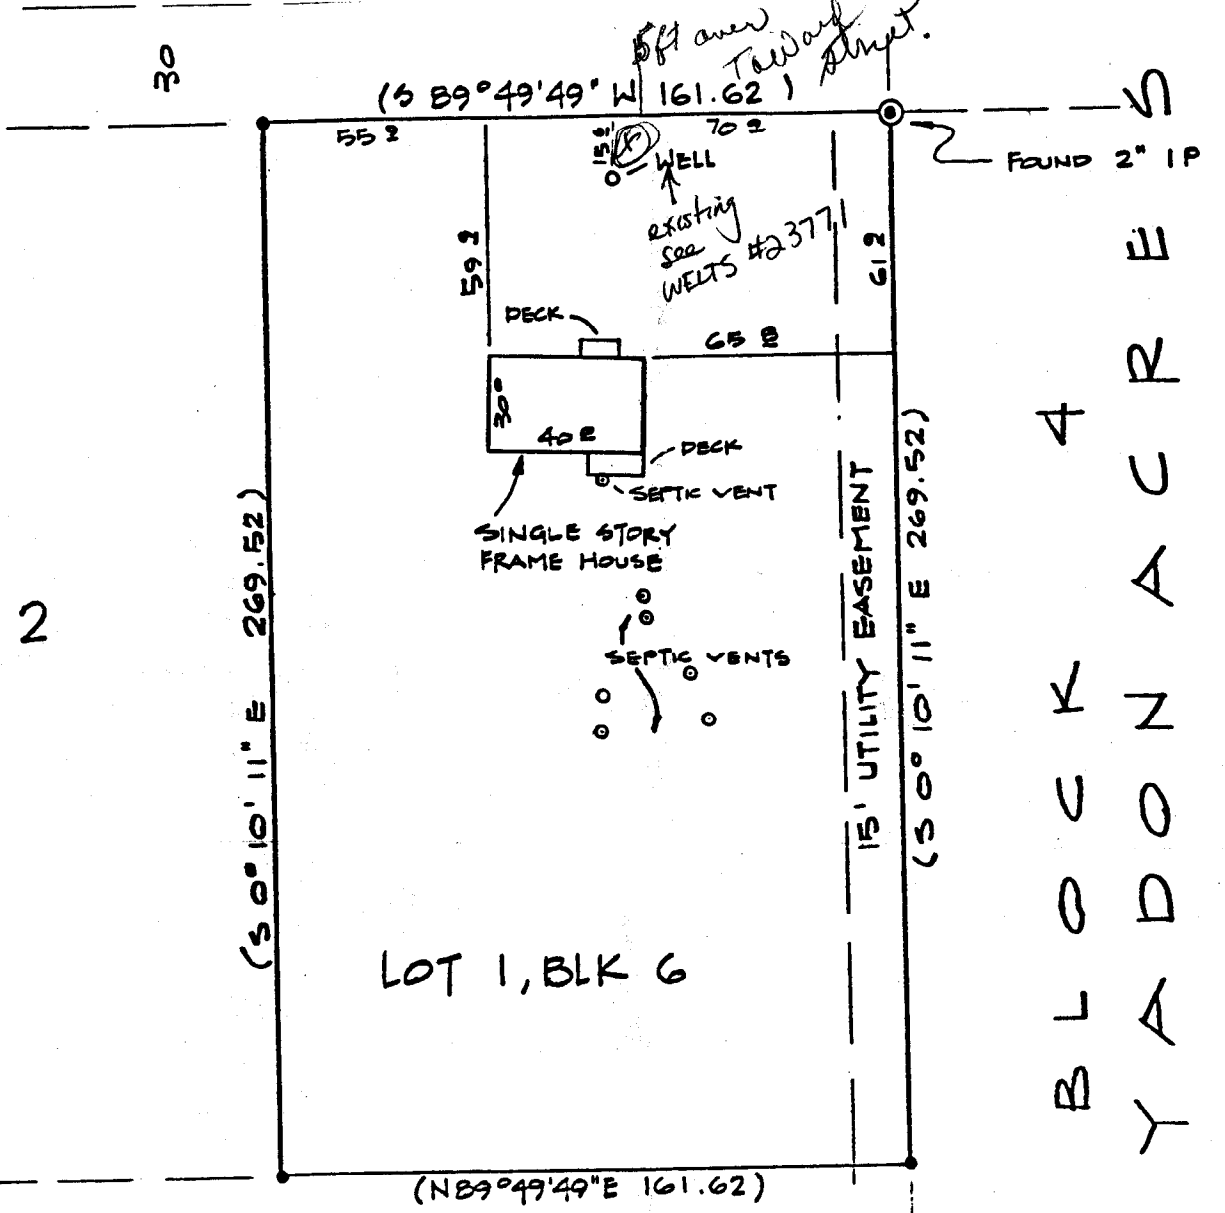

W
R
C
A
B
Y
Z
O
D
A
Y

SA 17-1-8BADA

LEGEND

- PD 5/B REBAR
- () RECORD DATA

JOB NO.: W6590
 ZONED :
 FIELD BOOK: 17
 CLIENT: RYAN & SONS

SCALE: 1" = 50'	PLOT PLAN:	AS-BUILT: X	MAP:	DRAWN BY: BR	CHECKED BY: [Signature]
-----------------	------------	-------------	------	--------------	-------------------------

S&S ENGINEERS, INC. P.O. BOX 873447. WASILLA, ALASKA 99687

I HEREBY CERTIFY THAT THE IMPROVEMENTS SITUATED ON LOT 1, BLOCK 6, BRENTWOOD SUB. PALMER RECORDING DISTRICT, AK. ARE WITHIN THE PROPERTY LINES AND DONOT ENCROACH ON THE PROPERTY LYING ADJACENT THERETO, THAT NO IMPROVEMENTS ON PROPERTY LYING ADJACENT THERETO ENCROACH ON THE PREMISES IN QUESTION AND THAT THERE ARE NO ROADWAYS, TRANSMISSION LINES OR OTHER VISIBLE EASEMENTS ON SAID PROPERTY EXCEPT AS INDICATED HEREON.

DATED THIS 27th DAY OF AUGUST, 1984 WASILLA, ALASKA.

IT IS THE RESPONSIBILITY OF THE OWNER OR BUILDER PRIOR TO CONSTRUCTION TO VERIFY PROPERTY LINES AND PROPOSED BUILDING GRADE RELATIVE TO FINISH GRADE AND UTILITY CONNECTIONS AND TO DETERMINE THE EXISTENCE OF ANY

