

MAT-SU

PLUMBING & HEATING

Wasilla: 376-3379

Anchorage: 272-6200

Date 5/19/81

Lot 15, Blk 3 Finger Cove Estates Subd.


NE SE SE SE Sec. 33
T18N, R1E, S1M
N08 - W03

INVOICE 02687

5272

Service Check and Parts	OK	BAD	Price	STARTING DATE <u>5/19/81</u>	STARTING TIME <u>ASAP</u>	WORK ORDERED BY <u>Diane</u>	ORDER TAKEN BY <u>Mark</u>
Pressure Relief Valve				BILL TO:		JOB ADDRESS:	
Expansion or Filter Tank				NAME		NAME <u>Lee Post</u>	
12 Lb Reducing Valve				STREET		STREET <u>Old Palmer wasilla rd</u>	
Aquastat				CITY		CITY <u>wasilla</u>	
Dialectric Unions				PHONE		PHONE <u>745-5264</u>	
Circ Pump				NEAREST INTERSECTION		NEAREST INTERSECTION	
Zone Valves							
Boiler Drains				PLUMBER <u>Mark, Randy</u>	TIME STARTED <u>10:40</u>	TIME COMPLETED <u>4:40</u>	CHARGE ☒ CK ☐ DISH ☐ MC ☐ VISA
Thermalcoupler				Labor is to be done on an hourly rate of <u>40</u> per hour with 1 hour minimum service call and 1/2 hour minimum thereafter. Parts, material and equipment used on job are extra. One year guarantee on parts and labor.			
Autovent				WORK TO BE DONE: <u>Well Repair</u>			
Temperature & Pressure Gauge				<u>orig owner: Bronnen, Todd/Lisa</u>			
Venting				<u>Drilled about 1978, no well log made</u>			
Gas Valve				WORK AUTHORIZED BY: <u>X</u> <u>driller unknown slope worker</u>			
Blower Motor				MAKE OF UNIT: <u>according to Mr Post (OEM: PMS)</u>			
Burner Motor							
Limit Switches				COMMENTS: <u>Pulled pump and found it</u>			
Oil Pump				<u>to be frozen mechanically due to</u>			
Transformer				<u>pass silt or misalignment. Replaced</u>			
Primary Control				<u>pump & wire. pump is guaranteed</u>			
Nozzel				<u>Except for damage done because of</u>			
Filters				<u>siltiness or well going dry.</u>			
Other:				<u>depth 74' pump depth 67'</u>			
Pump			370 50	Water depth <u>14.6"</u>			
wire			176 25				
Splice Kit			9 95	EQUIPMENT RENTAL			
Tape			2 50	MATERIALS			
Pipe dope			1 25	LABOR hours <u>11</u>			
				EQUIPMENT <u>Pipe Threader</u>			
				PERMITS			
				PAID BY <u>CK # 2675</u>			
				TOTAL AMOUNT			
				I hereby acknowledge the satisfactory completion of the above work and billing and agree to pay any fees incurred to collect payment in full.			
				Signature <u>X</u> <u>Diane B. Post</u>			
			TOTAL				

5818-1-83 0600 1-19
613605149160401

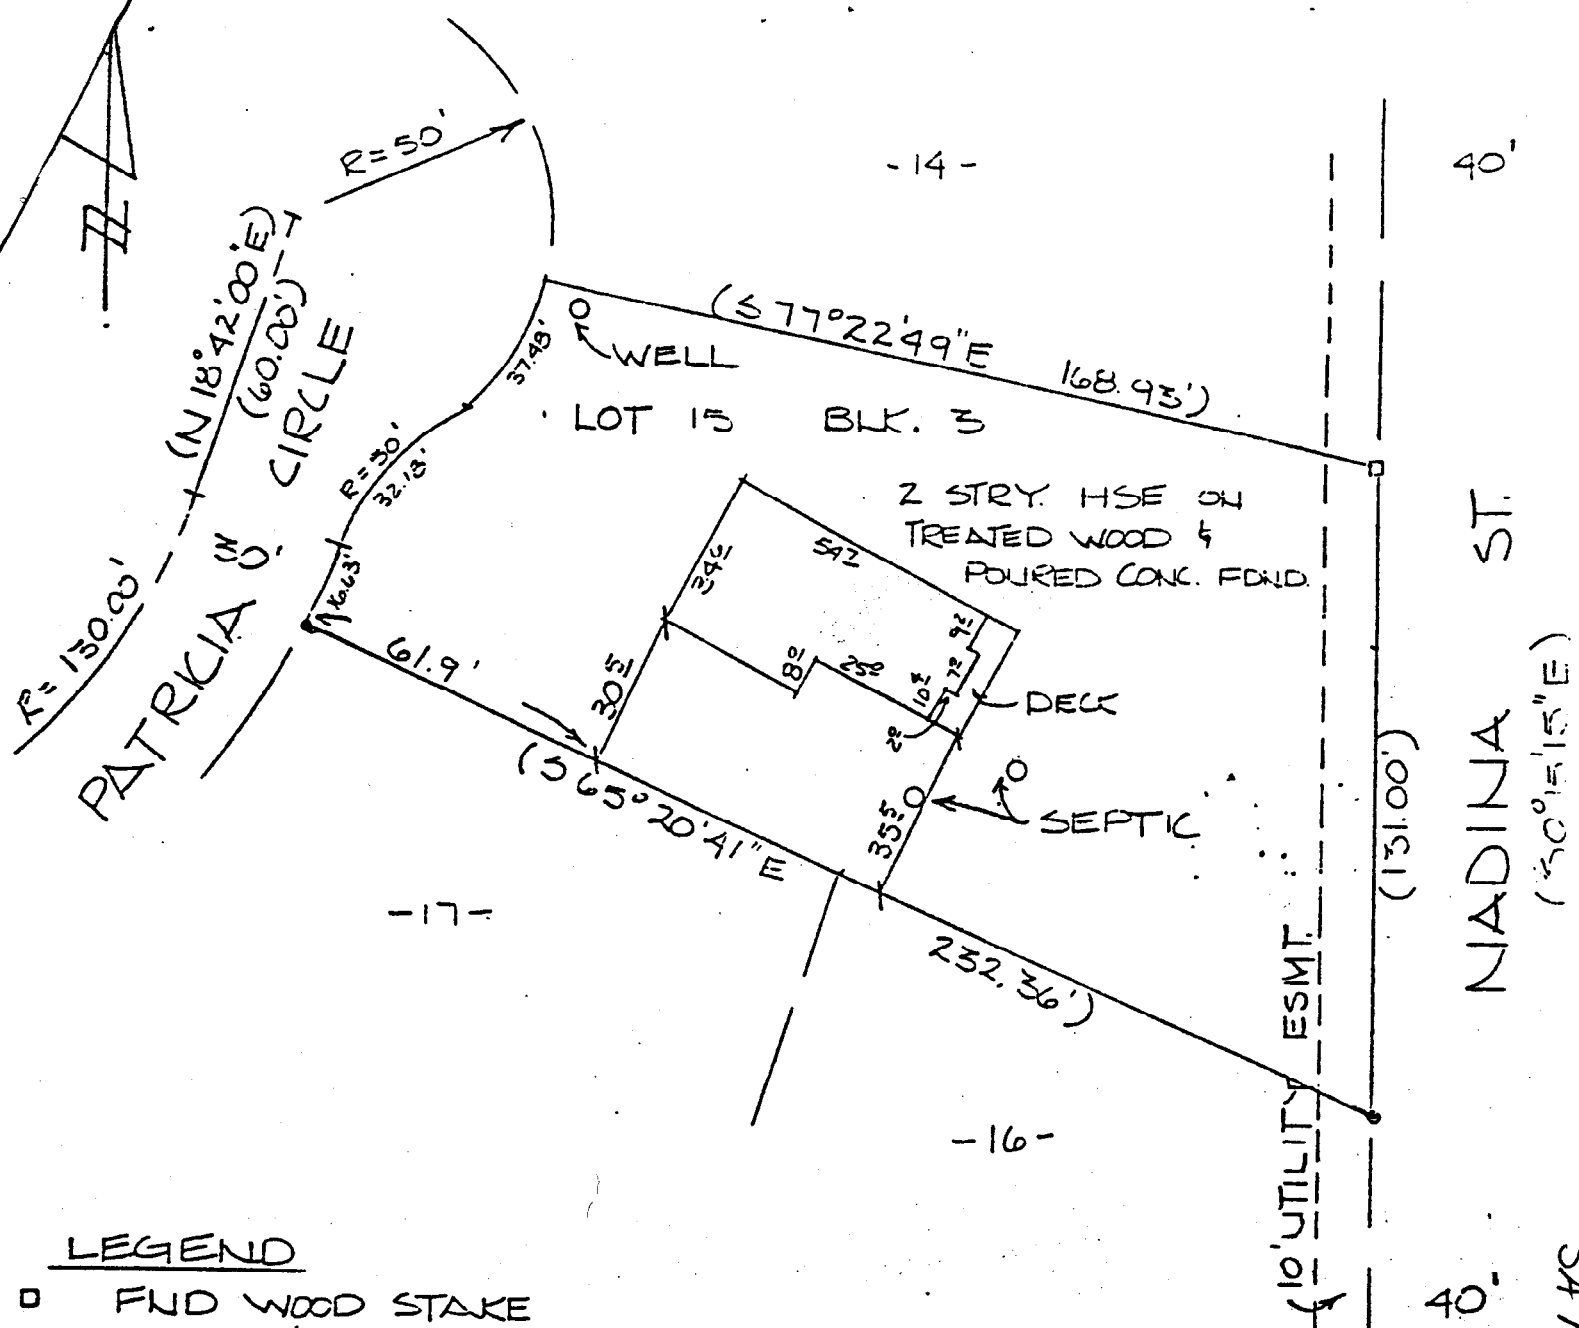


LEGEND

- FND WOOD STAKE
- FND 5/8" REBAR
- () RECORD DIMENSION

Per Vicki, lack of certification on survey is acceptable.

jbo

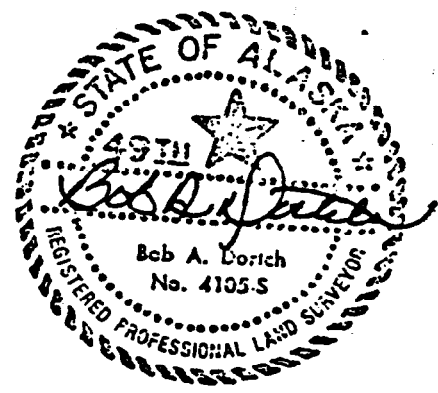

DATE OF SURVEY : 10-6-78

DWN PLH	RSM	AS-BUILT SURVEY	FB. 4-14
CKQ	R&M CONSULTANTS, INC.	LOT 15 BLOCK 3	GRID
DATE 10-9-78	ENGINEERS GEOLOGISTS PLANNERS SURVEYORS	FINGER COVE ESTATES	PROJ. NO. 54728
SCALE = 40		PALMIER RECORDING DIST.	DWG. NO. 1 OF 1