


PERMIT NUMBER:
SW010044

AS-BUILT DRAWING

PARCEL ID NUMBER:
011-262-05

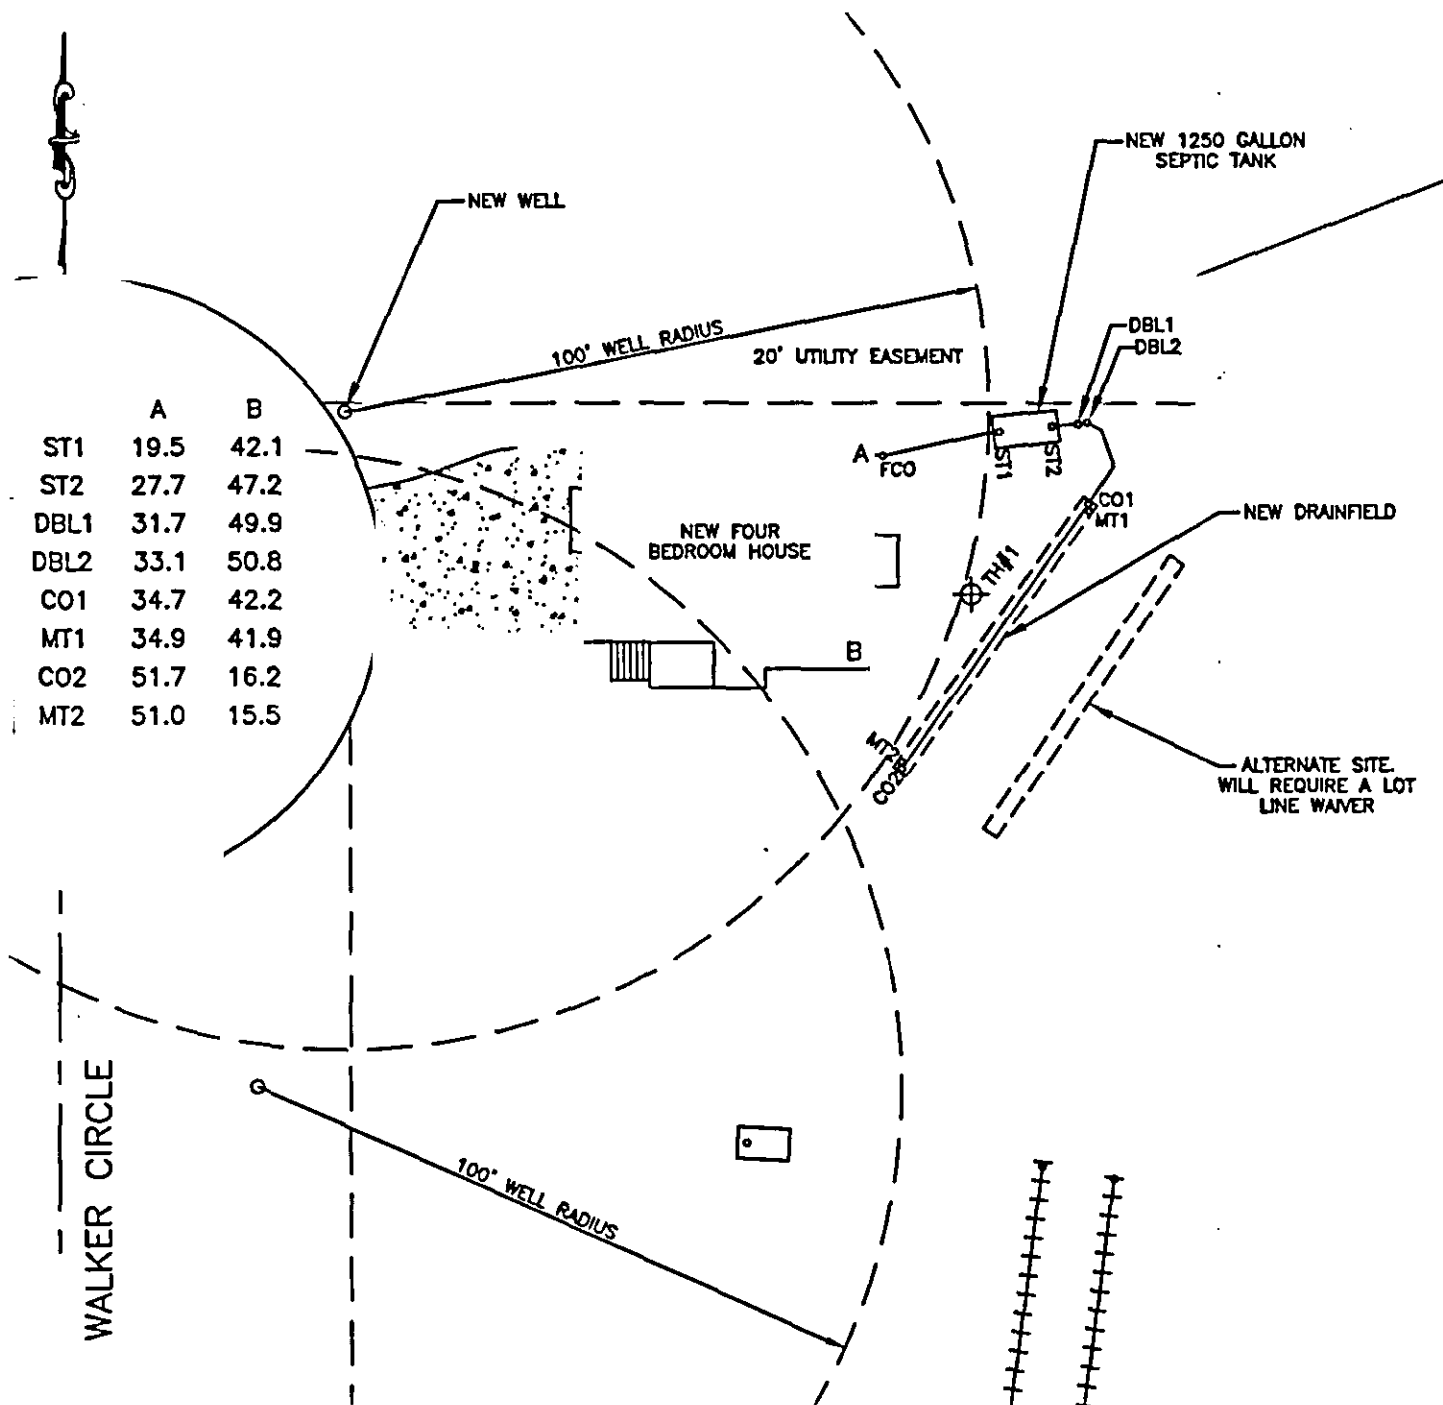

ALASKA WATER & WASTEWATER CONSULTANTS, INC.

6901 DEBARR ROAD, SUITE 2B • ANCHORAGE, AK 99504 • PHONE (907)357-6179 • FAX (907)358-3746

PREPARED FOR:

MARGURITE BAILY

PHONE NUMBER:

337-7333

LEGAL DESCRIPTION:

CAMPBELL POINT SUBDIVISION; LOT 1, BLOCK 3,

TYPE OF WORK:


AS-BUILT DRAWING OF NEW WELL AND SEPTIC SYSTEM

DATE:
2/20/2002

DRAWN BY:
J.L.M.

SCALE:
1" = 30'

PAGE NUMBER:
2 OF 3

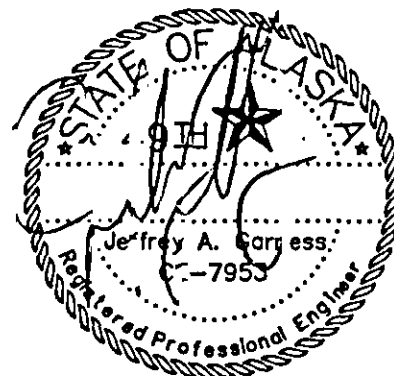

CLEARWATER DRILLING WELL LOG

OWNER *Margurite Bailey #2*
 ADDRESS *Acab. Ak*
 WELL-SITE *Campbell Point Sub.*
 LOT *1*
 BLOCK *3*
 DATE *11-2-01*
 DEPTH OF WELL - *300'*
 STATIC LEVEL *190'*
 GALS. PER MIN. *Estimate 20*
 SCREENED *NA*
 PERFORATED *NA*
 SIZE OF CASING *6"*

KIND OF FORMATION:

FROM	FL. to	FROM	FL. to	FL.
FROM 0	FL. to 30	FROM	FL. to	FL.
FROM 30	FL. to 37	FROM	FL. to	FL.
FROM 37	FL. to 157	FROM	FL. to	FL.
FROM 157	FL. to 198	FROM	FL. to	FL.
FROM 198	FL. to 286	FROM	FL. to	FL.
FROM 286	FL. to 300	FROM	FL. to	FL.
FROM	FL. to	FROM	FL. to	FL.

DRILLER

Long Lumber