

McKay Well Drilling

INELTS ID 83696

P.O. Box 878148
Wasilla, Alaska 99687-7704
Phone 376-5058

Well Owner Valley Worship Center
Well Location 3401 E. Parks Hwy

Date 9-18-99
Phone 353-2065

Size Casing 6" Depth of Hole 180 Cased to 180 feet
Static Water Level 126 feet Well Test 35-40 Gal per Minute for 1 Hours
Date of Completion 9-19-99

WELL LOG

0 - 105 SAND & GRAVEL
105 - 150 HARD PAN STRKS. OF GRAVEL
150 - 170 SAND SMALL GRAVEL SMALL WATER
170 - 180 COARSE GRAVEL W/ WATER

Calvin F. McKay

AUTHORIZATION TO DRILL

I hereby authorize McKay Drilling to proceed with the above work. Payment shall be made in the following manner:

Rig up Minimum _____ feet. @ _____ per foot
Balance due upon completion.

In the event it is necessary to institute legal proceedings to collect any amounts due on this contract, I agree to pay an additional sum of fifteen percent (15%) of the original contract price. Plus attorney's fees, and cost for legal proceedings.

Name _____

Date _____

Address _____

Valley Pump & Well Service LLC

2200 W. Success Drive

Wasilla, AK 99654

907-373-2343

Flow Test

Name: Kings Chapel Alaska
Legal: 17N01W12D014
Driller: Unknown
Date: May 16th 2020

Well Depth: 173'
Static Water Level: 119'
Tested By: Jason Palmer

<u>Time</u>	<u>Static</u>	<u>GPM</u>	<u>GPM Pumped</u>
2:00	119		
2:05	127	52	260
2:10	127	52	520
2:15	127	52	780
2:30	127	52	1560
2:45	127	52	2340
3:00	127	52	3120

Avg GPM 52


Recovery

3:01	119
------	-----



SCALE:
1"=50'

1 OVERALL SITE LAYOUT
SCALE: 1"=50'

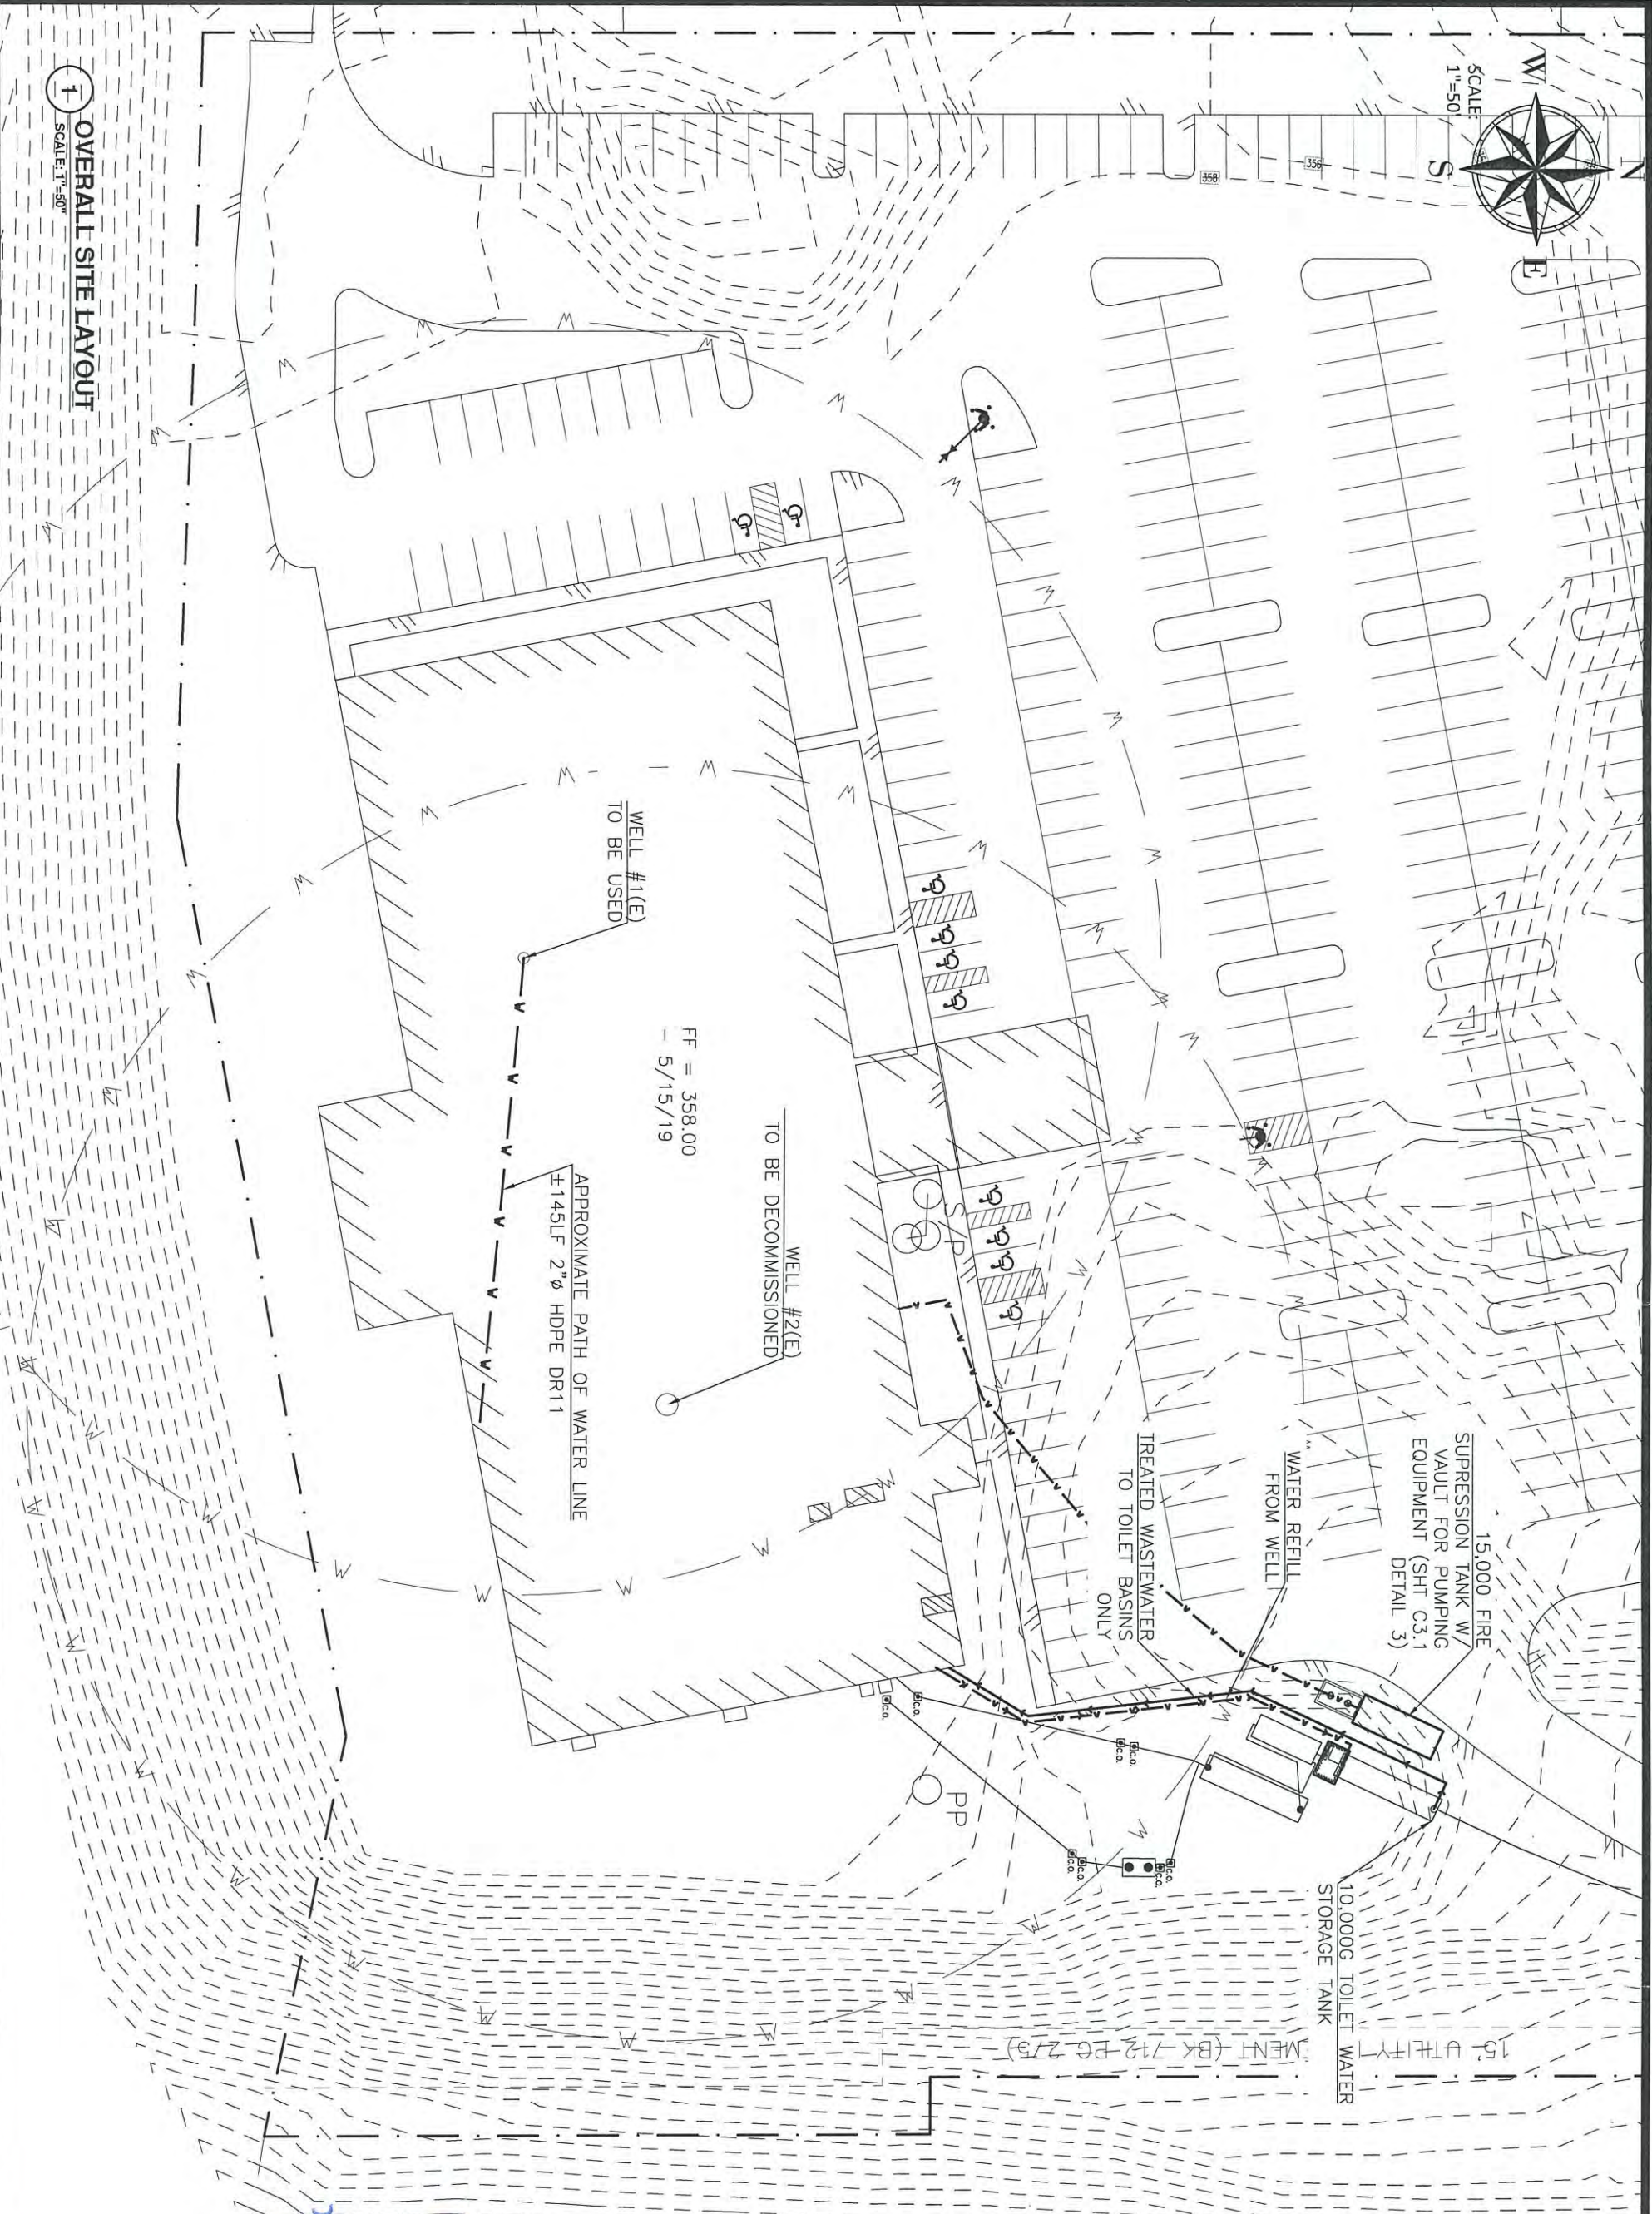

15,000 FIRE SUPPRESSION TANK w/ VAULT FOR PUMPING EQUIPMENT (SHT C3.1 DETAIL 3)

WATER REFILL FROM WELL

TREATED WASTEWATER TO TOILET BASINS ONLY

10,000G TOILET WATER STORAGE TANK

15' UTILITY TRENCH (BK 712 PG 275)

RECEIVED

JAN 21 2021

State of Alaska
JEC Wasilla Alaska 99667

Pannone Engineering Services, LLC
C.I.1088
P.O. BOX 1807
PALMER, AK 99645
T: (907) 745-8200
F: (907) 745-8201

T17N R1W SEC12 LD14
3301/3401 E PARKS HWY
POTABLE / NON POTABLE
WATER PLAN

OWNER:
KINGS CATHEDRAL & CHAPELS
777 MOKULELE HWY
KAHULUI, HI 96732

RECORD DRAWING
1. DATA PROVIDED
This will serve to certify that these Record Drawings are a true and accurate representation of the project as constructed.
CONTRACTOR:
BY: _____ DATE: _____
2. DATA TRANSFERRED
BY: _____
COMPANY: _____
DATE: _____
3. DATA TRANSFER CHECKED
Based on periodic field observations by the Engineer (this may or may not be direct supervision), the Contractor-provided data appears to represent the project as constructed.
BY: _____
COMPANY: _____
DATE: _____



SHEET
DRAWN ACP
CHECKED SRP
GRID
DATE 1/6/2021
C3.1
1 OF 2