

3949

Sourdough Drilling
P.O. Box 721
Soldotna, Alaska 99669
(907) 262-5494

CUSTOMER'S ORDER NO.	DEPT.	DATE 8-23-12
NAME LEE REININGHAUS		
ADDRESS P.O. Box MXY 91B Mccharthy AK. 99588		

SOLD BY	CASH	C.O.D.	CHARGE	ON ACCT.	MOSE. RETD.	PAID OUT
QUAN	DESCRIPTION	PRICE	AMOUNT			
1	5 HP. SEPT. START PUMP 10GPM	535 00				
2	1" x 10" Bushing	2 50				
3	2- 1" STEEL RING NIPPLES	8 00				
4	4- 1" STEEL CLAMPS	5 00				
5	1- 1" COUPLING	2 50				
6	1- 1" 90°	2 00				
7	25' HOSE FITTING	7 00				
8	1- SHANK SPLICE KIT	5 00				
9	1- 1" BUSHING	1 50				
10	1- MALE PLUG	8 00				
11	80 FTS. TWISTED ELECT WIRE	80 00				
12	74 FTS. POLY PIPE 1"	74 00				
13	INSTALLED WATER PUMP	125 00				
14	85 FTS. ROPE	17 00				
15	TOTAL	872 50				
16	THANK YOU LEE					
17						
18	PUMP SET AT 75 FTS.					

REC'D BY

REDIFORM

5L320/01320

KEEP THIS SLIP
FOR REFERENCE

3945

Sourdough Drilling
P.O. Box 721
Soldotna, Alaska 99669
(907) 262-5494

CUSTOMER'S ORDER NO.	DEPT.	DATE 8-15-12
NAME Lee Reiningshaus		
ADDRESS		

SOLD BY	CASH	C.O.D.	CHARGE	ON ACCT.	MOSE. RETD.	PAID OUT
QUAN	DESCRIPTION	PRICE	AMOUNT			
1	DRILL 6" WATER WELL 80 FTS	4560 00				
2	DRIVE SHOE + WELL CAR	150 00				
3	RIG TRAVEL TIME	200 00				
4	BRIDGE PERMIT	225 00				
5	TOTAL	5135 00				
6						
7						
8						
9	THANK YOU LEE					
10						
11						
12	Pay in full					
13	Pay in full					
14						
15						
16						
17						
18						

REC'D BY

REDIFORM


5L320/01320

KEEP THIS SLIP
FOR REFERENCE

PROPERTIES LOOK DINA 122

NW CORNER: 142.897876°W / 61.4452178°N
 SW CORNER: 142.8978704°W / 61.444525°N
 NE CORNER: 142.8953363°W / 61.4442715°N

SE CORNERS (3): 142.8961062°W / 61.4438706°N
 142.8958348°W / 61.4439555°N

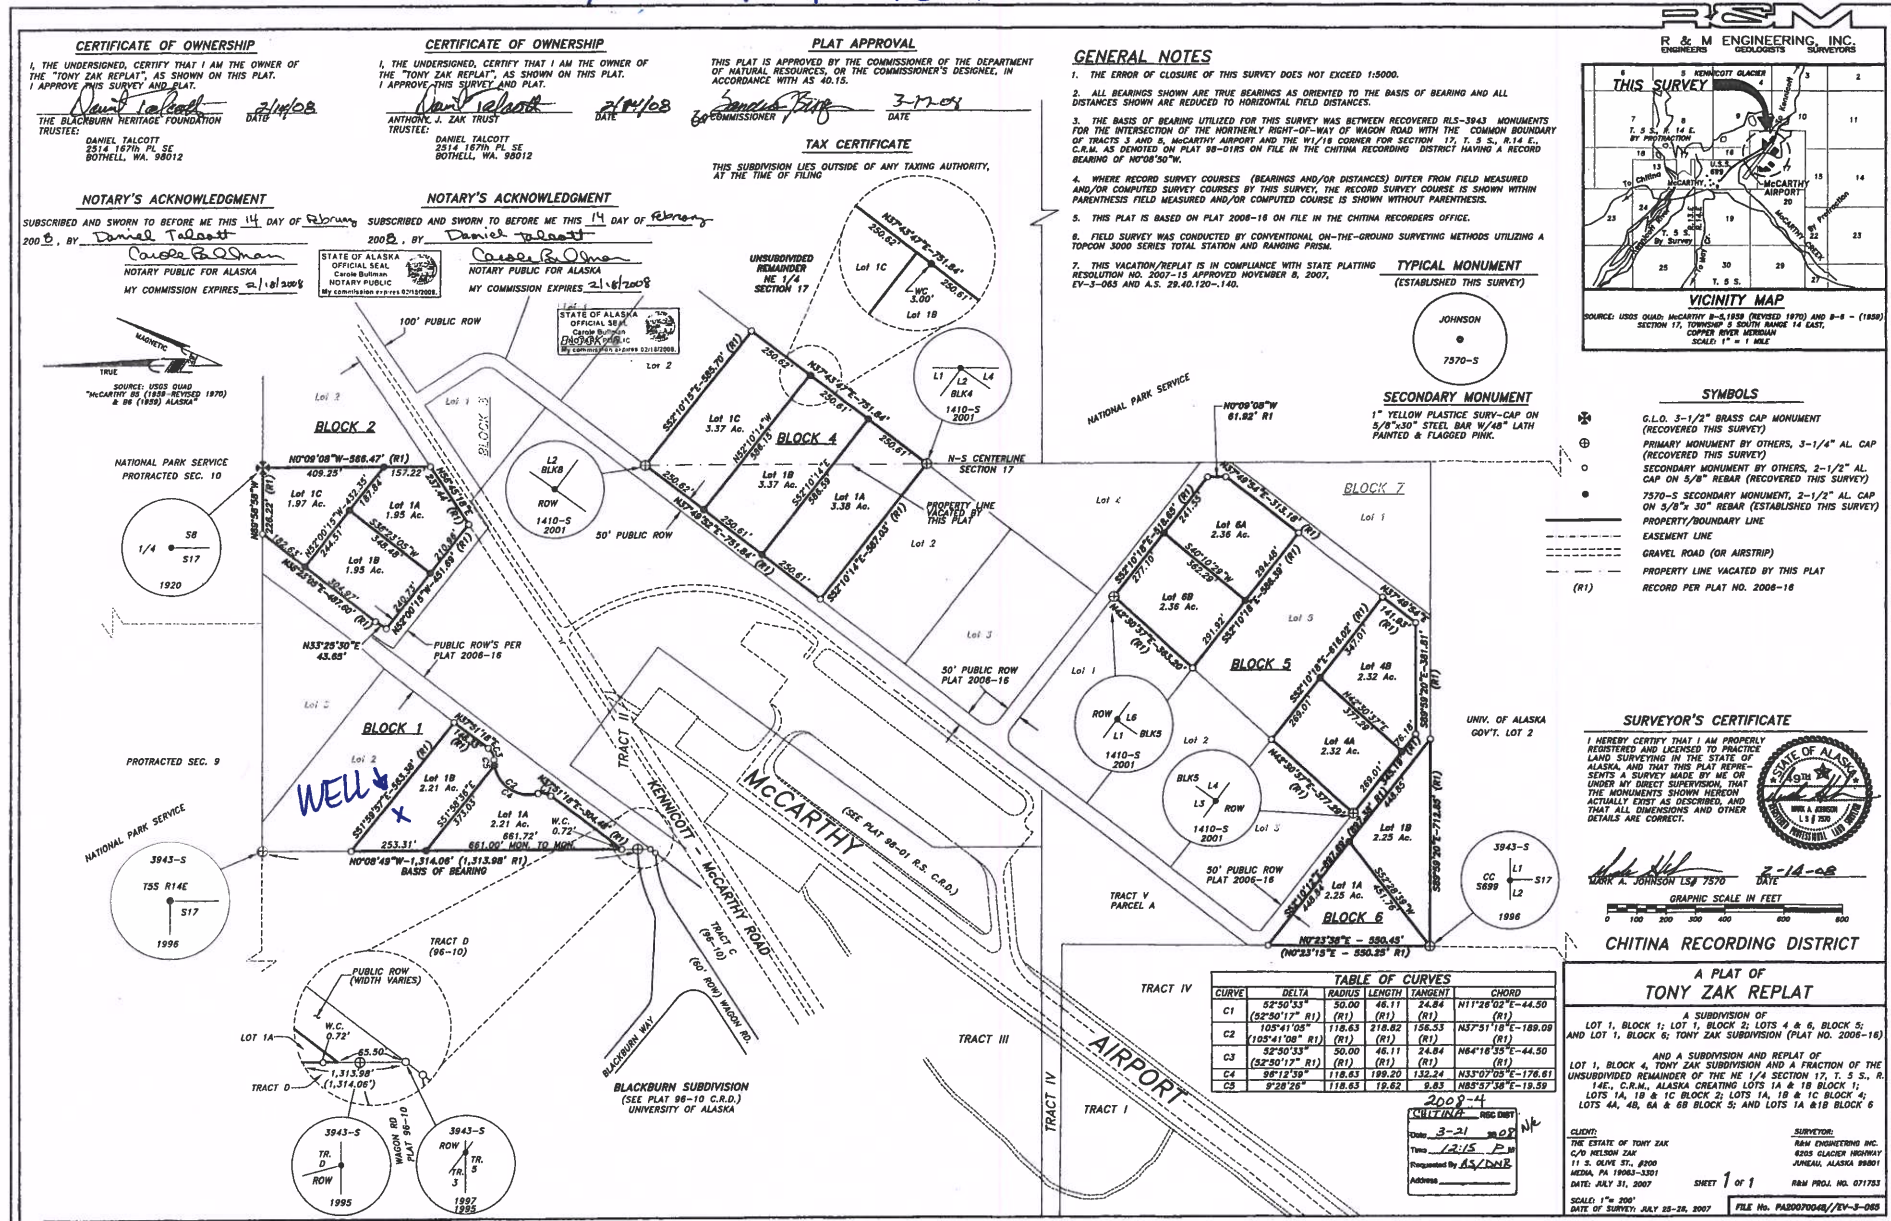

CERTIFICATE OF OWNERSHIP

I, THE UNDERSIGNED, CERTIFY THAT I AM THE OWNER OF THE "TONY ZAK REPLAT", AS SHOWN ON THIS PLAT. I APPROVE THIS SURVEY AND PLAT.

Daniel Talcott
2514 187th Pl SE
Bothell, WA 98012

DATE: 7/14/08

CERTIFICATE OF OWNERSHIP

I, THE UNDERSIGNED, CERTIFY THAT I AM THE OWNER OF THE "TONY ZAK REPLAT", AS SHOWN ON THIS PLAT. I APPROVE THIS SURVEY AND PLAT.

Anthony J. Zak Trust
DANIEL TALCOTT
2514 187th Pl SE
Bothell, WA 98012

DATE: 7/14/08

PLAT APPROVAL

THIS PLAT IS APPROVED BY THE COMMISSIONER OF THE DEPARTMENT OF NATURAL RESOURCES, ON THE COMMISSIONER'S DESIGNEE, IN ACCORDANCE WITH AS 40.15.

Commissioner
DATE: 7-17-08

TAX CERTIFICATE

THIS SUBDIVISION LIES OUTSIDE OF ANY TAXING AUTHORITY, AT THE TIME OF FILING

GENERAL NOTES

1. THE ERROR OF CLOSURE OF THIS SURVEY DOES NOT EXCEED 1:5000.
2. ALL BEARINGS SHOWN ARE TRUE BEARINGS AS ORIENTED TO THE BASIS OF BEARING AND ALL DISTANCES SHOWN ARE REDUCED TO HORIZONTAL FIELD DISTANCES.
3. THE BASIS OF BEARING UTILIZED FOR THIS SURVEY WAS BETWEEN RECOVERED RLS-3943 MONUMENTS FOR THE INTERSECTION OF THE NORTHERLY RIGHT-OF-WAY OF WAGON ROAD WITH THE COMMON BOUNDARY OF TRACTS 3 AND 6, MCCARTHY AIRPORT AND THE N1/4 CORNER FOR SECTION 17, T. 5 S., R. 14 E., C.R.M. AS DETONED ON PLAT 98-018 ON FILE IN THE CHITNA RECORDING DISTRICT HAVING A RECORD BEARING OF N0°08'50"W.
4. WHERE RECORD SURVEY COURSES (BEARINGS AND/OR DISTANCES) DIFFER FROM FIELD MEASURED AND/OR COMPUTED SURVEY COURSES BY THIS SURVEY, THE RECORD SURVEY COURSE IS SHOWN WITHIN PARENTHESES FIELD MEASURED AND/OR COMPUTED COURSE IS SHOWN WITHOUT PARENTHESES.
5. THIS PLAT IS BASED ON PLAT 2008-16 ON FILE IN THE CHITNA RECORDERS OFFICE.
6. FIELD SURVEY WAS CONDUCTED BY CONVENTIONAL ON-THE-GROUND SURVEYING METHODS UTILIZING A TOPCON 3000 SERIES TOTAL STATION AND RANGING PRISM.
7. THIS VACATION/REPLAT IS IN COMPLIANCE WITH STATE PLATTING RESOLUTION NO. 2007-15 APPROVED NOVEMBER 6, 2007, BY 3-065 AND A.S. 29-40.120-146.

TYPICAL MONUMENT


(ESTABLISHED THIS SURVEY)



SECONDARY MONUMENT

1" YELLOW PLASTIC SURV-CAP ON 5/8"x30" STEEL BAR W/48" LATH PAINTED & FLAGGED PINK.

R & M ENGINEERING, INC.
ENGINEERS SURVEYORS

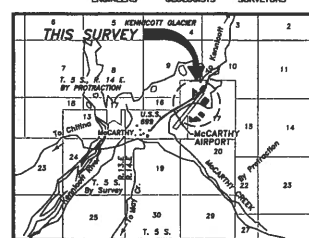

VICINITY MAP

SOURCE: USGS QUAD MCCARTHY 8-5-1888 (REVISED 1970) AND 8-6-1888 (REVISED 1970) SECTION 17, TOWNSHIP 5 SOUTH RANGE 14 EAST, COPPER RIVER MERIDIAN SCALE: 1" = 1 MILE

SYMBOLS

- G.L.O. 3-1/2" BRASS CAP MONUMENT (RECOVERED THIS SURVEY)
- PRIMARY MONUMENT BY OTHERS, 3-1/4" AL CAP (RECOVERED THIS SURVEY)
- SECONDARY MONUMENT BY OTHERS, 2-1/2" AL CAP ON 5/8" REBAR (RECOVERED THIS SURVEY)
- 7570-S SECONDARY MONUMENT, 2-1/2" AL CAP ON 5/8" 30" REBAR (ESTABLISHED THIS SURVEY)
- PROPERTY/BOUNDARY LINE
- EASEMENT LINE
- GRAVEL ROAD (OR AIRSTRIP)
- PROPERTY LINE VACATED BY THIS PLAT
- (R1) RECORD PER PLAT NO. 2008-16

SURVEYOR'S CERTIFICATE

I HEREBY CERTIFY THAT I AM PROPERLY REGISTERED AND LICENSED TO PRACTICE LAND SURVEYING IN THE STATE OF ALASKA, AND THAT THIS PLAT REPRESENTS A SURVEY MADE BY ME OR UNDER MY DIRECT SUPERVISION, THAT THE MONUMENTS SHOWN HEREON ACTUALLY EXIST AS DESCRIBED, AND THAT ALL DIMENSIONS AND OTHER DETAILS ARE CORRECT.



DATE: 7-14-08

GRAPHIC SCALE IN FEET

CHITNA RECORDING DISTRICT

A PLAT OF TONY ZAK REPLAT

LOT 1, BLOCK 1; LOT 1, BLOCK 2; LOTS 4 & 6, BLOCK 5; AND LOT 1, BLOCK 6; TONY ZAK SUBDIVISION (PLAT NO. 2008-16) AND A SUBDIVISION AND REPLAT OF LOT 1, BLOCK 4, TONY ZAK SUBDIVISION AND A FRACTION OF THE UNDIVIDED REMAINDER OF THE NE 1/4 SECTION 17, T. 5 S., R. 14E., C.R.M., ALASKA CREATING LOTS 1A & 1B BLOCK 1; LOTS 1A, 1B & 1C BLOCK 2; LOTS 1A, 1B & 1C BLOCK 4; LOTS 4A, 4B, 6A & 6B BLOCK 5; AND LOTS 1A & 1B BLOCK 6

CLIENT: THE ESTATE OF TONY ZAK
C/O NELSON ZAK
11 S. OLIVE ST., #200
MEDA, PA 15061-3501
DATE: JULY 31, 2007
SHEET 1 OF 1
SCALE: 1" = 200'
DATE OF SURVEY: JULY 23-26, 2007
FILE NO. PA0007064/EV-3-065

CURVE	DELTA	RADIUS	LENGTH	TANGENT	CHORD
C1	52°50'33"	50.00	46.11	24.84	N11°28'02"E-44.50
	(32°50'12" R1)	(R1)	(R1)	(R1)	(R1)
C2	105°41'05"	118.63	218.82	156.53	N37°51'18"E-189.09
	(105°41'08" R1)	(R1)	(R1)	(R1)	(R1)
C3	52°50'33"	50.00	46.11	24.84	N84°18'35"E-44.50
	(32°50'12" R1)	(R1)	(R1)	(R1)	(R1)
C4	98°12'39"	118.63	199.20	132.24	N33°07'05"E-176.81
	(98°12'39" R1)	(R1)	(R1)	(R1)	(R1)
C5	9°28'26"	118.63	18.62	9.83	N85°57'58"E-18.59
	(9°28'26" R1)	(R1)	(R1)	(R1)	(R1)

2009-4

CHITNA REC DIST
Date: 3-21
Time: 12:15 P.M.
Requested by: AS/DNB
Address:

NOTARY'S ACKNOWLEDGMENT
SUBSCRIBED AND SWORN TO BEFORE ME THIS 14 DAY OF February 2008, BY Daniel Talcott

Daniel Talcott
NOTARY PUBLIC FOR ALASKA
MY COMMISSION EXPIRES 2/18/2009

NOTARY'S ACKNOWLEDGMENT
SUBSCRIBED AND SWORN TO BEFORE ME THIS 14 DAY OF February 2008, BY Daniel Talcott

Daniel Talcott
NOTARY PUBLIC FOR ALASKA
MY COMMISSION EXPIRES 2/18/2009

