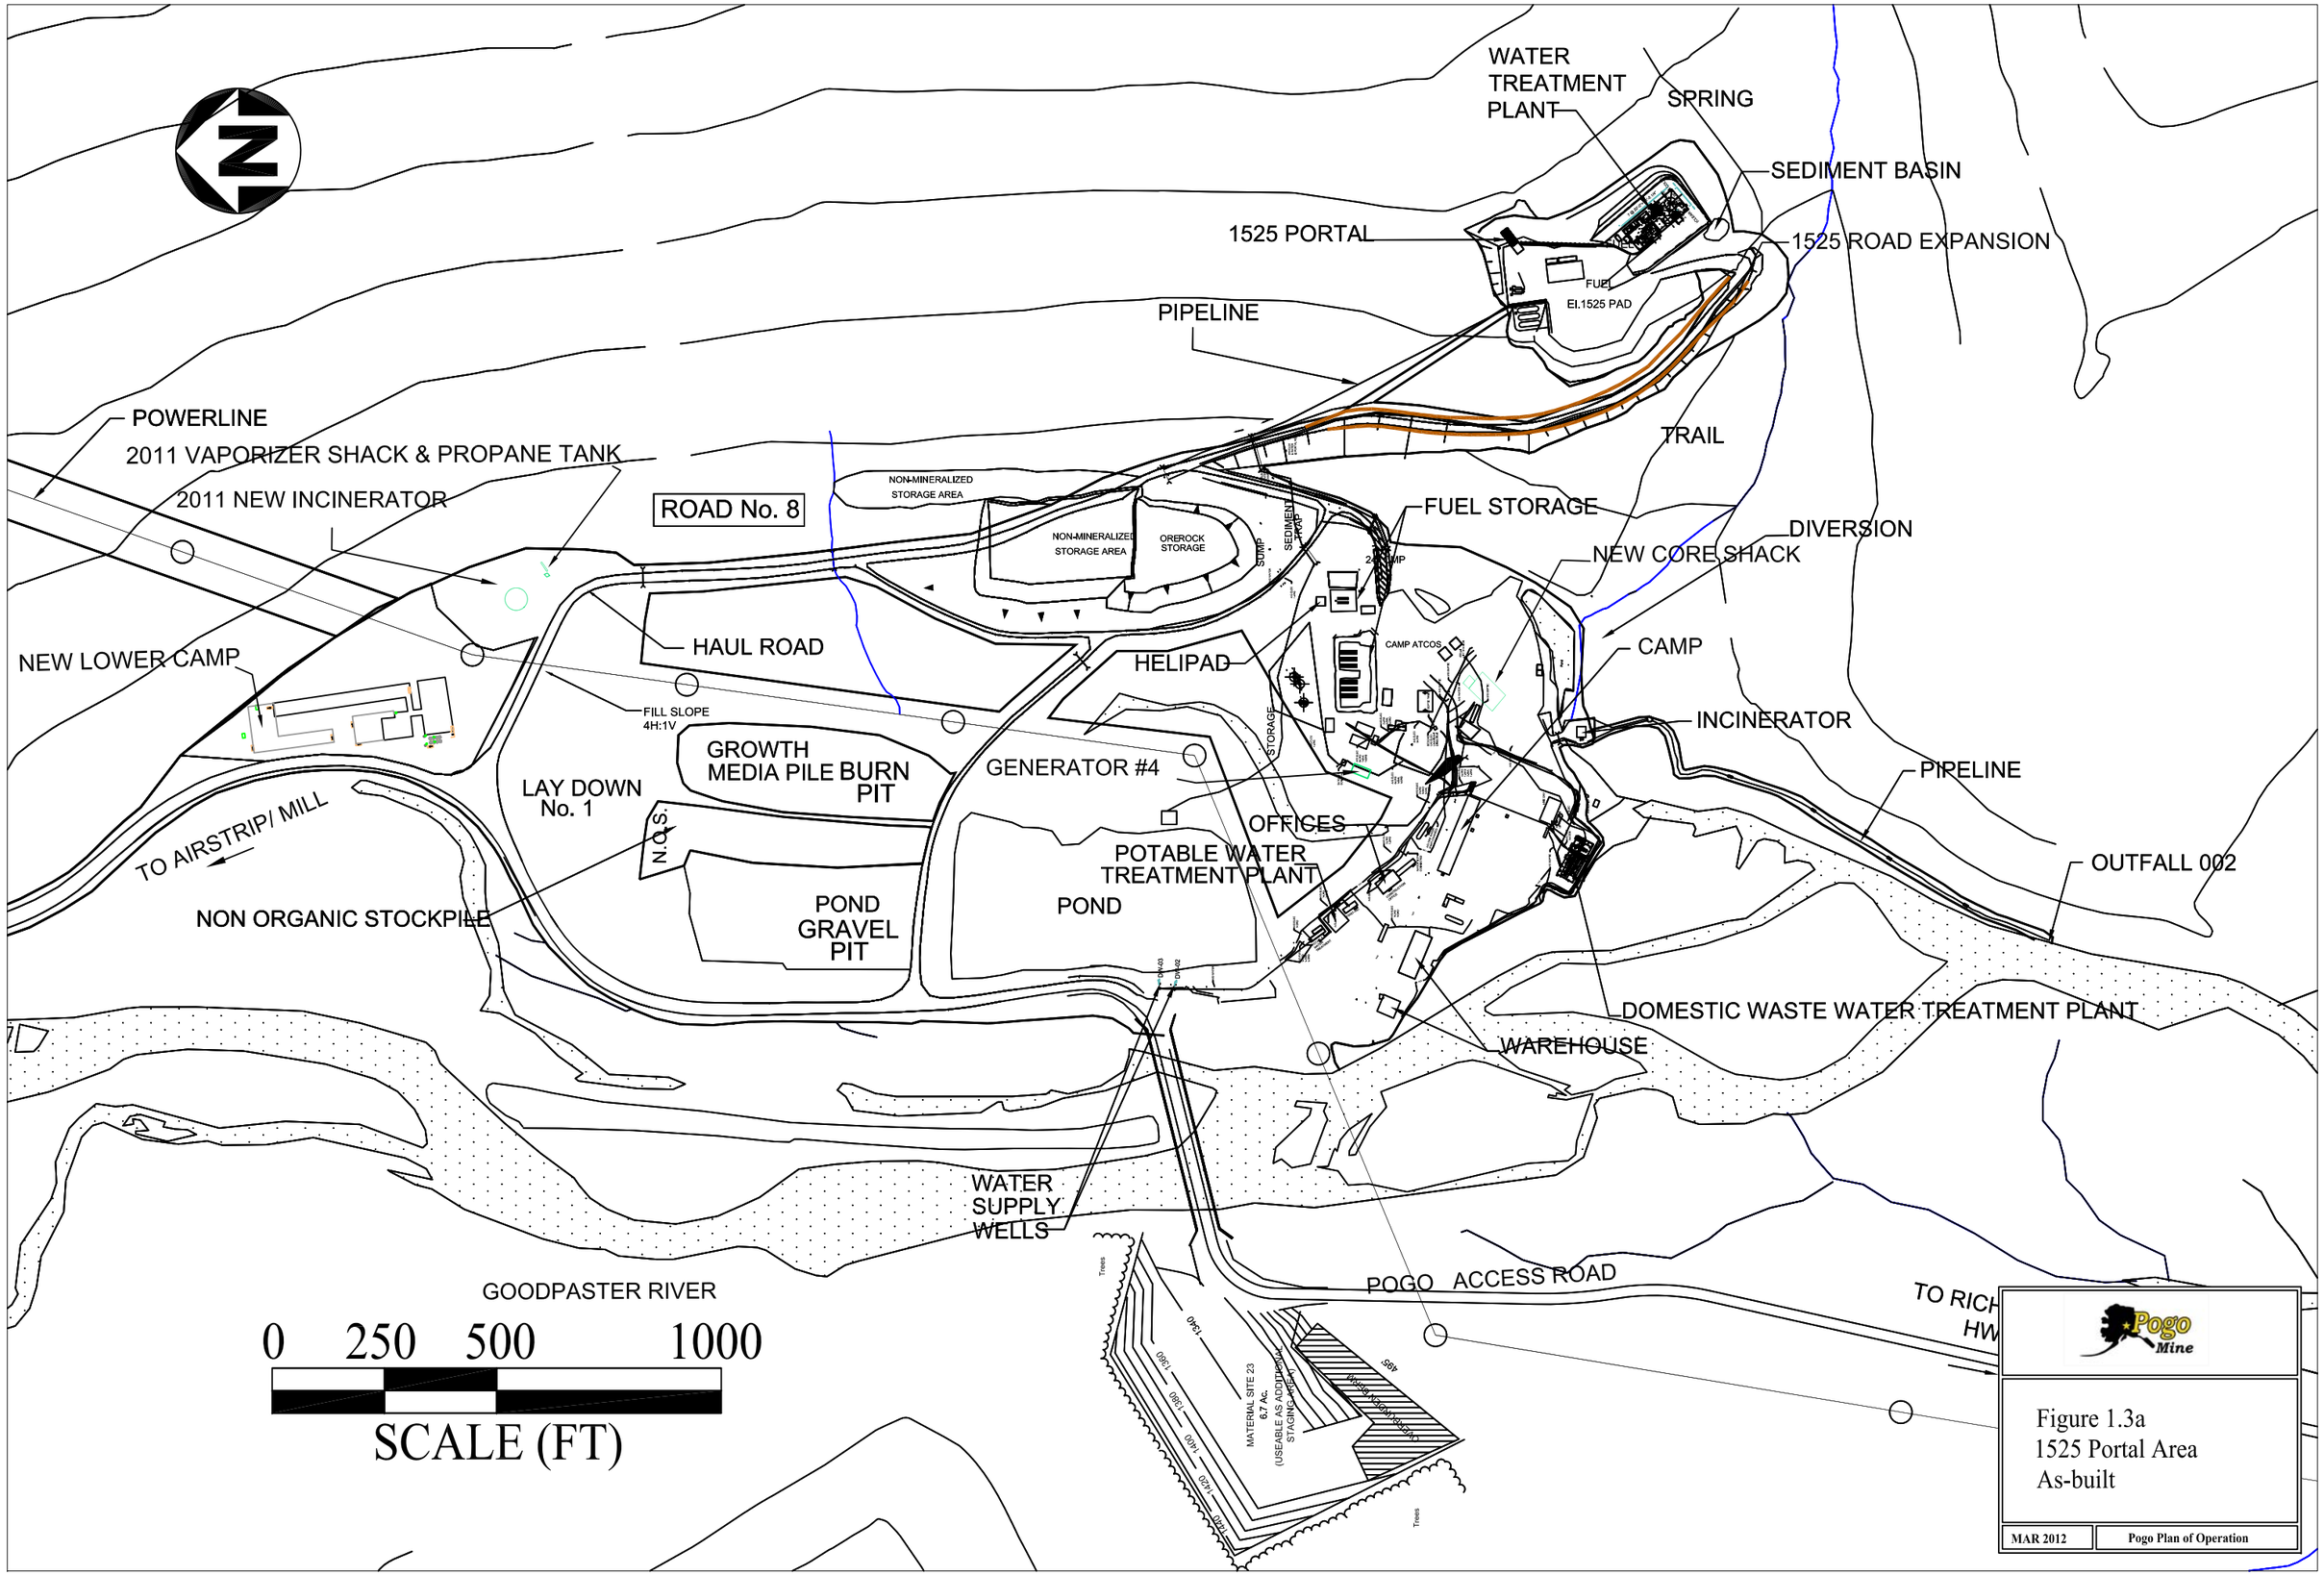
WATER TREATMENT PLANT
SPRING
SEDIMENT BASIN
1525 PORTAL
1525 ROAD EXPANSION
FUEL
El.1525 PAD
PIPELINE
POWERLINE
2011 VAPORIZER SHACK & PROPANE TANK
2011 NEW INCINERATOR
ROAD No. 8
NON-MINERALIZED STORAGE AREA
NON-MINERALIZED STORAGE AREA
OREROCK STORAGE
SUMP
SEDIMENT POND
TRAIL
FUEL STORAGE
DIVERSION
NEW CORE SHACK
CAMP
NEW LOWER CAMP
HAUL ROAD
HELIPAD
CAMP ATCOS
INCINERATOR
FILL SLOPE 4H:1V
GROWTH MEDIA PILE BURN PIT
GENERATOR #4
STORAGE
PIPELINE
LAY DOWN No. 1
N.O.S.
OFFICES
POTABLE WATER TREATMENT PLANT
OUTFALL 002
TO AIRSTRIP/ MILL
NON ORGANIC STOCKPILE
POND GRAVEL PIT
POND
DOMESTIC WASTE WATER TREATMENT PLANT
WAREHOUSE
WATER SUPPLY WELLS
GOODPASTER RIVER
POGO ACCESS ROAD
TO RICH HW
MATERIAL SITE 23
6.7 Ac.
(USEABLE AS ADDITIONAL STAGING AREA)
OVERBURDEN DISPOSAL
Trees
0 250 500 1000
SCALE (FT)
Pogo Mine
Figure 1.3a
1525 Portal Area
As-built
MAR 2012
Pogo Plan of Operation