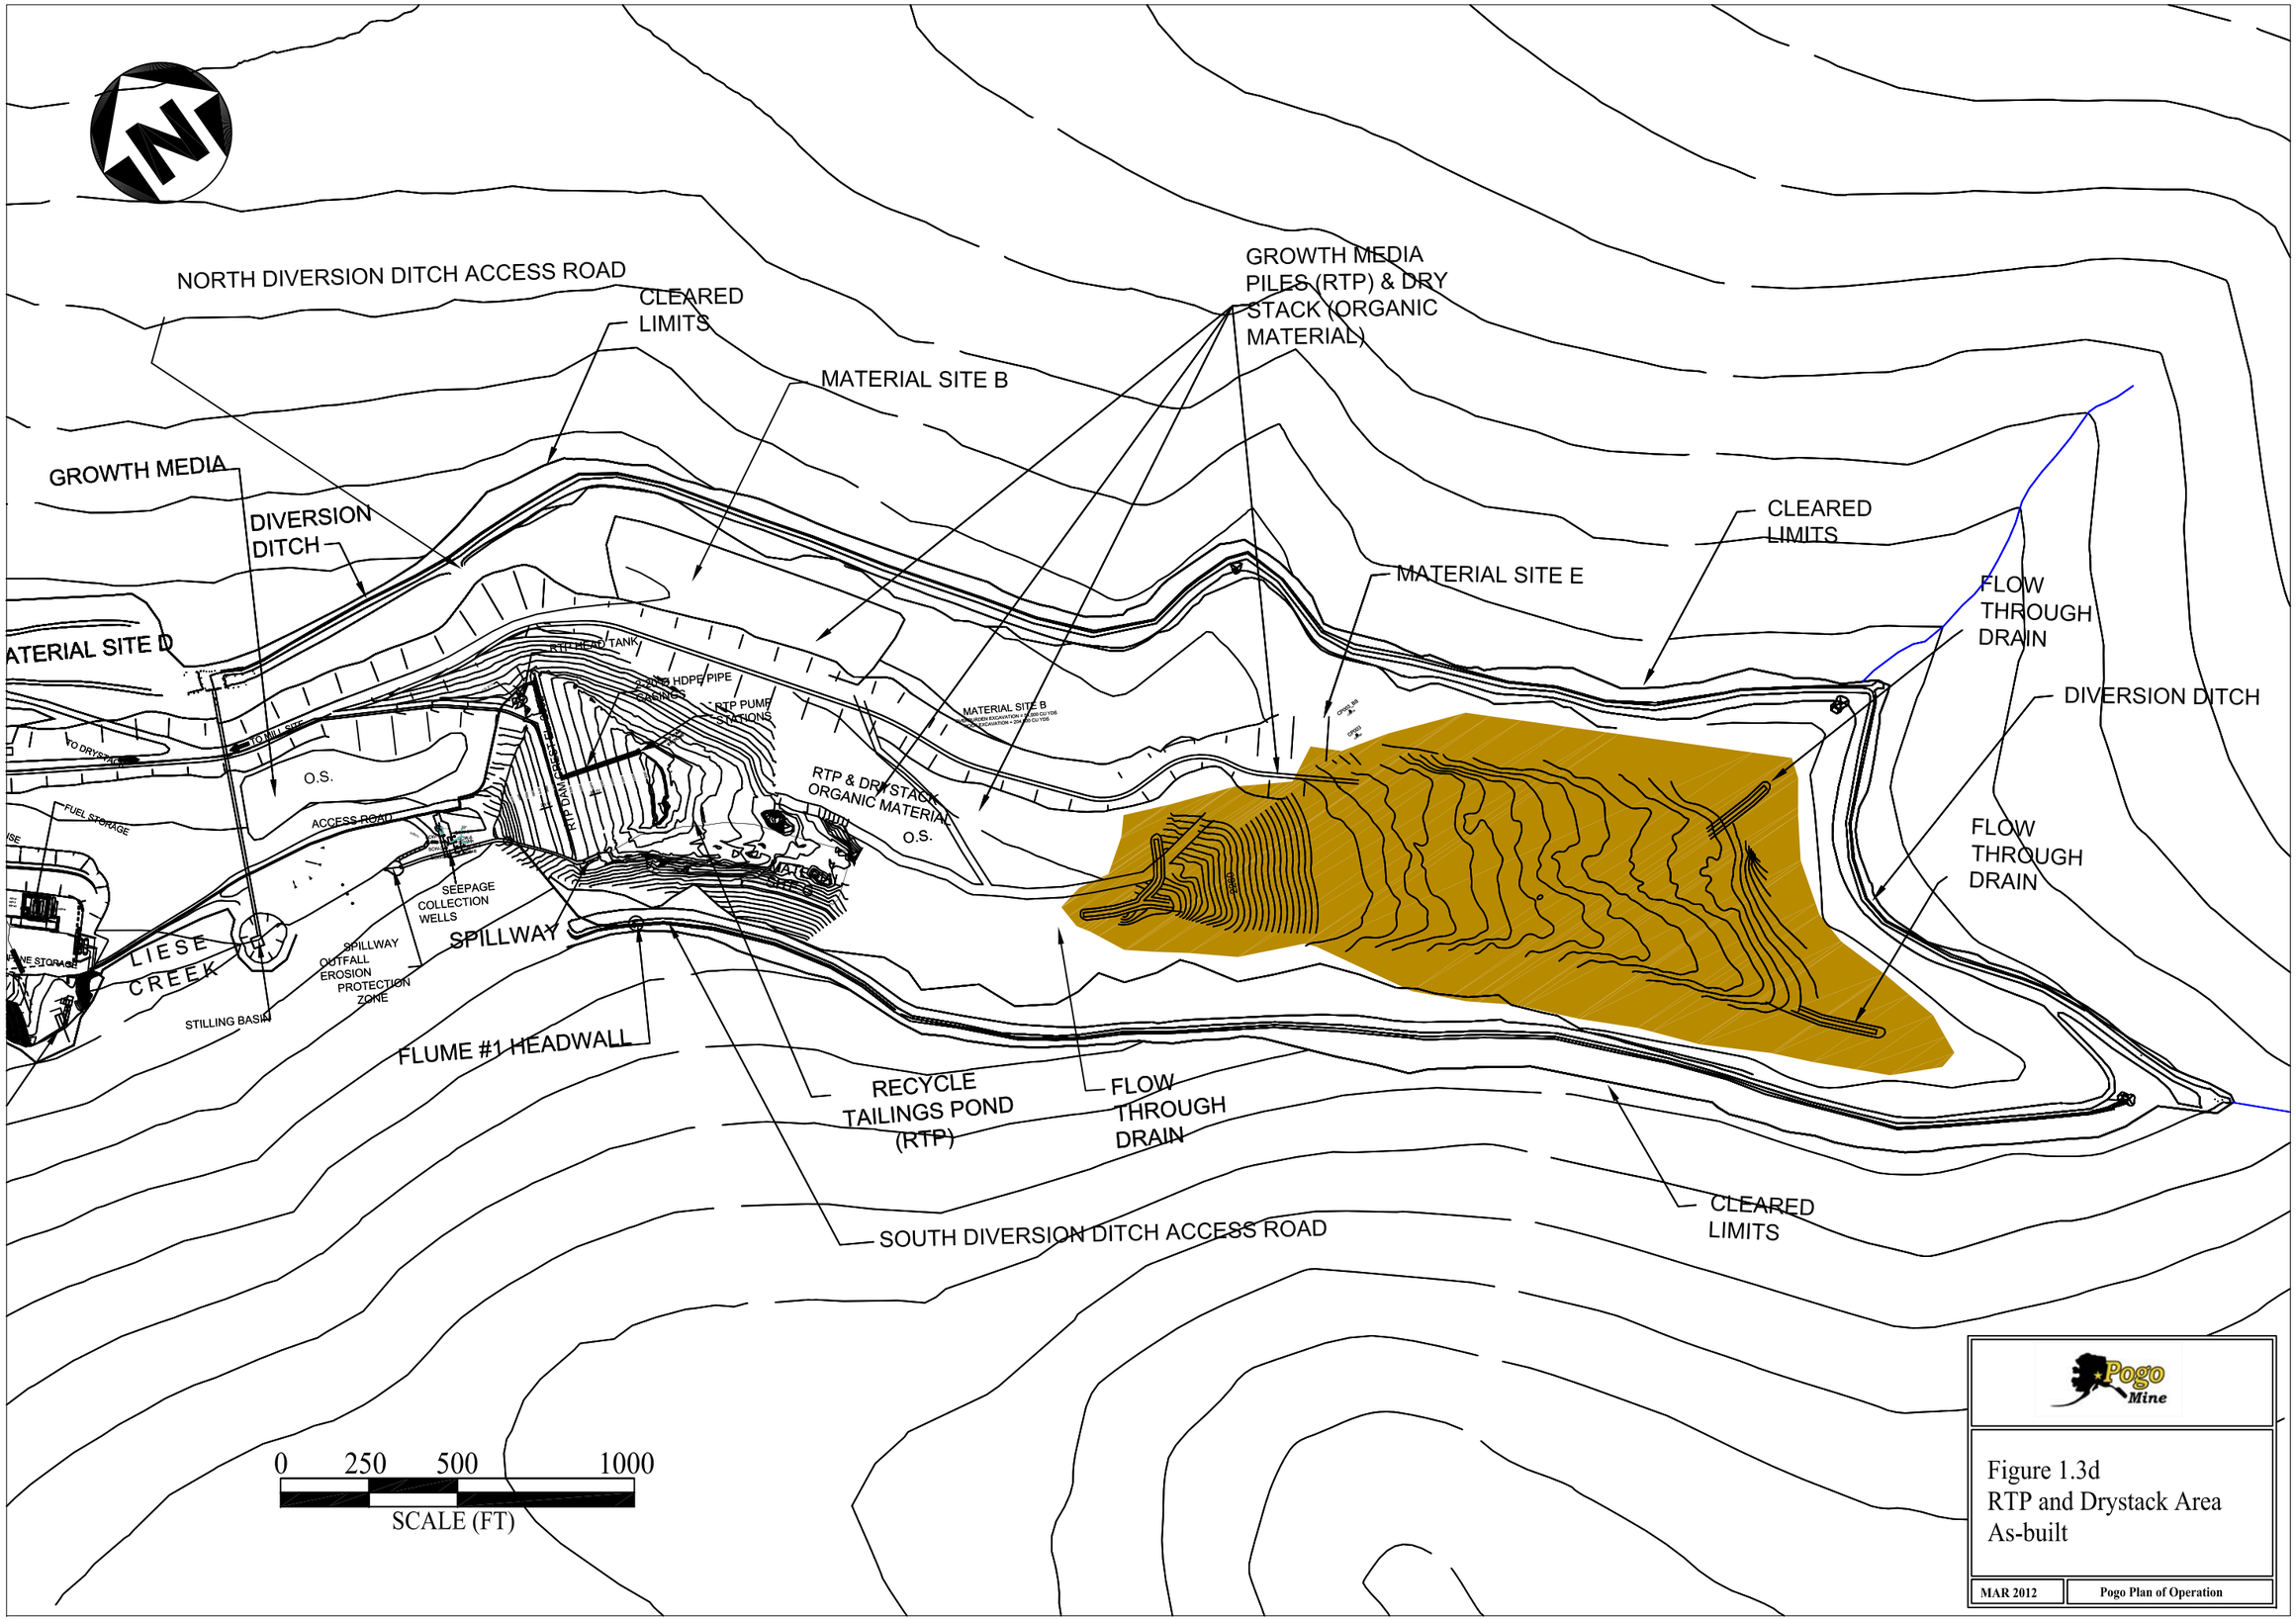
NORTH DIVERSION DITCH ACCESS ROAD
CLEARED LIMITS
MATERIAL SITE B
GROWTH MEDIA PILES (RTP) & DRY STACK (ORGANIC MATERIAL)
GROWTH MEDIA
DIVERSION DITCH
ATERIAL SITE D
MATERIAL SITE E
CLEARED LIMITS
FLOW THROUGH DRAIN
DIVERSION DITCH
FLOW THROUGH DRAIN
RTP HEAD TANK
2-20" HDPE PIPE CULVERTS
RTP PUMP STATIONS
MATERIAL SITE B
RTP & DRYSTACK ORGANIC MATERIAL
O.S.
O.S.
TO DRYSTACK
TO MILL SITE
FUEL STORAGE
ACCESS ROAD
SEEPAGE COLLECTION WELLS
SPILLWAY
SPILLWAY OUTFALL EROSION PROTECTION ZONE
LIESE CREEK
STILLING BASIN
FLUME #1 HEADWALL
RECYCLE TAILINGS POND (RTP)
FLOW THROUGH DRAIN
SOUTH DIVERSION DITCH ACCESS ROAD
CLEARED LIMITS
0 250 500 1000
SCALE (FT)
Pogo Mine
Figure 1.3d
RTP and Drystack Area
As-built
MAR 2012
Pogo Plan of Operation