POGO MINE
SUMITOMO METAL MINING POGO LLC
MINING DONE RIGHT

APPENDIX A –

MAPS

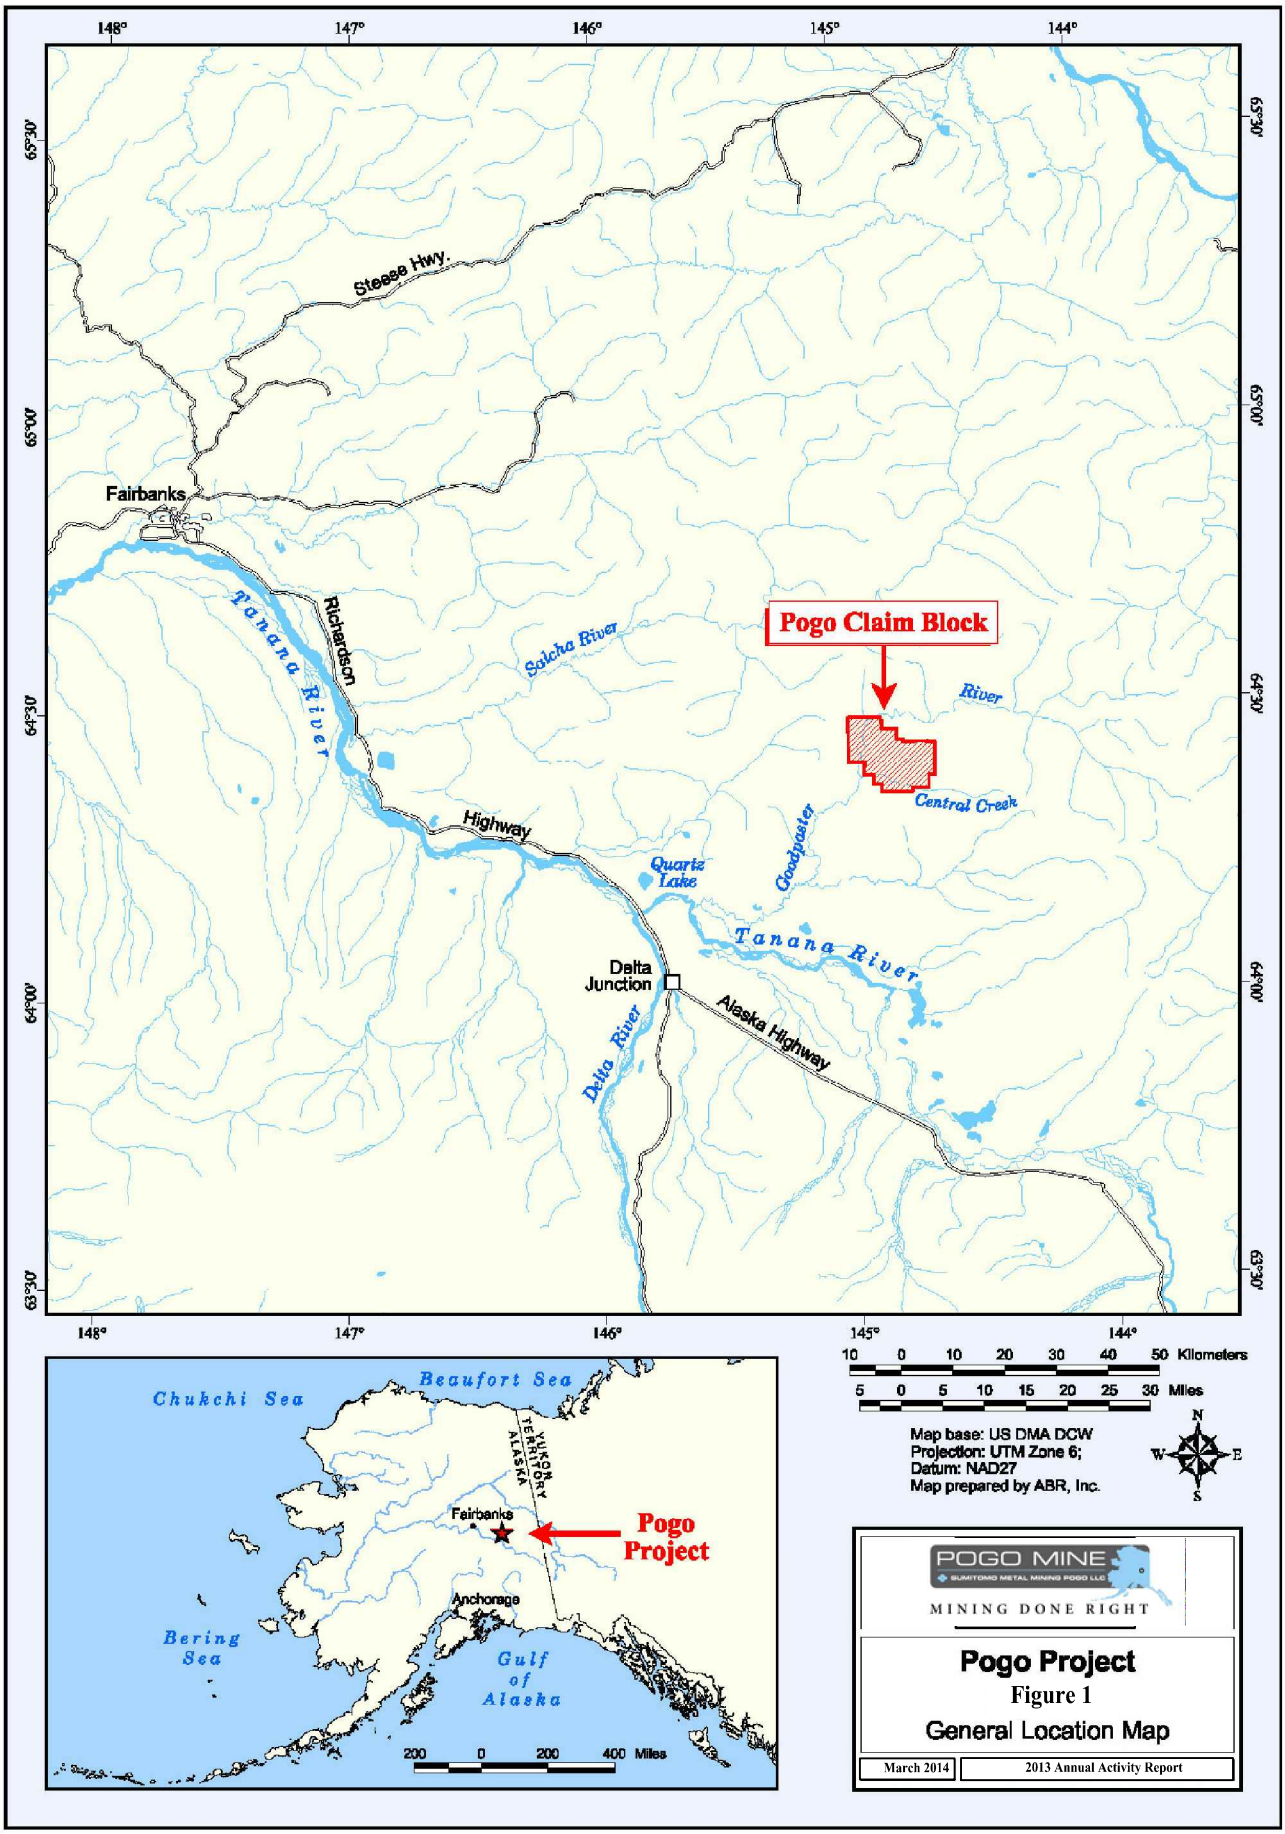
148°
147°
146°
145°
144°
65°30'
65°00'
64°30'
64°00'
63°30'
Steese Hwy.
Fairbanks
Tanana River
Richardson
Salcha River
Pogo Claim Block
River
Central Creek
Goodpaster
Highway
Quartz Lake
Tanana River
Delta Junction
Alaska Highway
Delta River
10 0 10 20 30 40 50 Kilometers
5 0 5 10 15 20 25 30 Miles
Map base: US DMA DCW
Projection: UTM Zone 6;
Datum: NAD27
Map prepared by ABR, Inc.
N
W
E
S
Chukchi Sea
Beaufort Sea
YUKON TERRITORY
ALASKA
Fairbanks
Pogo Project
Anchorage
Bering Sea
Gulf of Alaska
200 0 200 400 Miles
POGO MINE
SUMITOMO METAL MINING POGO LLC
MINING DONE RIGHT
Pogo Project
Figure 1
General Location Map
March 2014
2013 Annual Activity Report

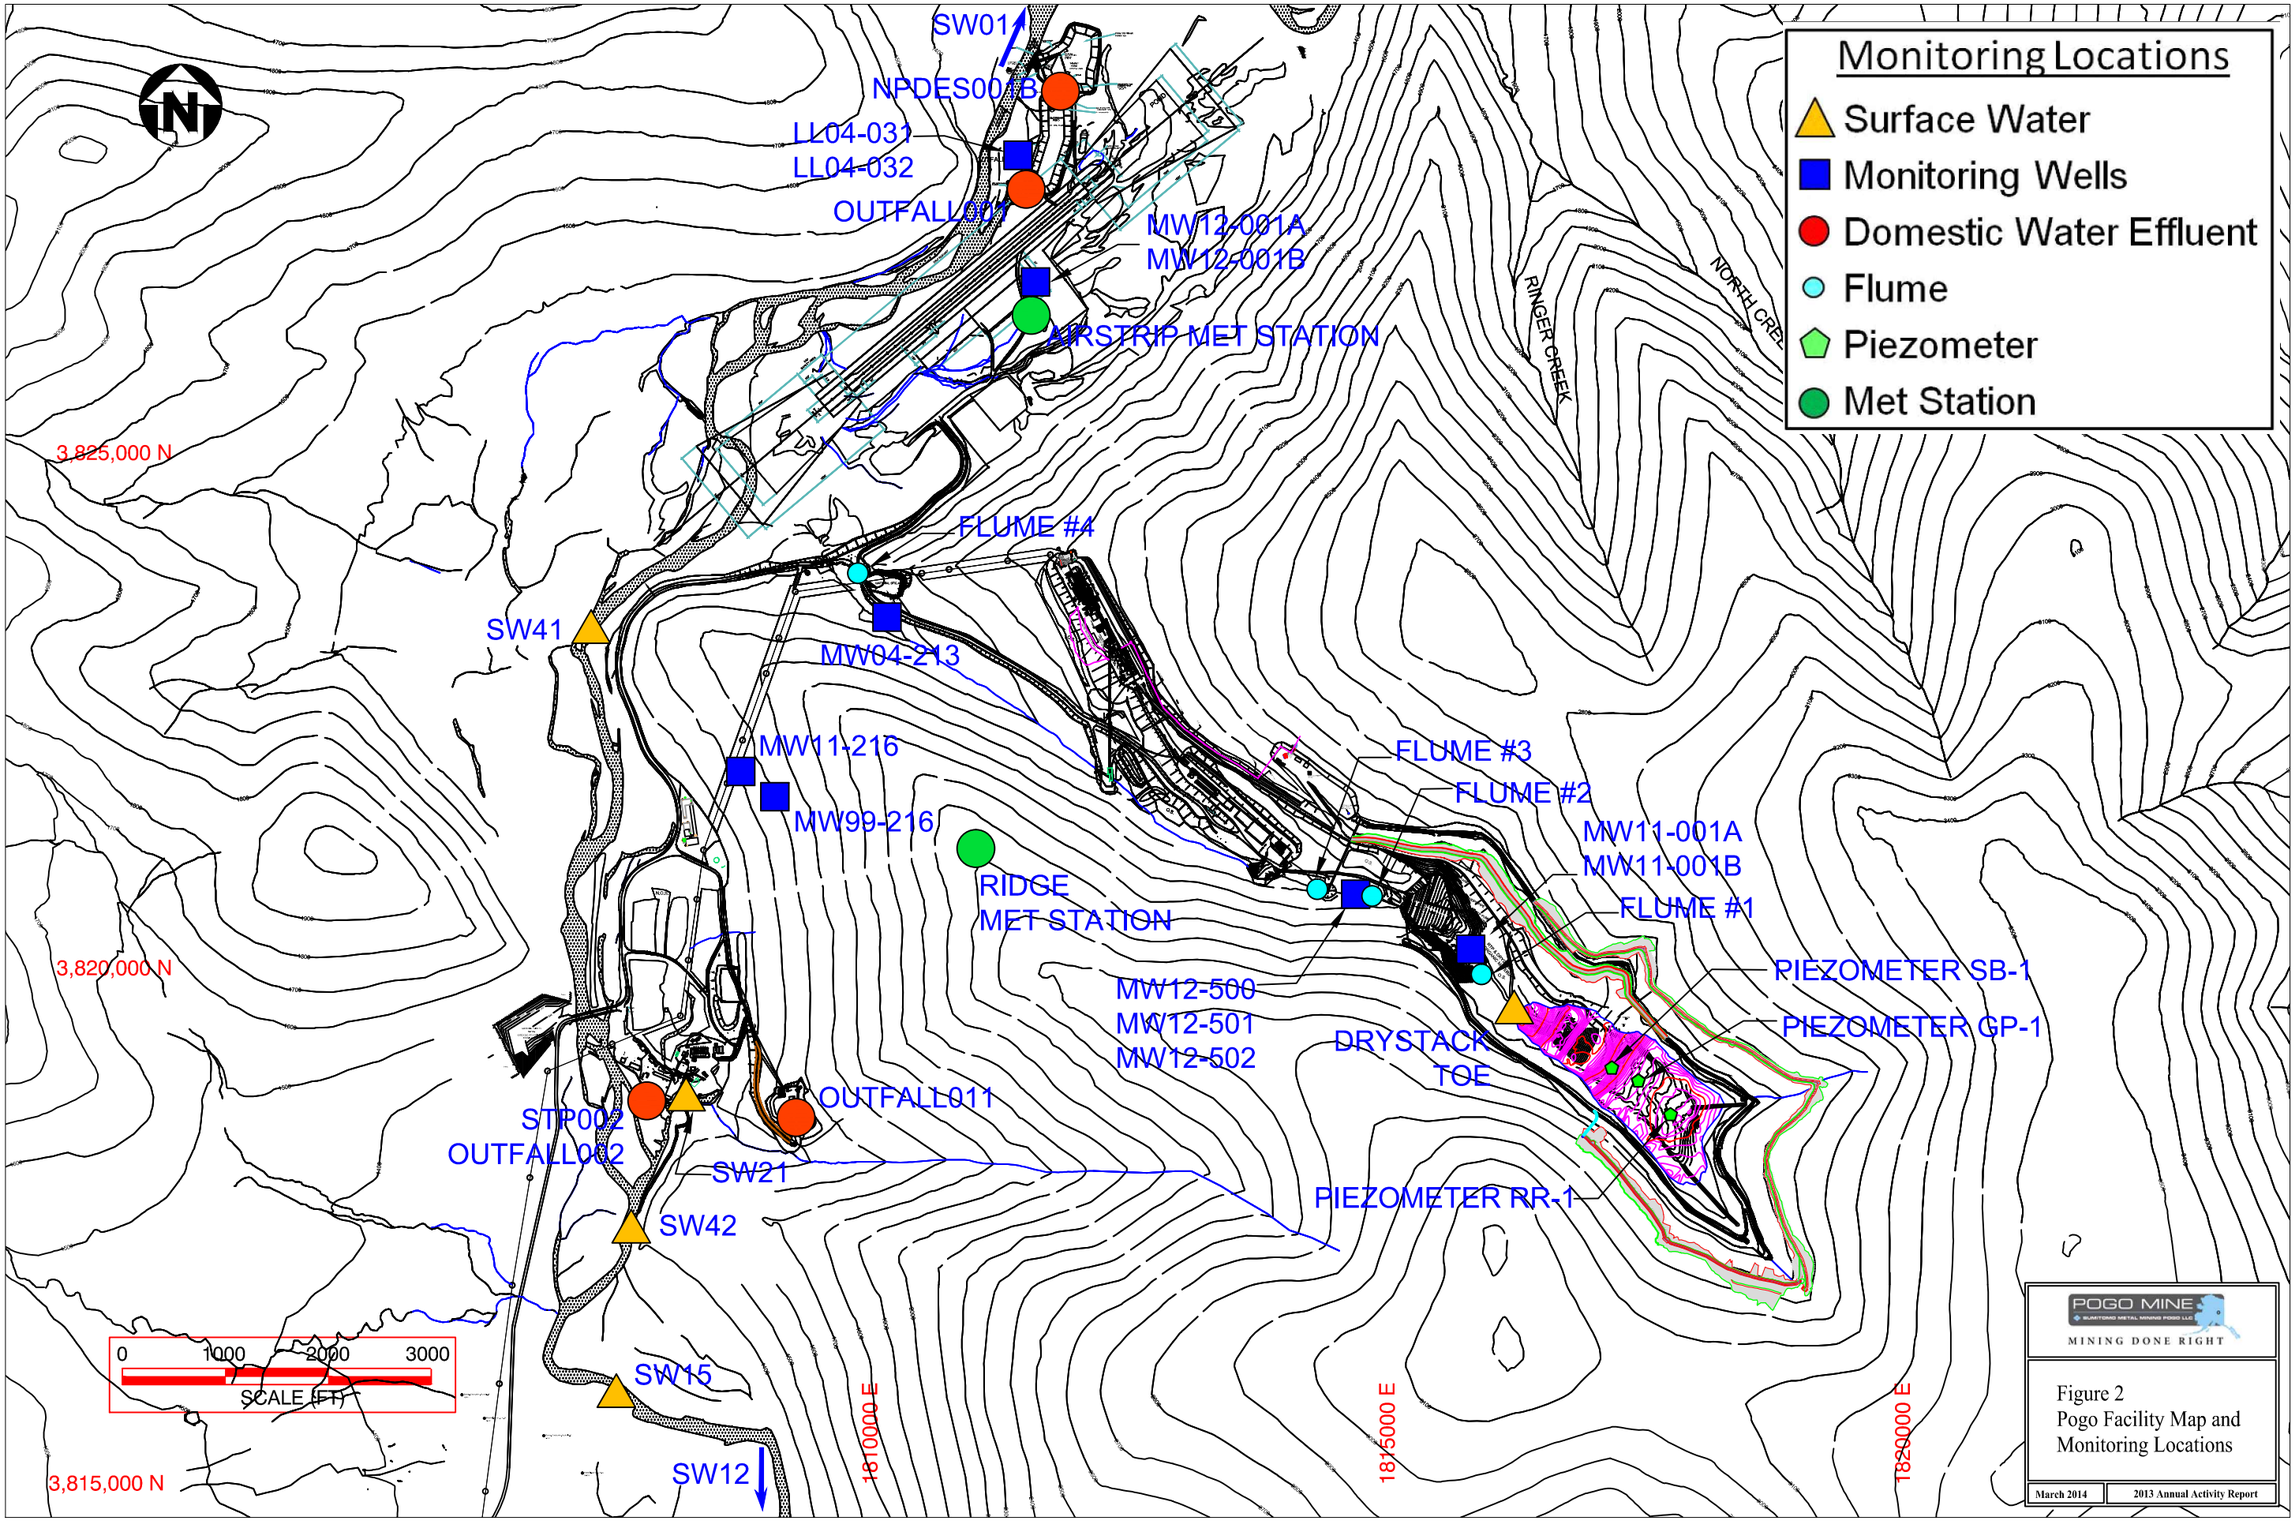
Monitoring Locations
Surface Water
Monitoring Wells
Domestic Water Effluent
Flume
Piezometer
Met Station
SW01
NPDES001B
LL04-031
LL04-032
OUTFALL001
MW12-001A
MW12-001B
AIRSTRIP MET STATION
RINGER CREEK
NORTH CREEK
3,825,000 N
FLUME #4
SW41
MW04-213
MW11-216
MW99-216
RIDGE
MET STATION
FLUME #3
FLUME #2
MW11-001A
MW11-001B
FLUME #1
PIEZOMETER SB-1
PIEZOMETER GP-1
MW12-500
MW12-501
MW12-502
DRYSTACK
TOE
PIEZOMETER RR-1
3,820,000 N
STP002
OUTFALL002
OUTFALL011
SW21
SW42
SW15
SW12
0
1000
2000
3000
SCALE (FT)
3,815,000 N
1810000 E
1815000 E
1820000 E
POGO MINE
MINING DONE RIGHT
Figure 2
Pogo Facility Map and
Monitoring Locations
March 2014
2013 Annual Activity Report

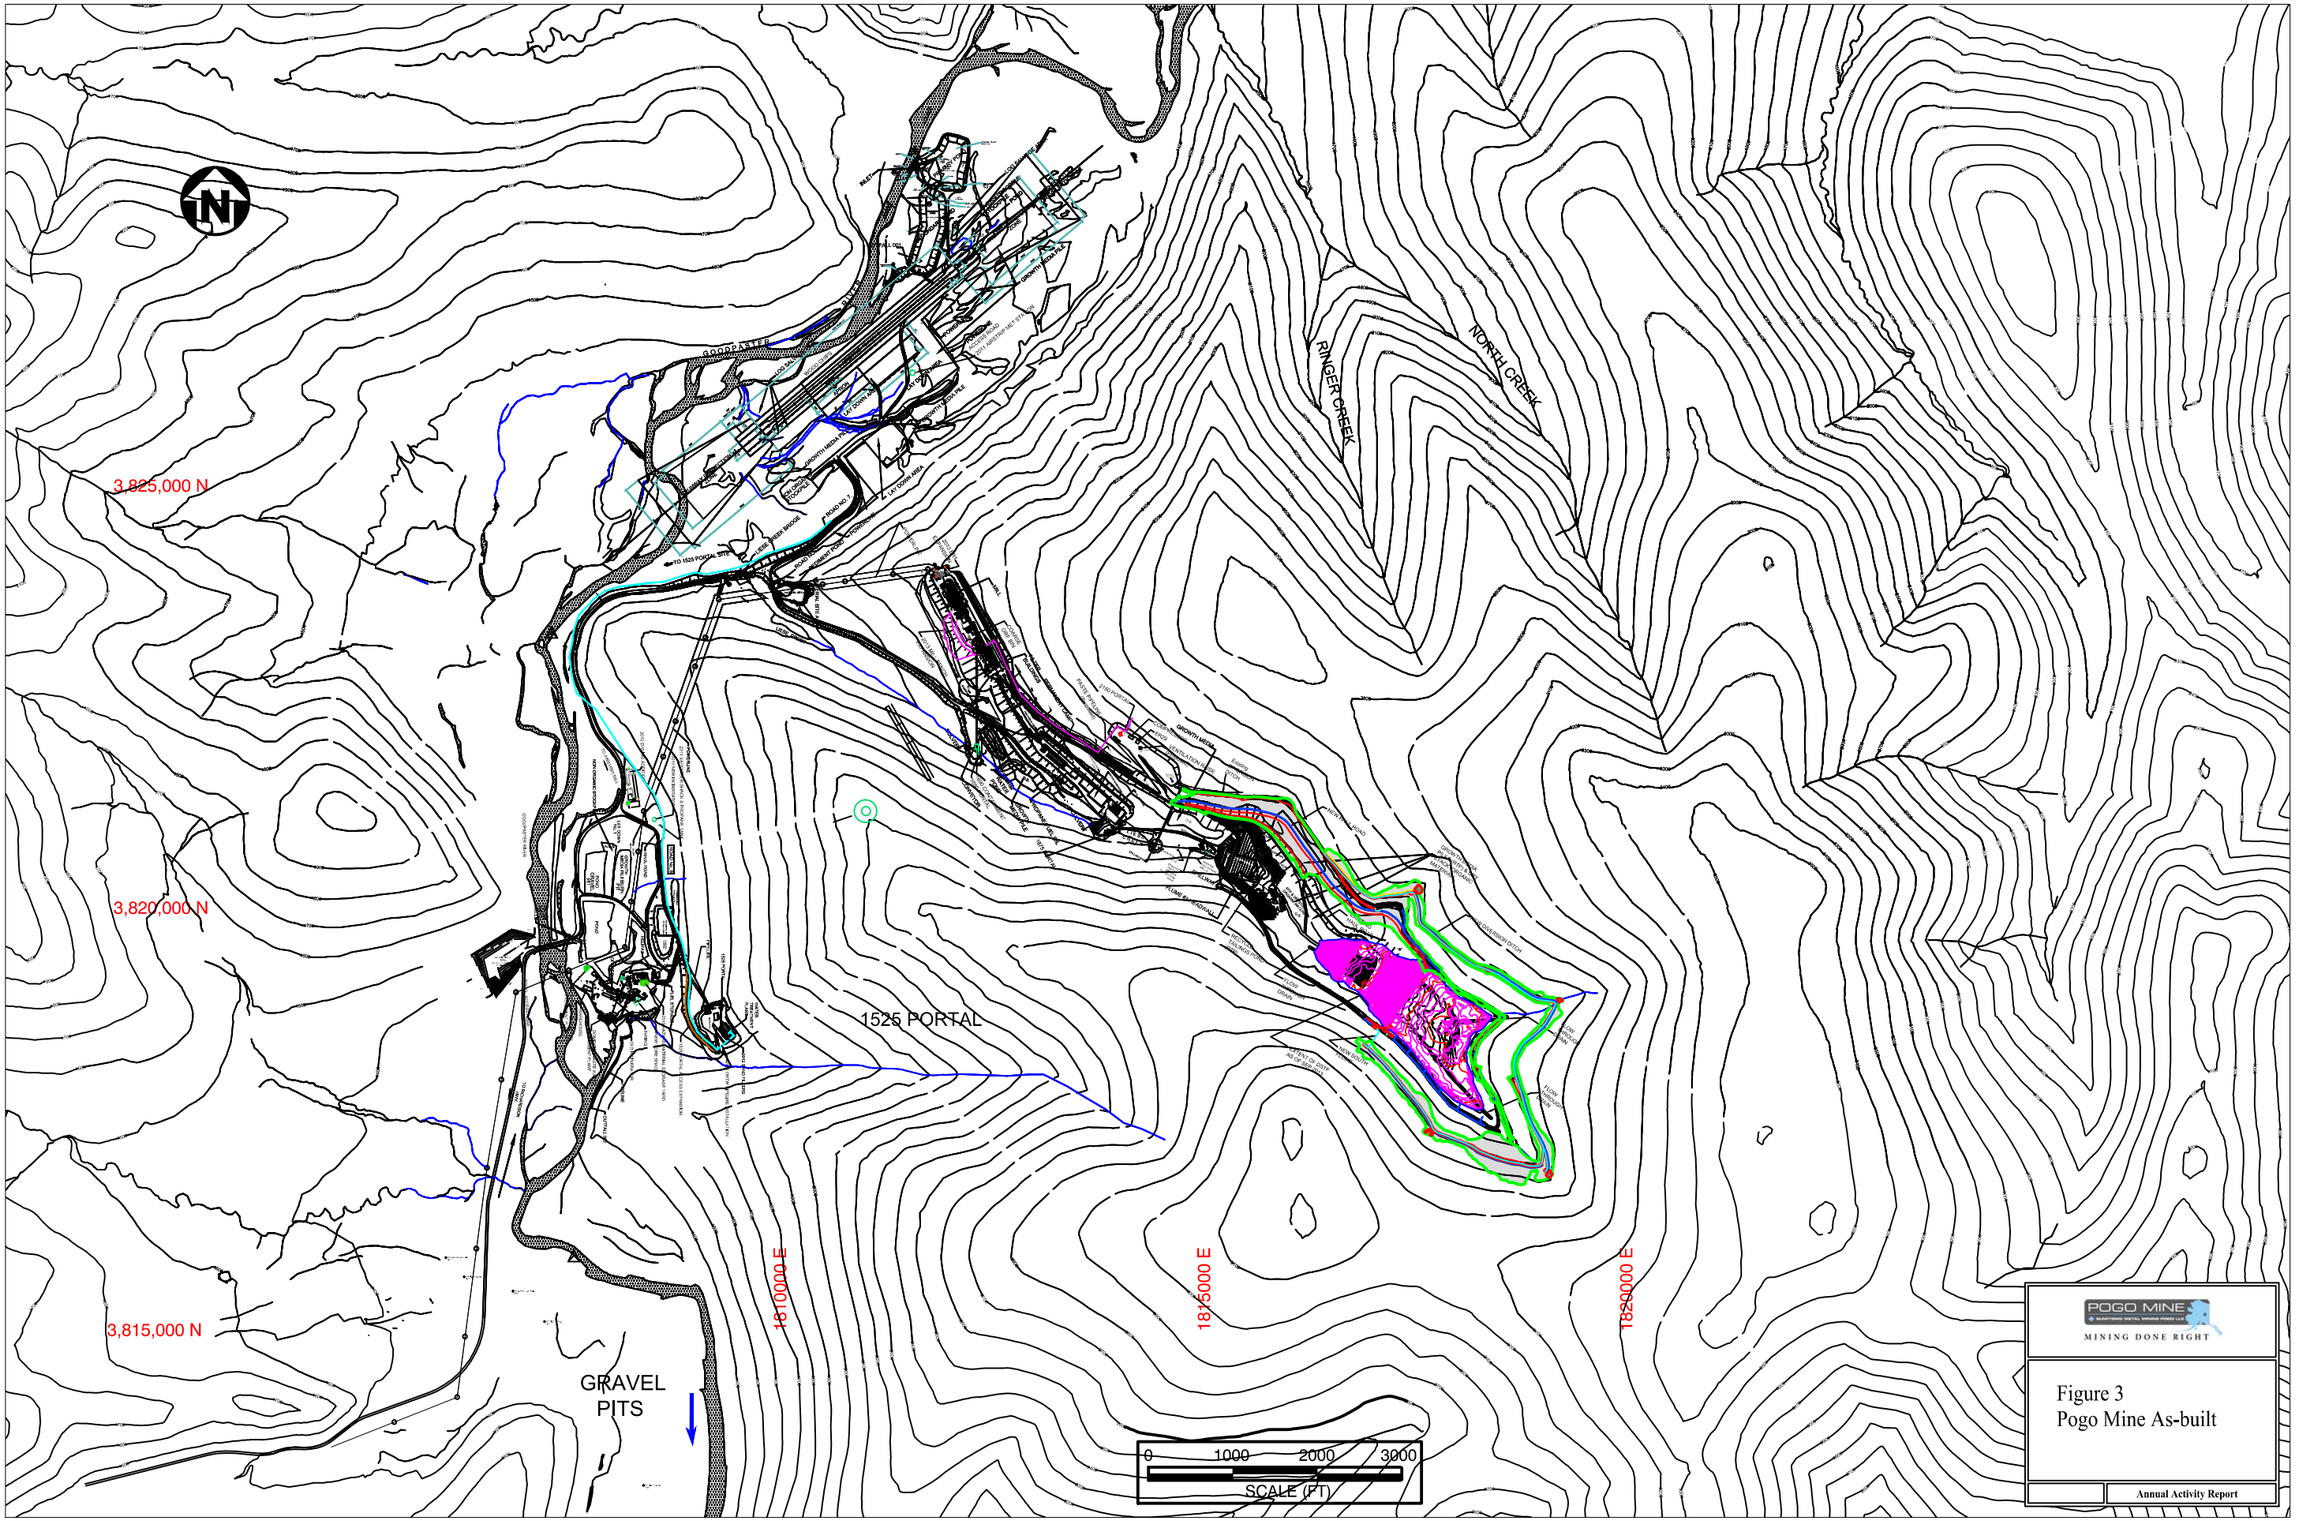
N
3,825,000 N
3,820,000 N
3,815,000 N
GOOSE ARTER
RINGER CREEK
NORTH CREEK
1525 PORTAL
GRAVEL PITS
1810000 E
1815000 E
1820000 E
0
1000
2000
3000
SCALE (FT)
POGO MINE
MINING DONE RIGHT
Figure 3
Pogo Mine As-built
Annual Activity Report

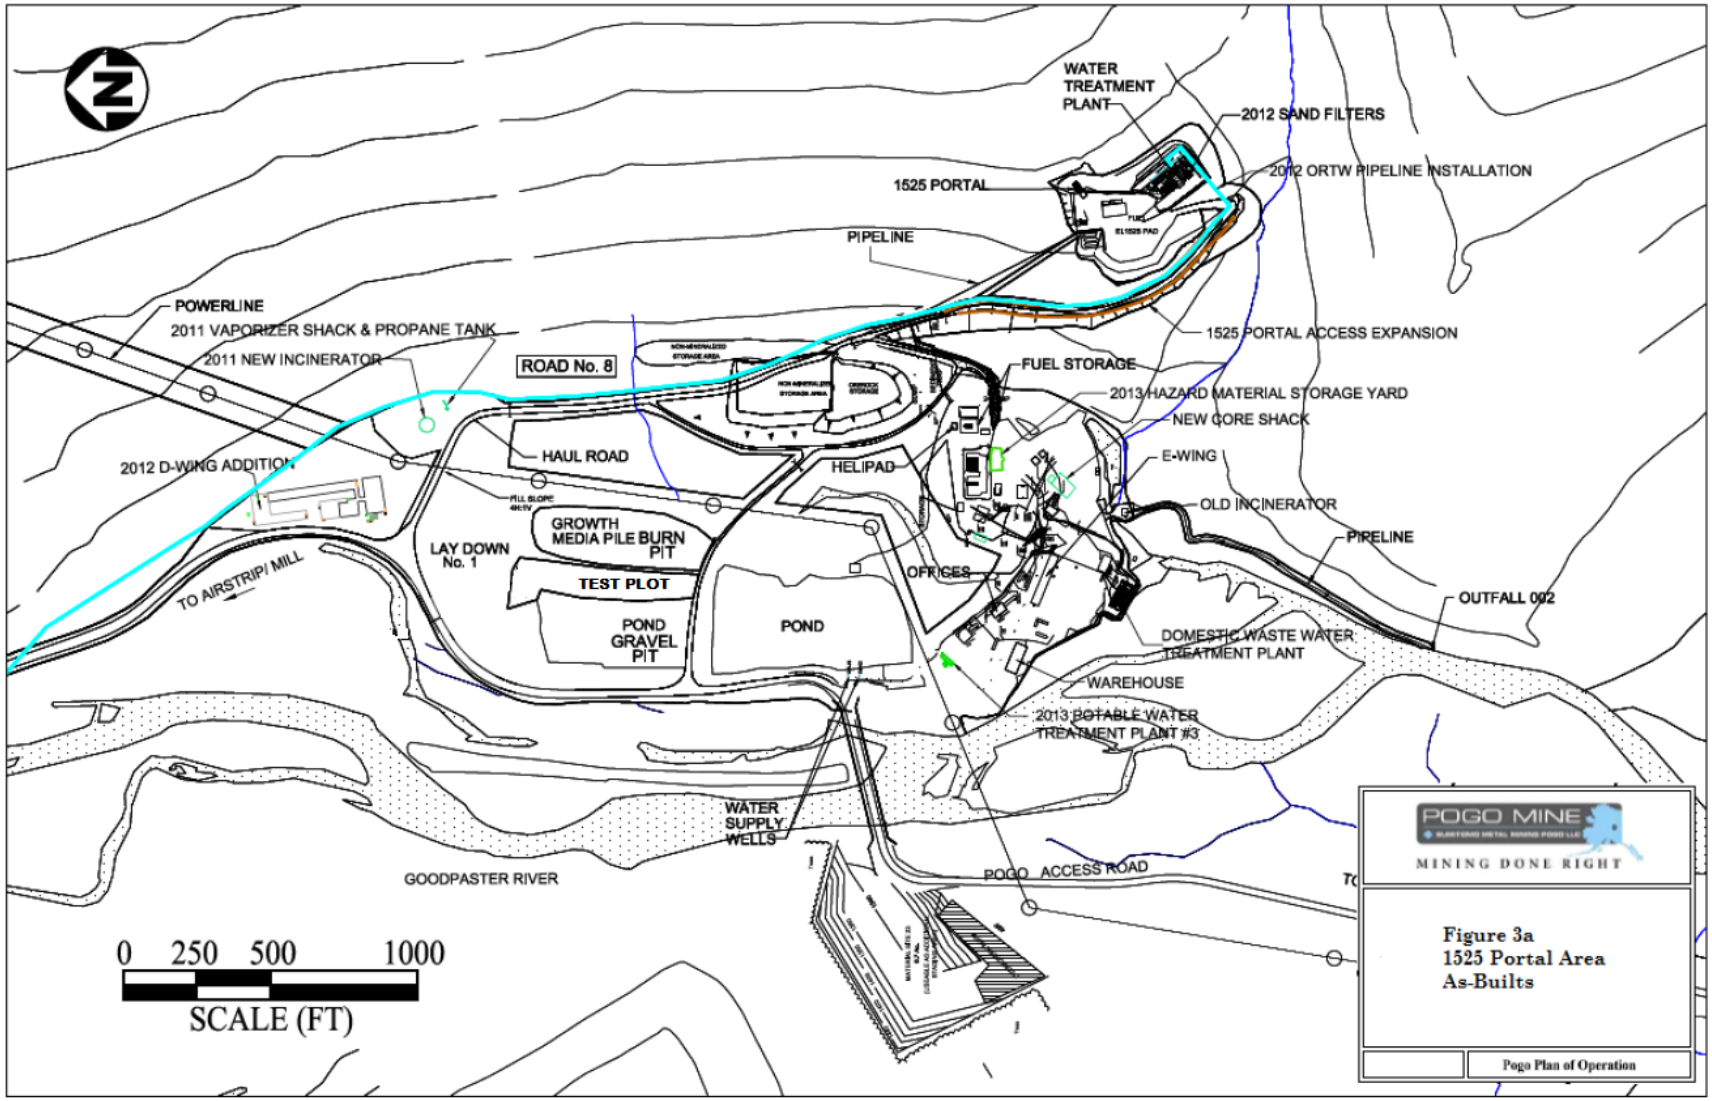
WATER TREATMENT PLANT
2012 SAND FILTERS
2012 ORTW PIPELINE INSTALLATION
1525 PORTAL
PIPELINE
POWERLINE
2011 VAPORIZER SHACK & PROPANE TANK
2011 NEW INCINERATOR
ROAD No. 8
1525 PORTAL ACCESS EXPANSION
FUEL STORAGE
2013 HAZARD MATERIAL STORAGE YARD
NEW CORE SHACK
2012 D-WING ADDITION
HAUL ROAD
HELIPAD
E-WING
OLD INCINERATOR
PIPELINE
GROWTH MEDIA PILE BURN PIT
LAY DOWN No. 1
TEST PLOT
OFFICES
OUTFALL 002
TO AIRSTRIP/ MILL
POND GRAVEL PIT
POND
DOMESTIC WASTE WATER TREATMENT PLANT
WAREHOUSE
2013 POTABLE WATER TREATMENT PLANT #3
WATER SUPPLY WELLS
GOODPASTER RIVER
POGO ACCESS ROAD
0 250 500 1000
SCALE (FT)
POGO MINE
MINING DONE RIGHT
Figure 3a
1525 Portal Area
As-Builts
Pogo Plan of Operation

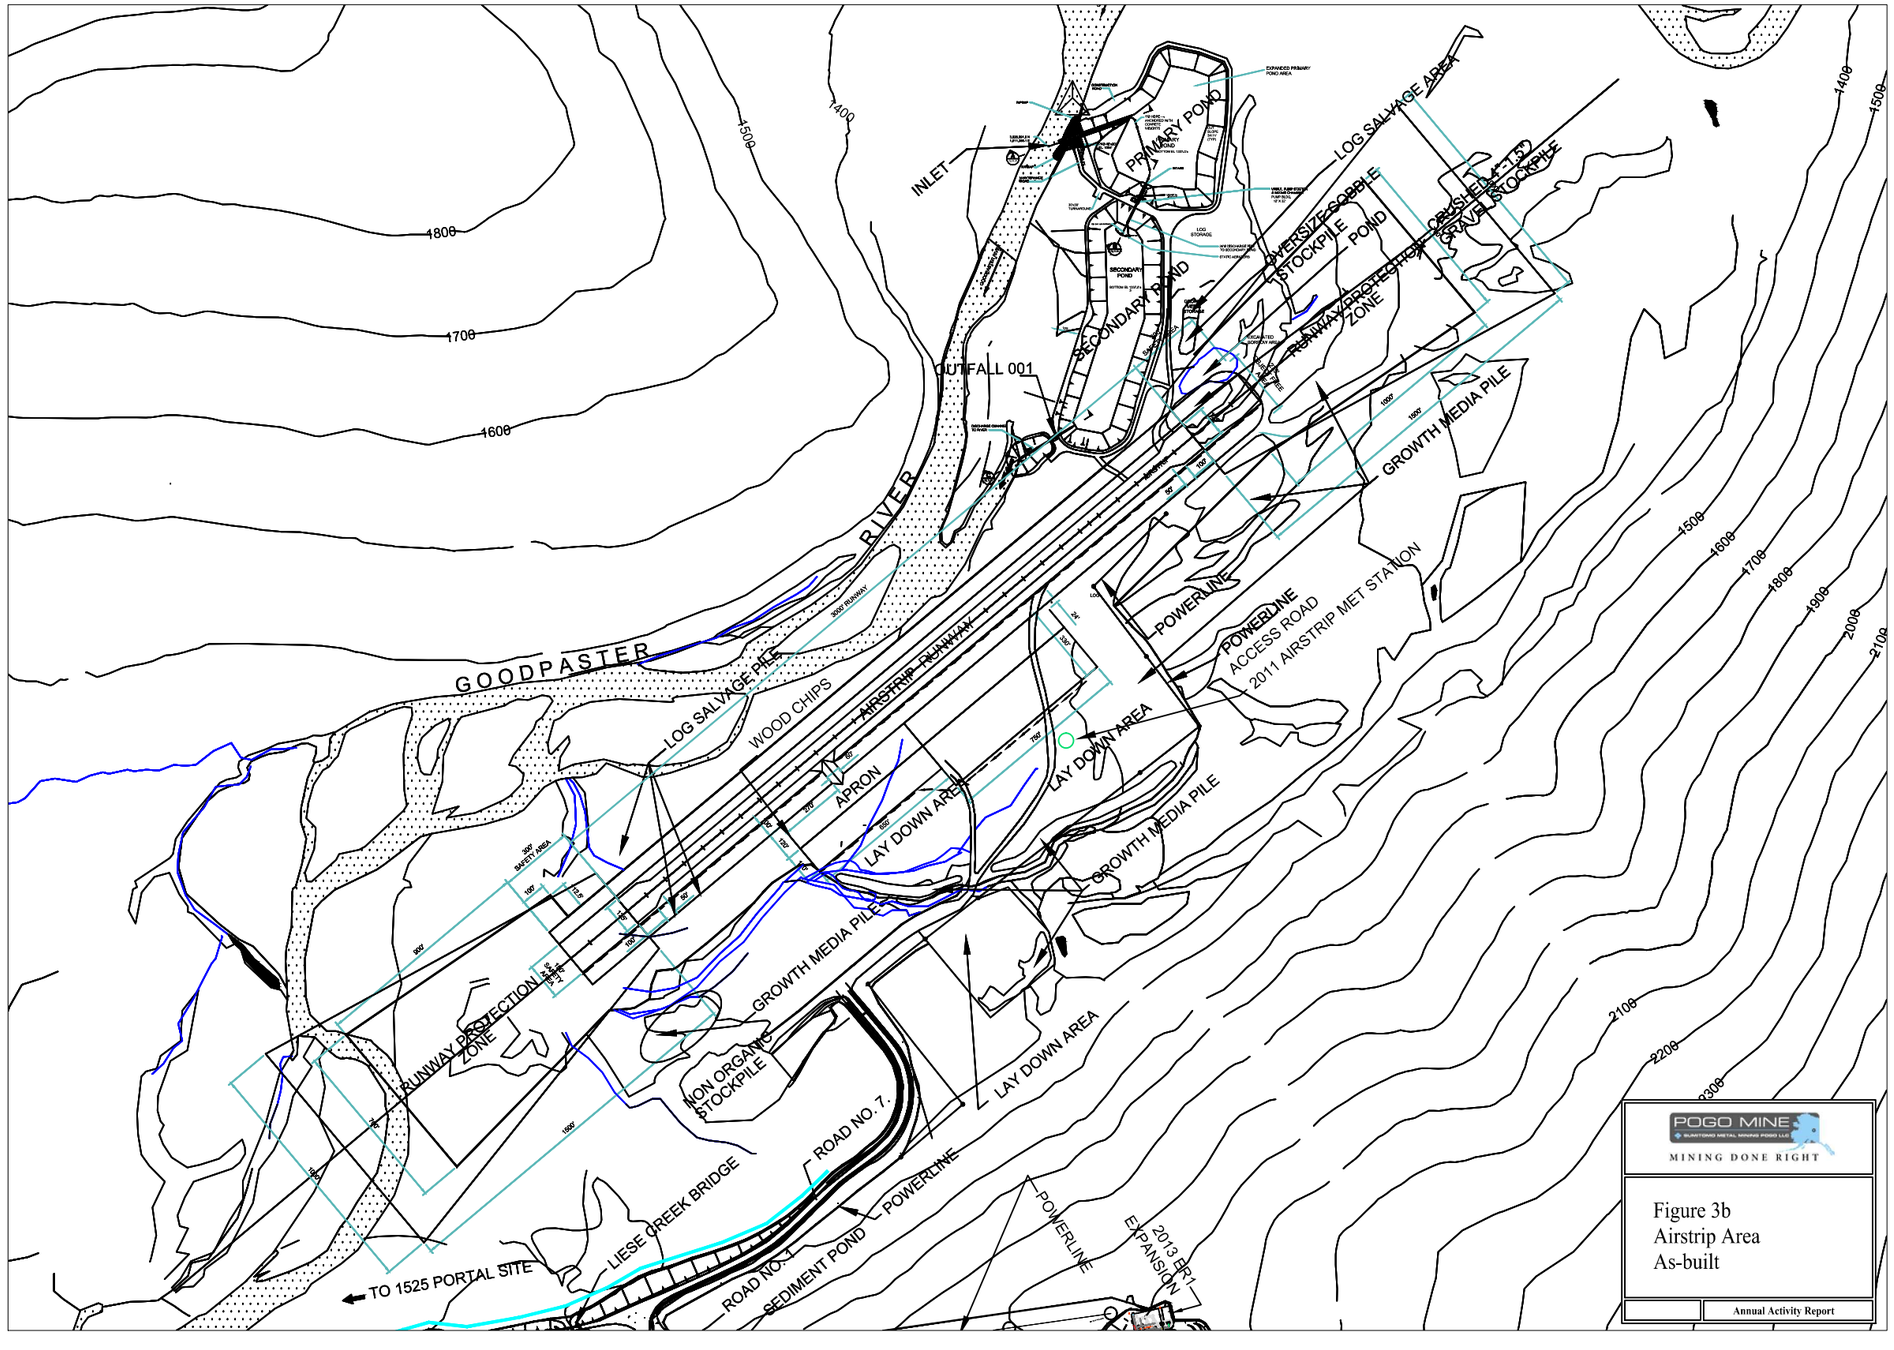
INLET
PRIMARY POND
SECONDARY POND
OUTFALL 001
LOG SALVAGE AREA
OVERSIZE/SCRAP STOCKPILE
POND
RUNWAY PROTECTION ZONE
CRUSHED (+1.5") GRAVEL STOCKPILE
GROWTH MEDIA PILE
POWERLINE
ACCESS ROAD
2011 AIRSTRIP MET STATION
GOODPASTER
RIVER
AIRSTRIP/RUNWAY
WOOD CHIPS
APRON
LAY DOWN AREA
NON ORGANIC STOCKPILE
ROAD NO. 7
ROAD NO. 1
SEDIMENT POND
LIESE CREEK BRIDGE
TO 1525 PORTAL SITE
2013 ER1 EXPANSION
1400
1500
1600
1700
1800
1900
2000
2100
2200
POGO MINE
MINING DONE RIGHT
Figure 3b
Airstrip Area
As-built
Annual Activity Report

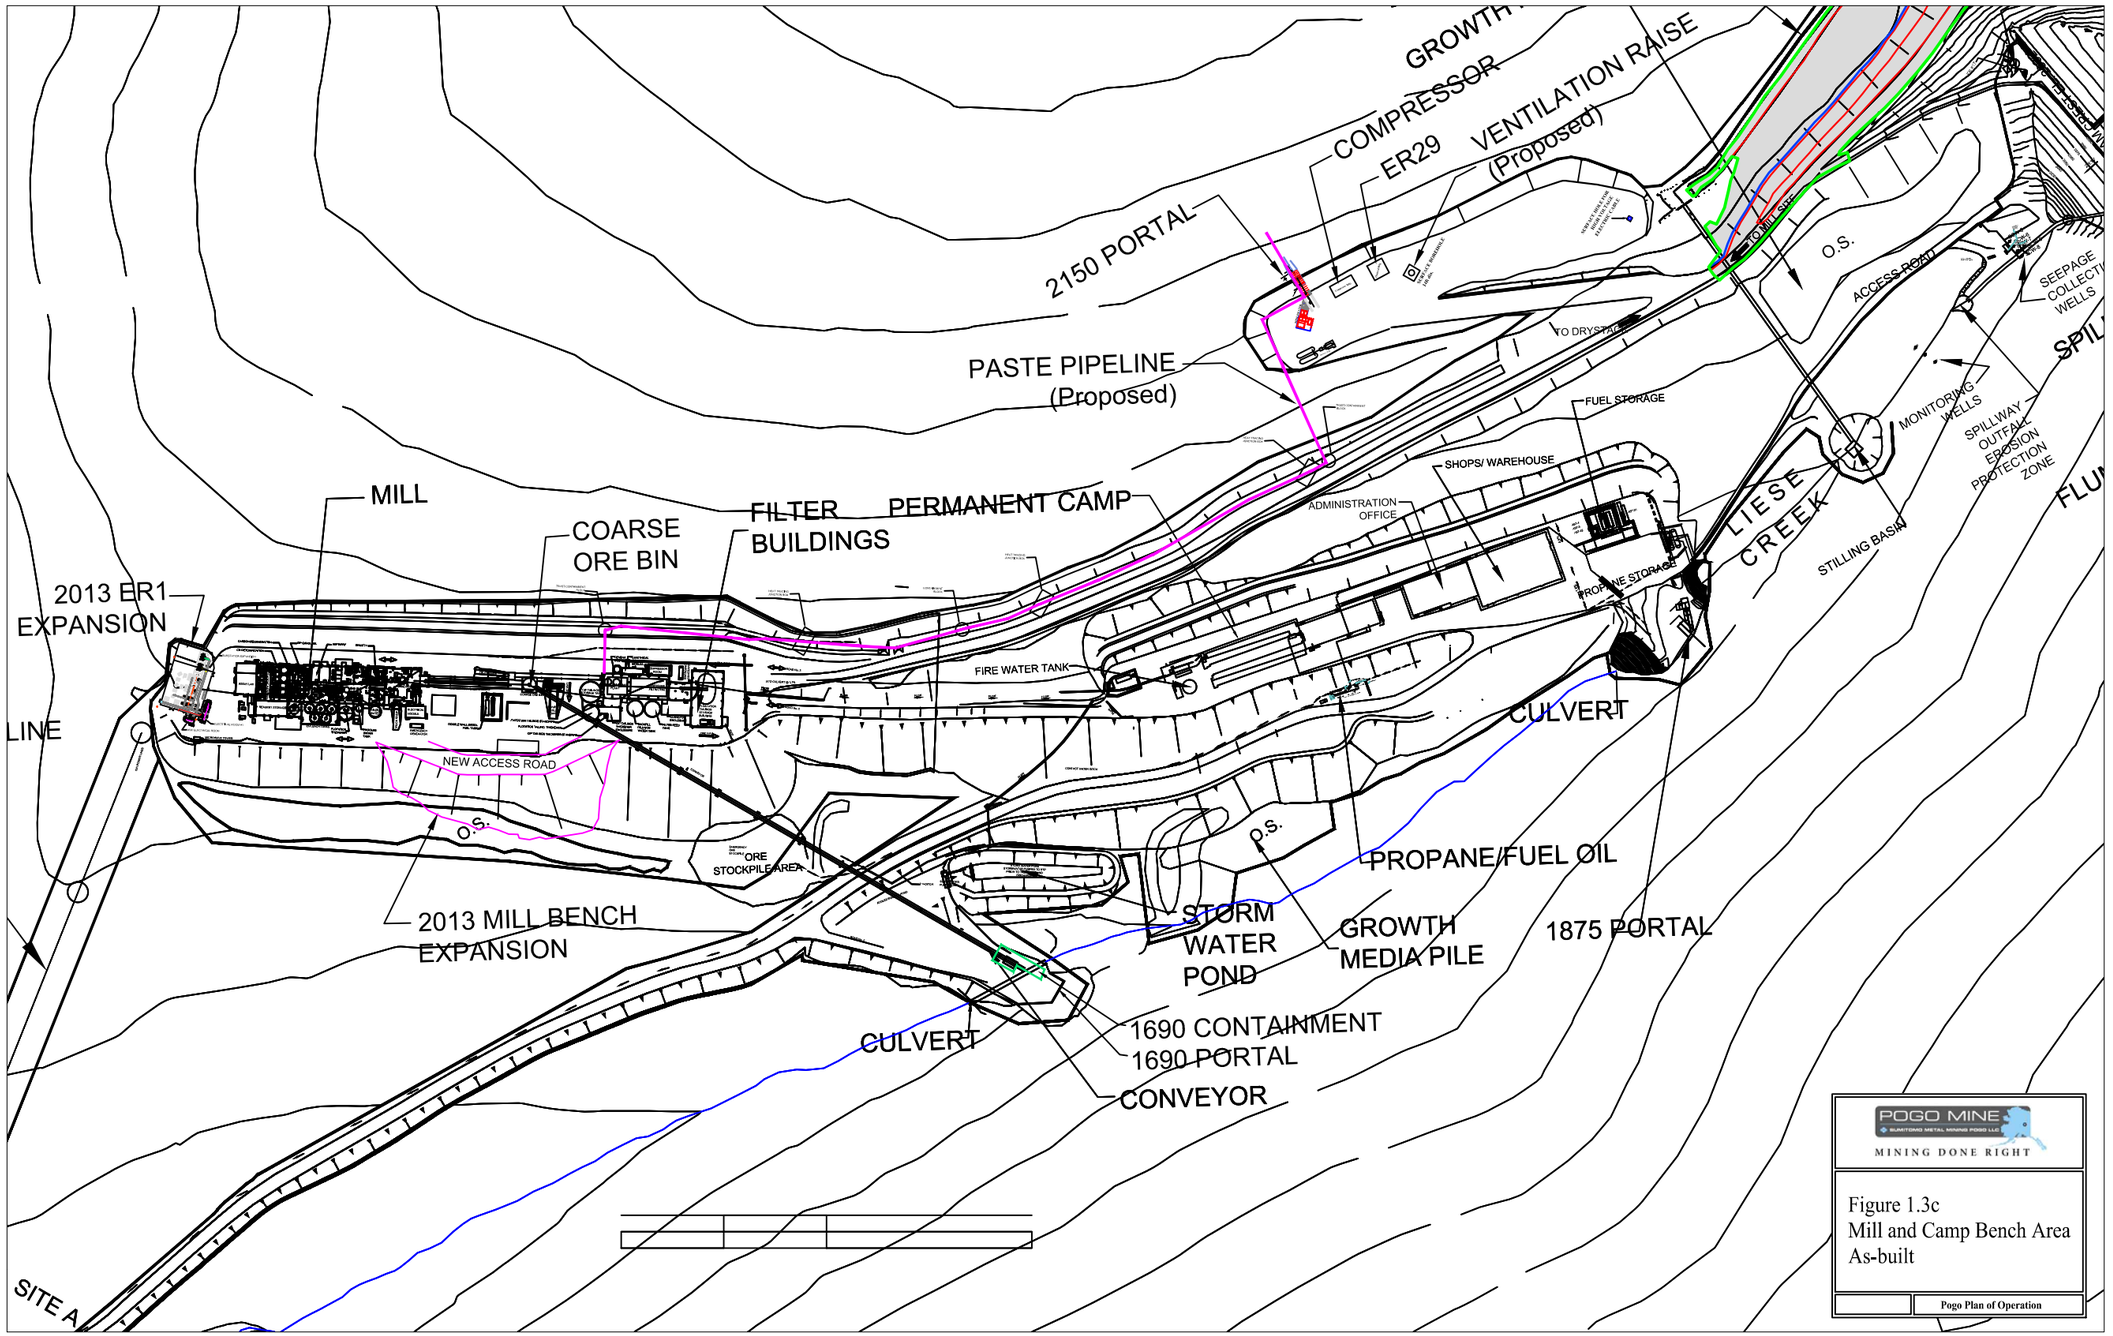

POGO MINE
SUMITOMO METAL MINING POGO LLC
MINING DONE RIGHT

Figure 1.3c
Mill and Camp Bench Area
As-built

Pogo Plan of Operation