APPLICATION FOR SALMON SET NET LEASE
George E. Tibbetts
ADL 230438

Proposed Lease is for two set net tracts, nets are 150 feet each in length, located in Bristol Bay on the east bank of the Egedik River, approximately ½ mile southwest of the Village of Egegik and seaward of U.S. Survey No. 4900, within protracted Section 1, Township 23 South, Range 50 West, Seward Meridian.

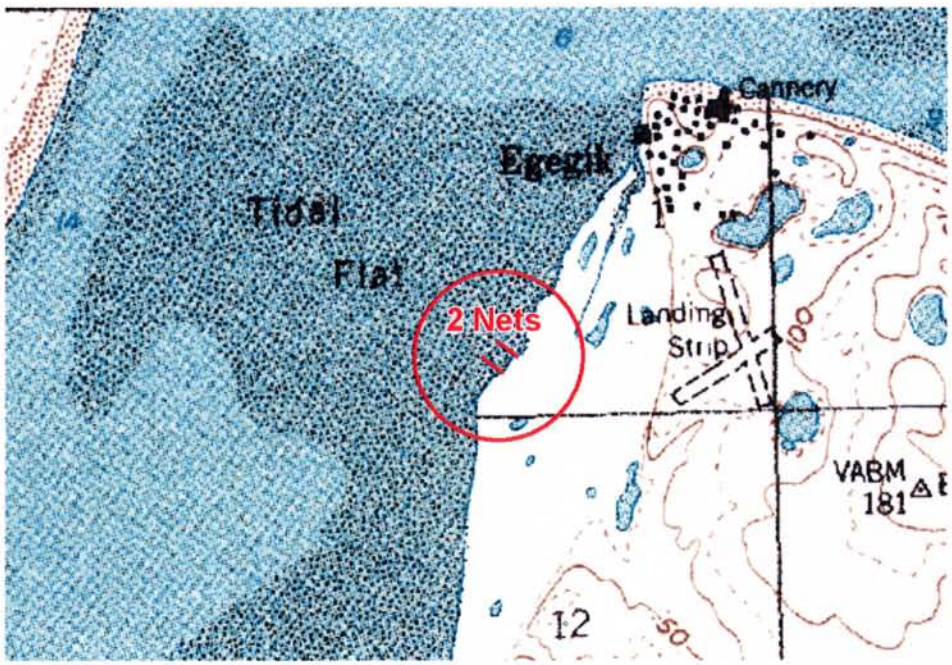

Vicinity Map

APPROXIMATE GEOGRAPHIC POSITION AT THE WITNESS CORNER TO CORNER NO. 1, A MEANDER CORNER US SURVEY NO. 5300
LATITUDE 58° 13.7' NORTH
LONGITUDE 157° 23.7' WEST
EST. 1975 BY BLM

USS NO. 91

USS NO. 5300
UPLAND OWNERS

Elizabeth Cherikoff Vance
548 2nd St., Grist Apt. 3
Fairbanks, AK. 99701

Steven Michael Cherikoff
231 East 46th No. 3
Anchorage, AK. 99503

Ben Lee Cherikoff
701 W. 36th, Suite B
Anchorage, AK. 99503

Cody Warren Cherikoff
Box 4
Egegik, AK. 99579

Judy Ann Cherikoff
8017 Dogwood Lane
Juneau, AK. 99801

CONTOUR LINE ELEV. 50'
UNNAMED DRAINAGE
COR. 5
WC MC 1
MHT
MLT
SFP-367
TR-A
TR-B
TR-C
TR-D
TR-E
TR-F
TR-G
34 | 35
3 | 2
T 22 S
T 23 S
USS NO. 5305
UPLAND OWNER
Mary Bondurant
P.O. Box 1138
Kenai, AK. 99611
2
50' ELEV. CONTOUR LINE
3 | 2
10 | 11

EGEGIK RIVER

35 | 36
2 | 1

TIDAL FLAT

2 NETS
ADL 230438

TR-H
TR-I
TR-J
TR-K
TR-L
TR-M
TR-N
TR-O
TR-P
TR-Q
SFP-341
NO RESTRICTION
STATE LANDS

EGEGIK

USS NO. 4900
UPLAND OWNER
Egegik Village Corp.

EGEGIK AIRFIELD
BASE BEARING
AZ 270°44'28" 1863.0'
AZ 282° 51' 32" 2243.5'
2475.0'
AZ 234° 51' 30"
AZ 223° 56' 07"
1729.7'
1440.90'
1440.90'
36 | 31
1 | 6
6 | 5
12 | 7
R 50 W
R 49 W

REFERENCE POINT – SURVEY MONUMENT

FOUND 1 1/2" DIAMETER COPPERWELD MONUMENT
S.W. COR. LOT 12, BLK. 12, TRACT A", USS 4900

APPROXIMATE GEOGRAPHIC POSITION
LATITUDE 58°12'24" NORTH
LONGITUDE 157° 22' 26.5" WEST

ESTABLISHED BY INVERSING
TO W C M C 1, TRACT "A", USS 4900
USING USS 4900 (B.L.M.) RECORD DATA (1970)

MAG. DEC. = 20° 30'
N

USGS Quadrangle NAKNEK A-5 1968
1:63,360 VICINITY MAP 1 INCH = 1 MILE

TRACT	MONUMENT TIE FROM WCMC 1 USS 5300 TO SHOREWARD NET ANCHOR	
A	AZ 209° 57' 00"	1658.4'
B	AZ 209° 36' 50"	1872.7'
C	AZ 209° 02' 15"	2312.3'
D	AZ 208° 42' 30"	2612.0'
E	AZ 208° 06' 10"	3263.6'
F	AZ 207° 16' 37"	3730.3'
G	AZ 206° 32' 35"	4046.4'

I (WE) HAVE REVIEWED SHORE FISHERY DIAGRAM NO. 843 AND BELIEVE IT TO BE AN ACCURATE DEPICTION OF MY (OUR) SHORE FISHERY TRACT(S)

TRACT	ADL	NAME, ADDRESS & SIGNATURE
A&B	204156	Vera Abaiomo 7800 DEBARR SP 324 Anchorage, Ak. 99504 Vera Abaiomo
C&D	221953	Shirley Kelly P.O.A. To Gary Nelson Box 134 Egegik, Ak. 99579 Gary Nelson
E&J	221954	Steven Furman P.O.A. To Gary Nelson Box 59 Egegik, Ak. 99579 Gary Nelson
G	223676	Dona L. Bendel 13771 Vetus Way Anchorage, Ak. 99515 Dona L. Bendel
F	221943	Mathew Rowley P.O.A. To Gary Nelson 1133 M Court Anchorage, Ak. 99501 Gary Nelson
H&I	221737	Carol Chmiel P.O.A. To Gary Nelson Box 3 Egegik, Ak. 99579 Gary Nelson
K&L	221889	Lucy Goode P.O.A. To Gary Nelson Box 209 Egegik, Ak. 99579 Gary Nelson

NOTES:
1. THIS IS A LEASE DOCUMENT COMPILED BY P&R LAND SURVEYING, SR BOX 550 ANCHOR PT., AK 99556 FROM INFORMATION PROVIDED BY THE APPLICANT.
2. THE STATE OF ALASKA ASSUMES NO RESPONSIBILITY FOR THE ACCURACY OF THE LOCATION OF THE TRACT(S).
3. THIS DIAGRAM WAS COMPILED FROM AN AS-BUILT SURVEY DONE BY P&R LAND SURVEYING, SR BOX 550 ANCHOR PT., AK. 99556.
4. PUBLIC RIGHT-OF-WAY: THE LESSOR HEREBY SPECIFICALLY RESERVES TO THE PUBLIC A RIGHT-OF-WAY ACROSS THE PARCEL FOR ACCESS TO NAVIGABLE WATERS AND OTHER TIDE AND SUBMERSED LANDS.
5. TRACT F IS A REPLAT OF TRACT B SFDI NO. 1024.

0 250' 500' 1000' 1500' 2000'

DATE OF SURVEY	NAME OF SURVEYOR
Beginning 6/20/86 Ending 6/20/86	Pat Marquis 4374-S

STATE OF ALASKA
DEPARTMENT OF NATURAL RESOURCES

SHORE FISHERY DIAGRAM NO. 1143
LOCATED IN PROTRACTED
SECTION 35, T. 22 S., R. 50 W.,
SEC. 1,2,&12 T. 23 S., R. 50 W., S.M., AK.

DRAWN BY	APPROVAL RECOMMENDED
G.N. Date: 11/86	Date
SCALE: 1" = 500'	CHECKED: / FILE NO SFDI-1143

APPLICATION FOR ADL 230438
SFDI-1143